

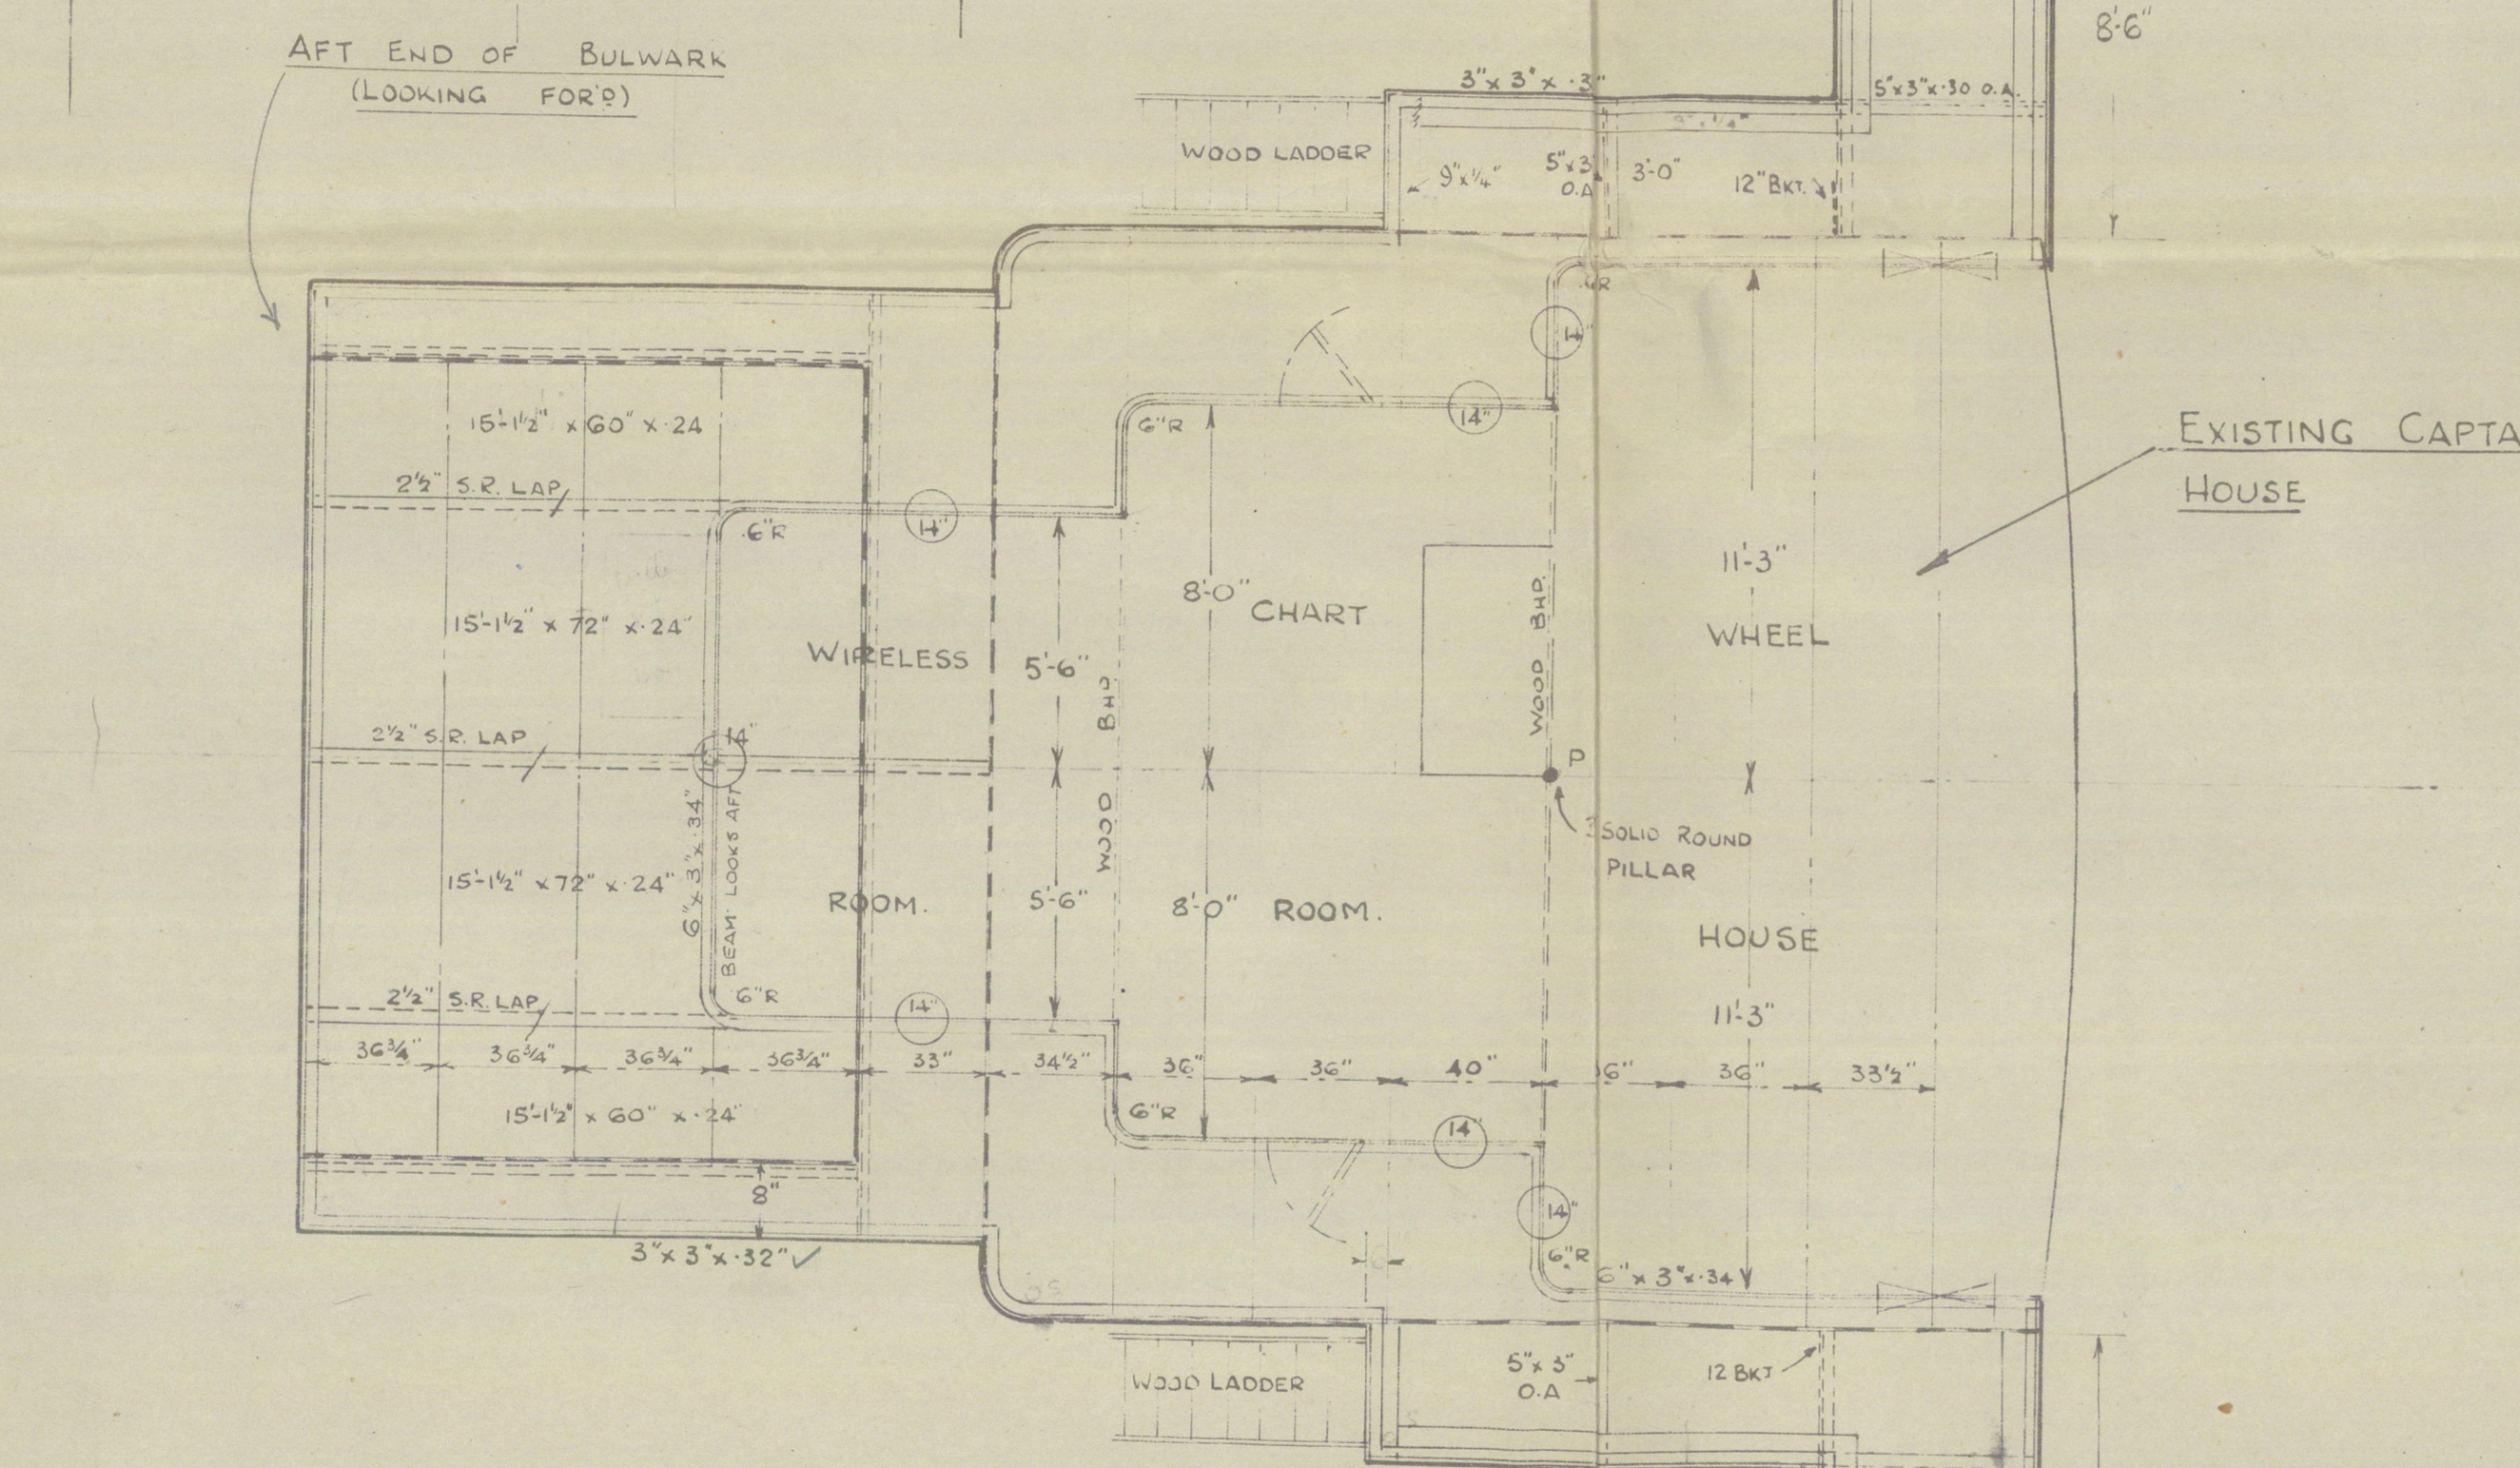




ELEVATION PORT SIDE OF WHEELHOUSE  
LOOKING TO PORT

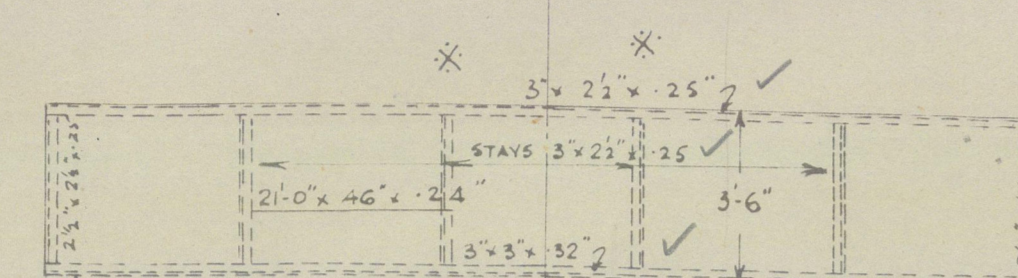


PLAN VIEW ON TOP OF CAPTAIN'S HOUSE  
DECK SHEATHED WITH 5" x 25" WOOD

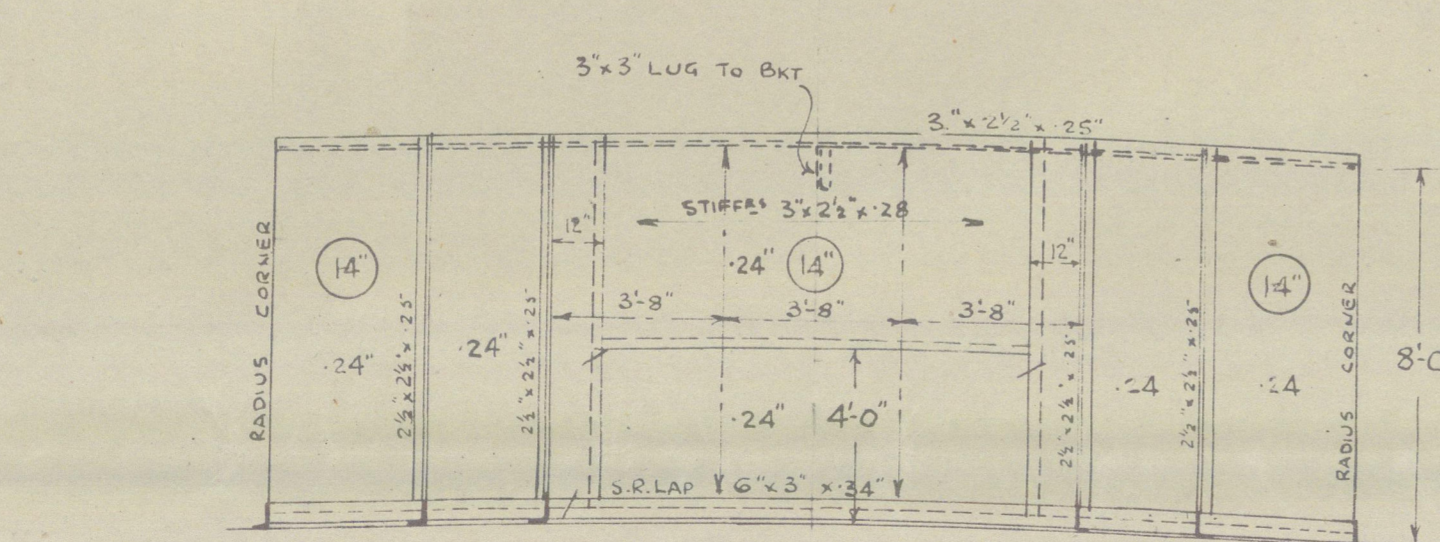


STAYS MARKED \* KNEED  
& WELDED TO DECK

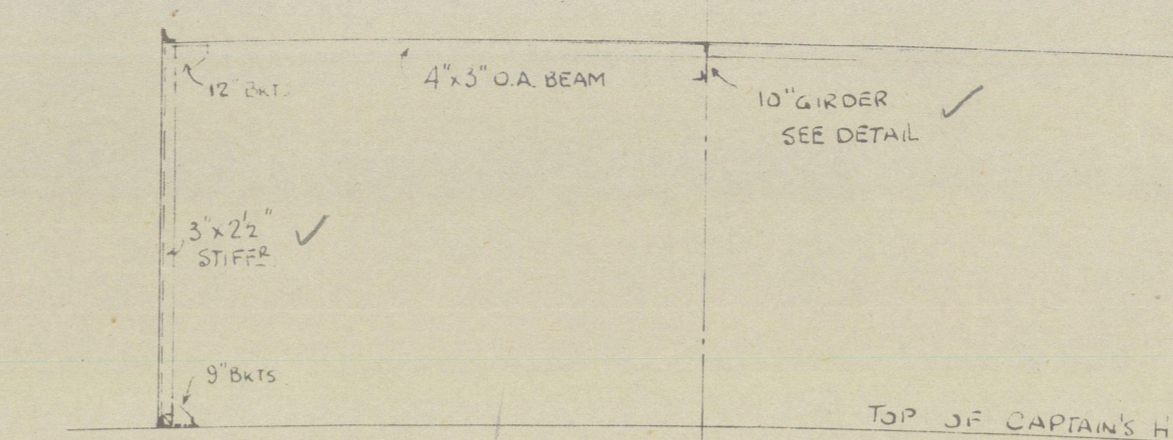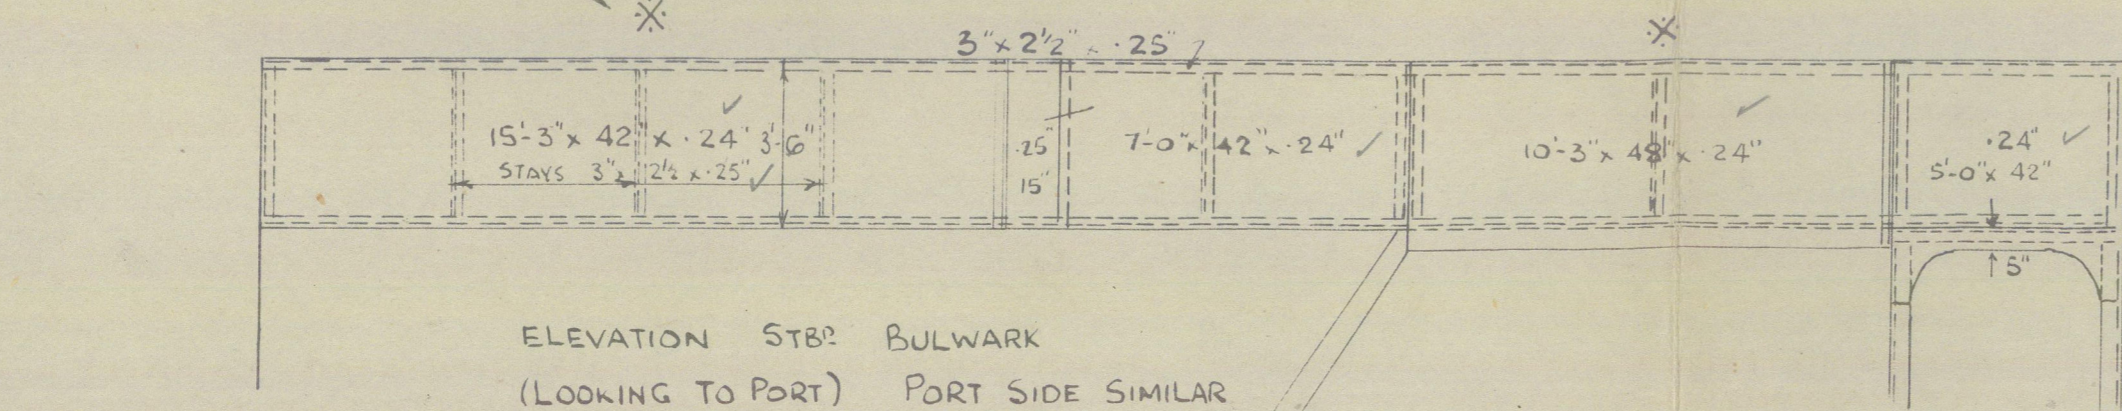

SECTION THREE WHEELHOUSE  
(LOOKING AFT)

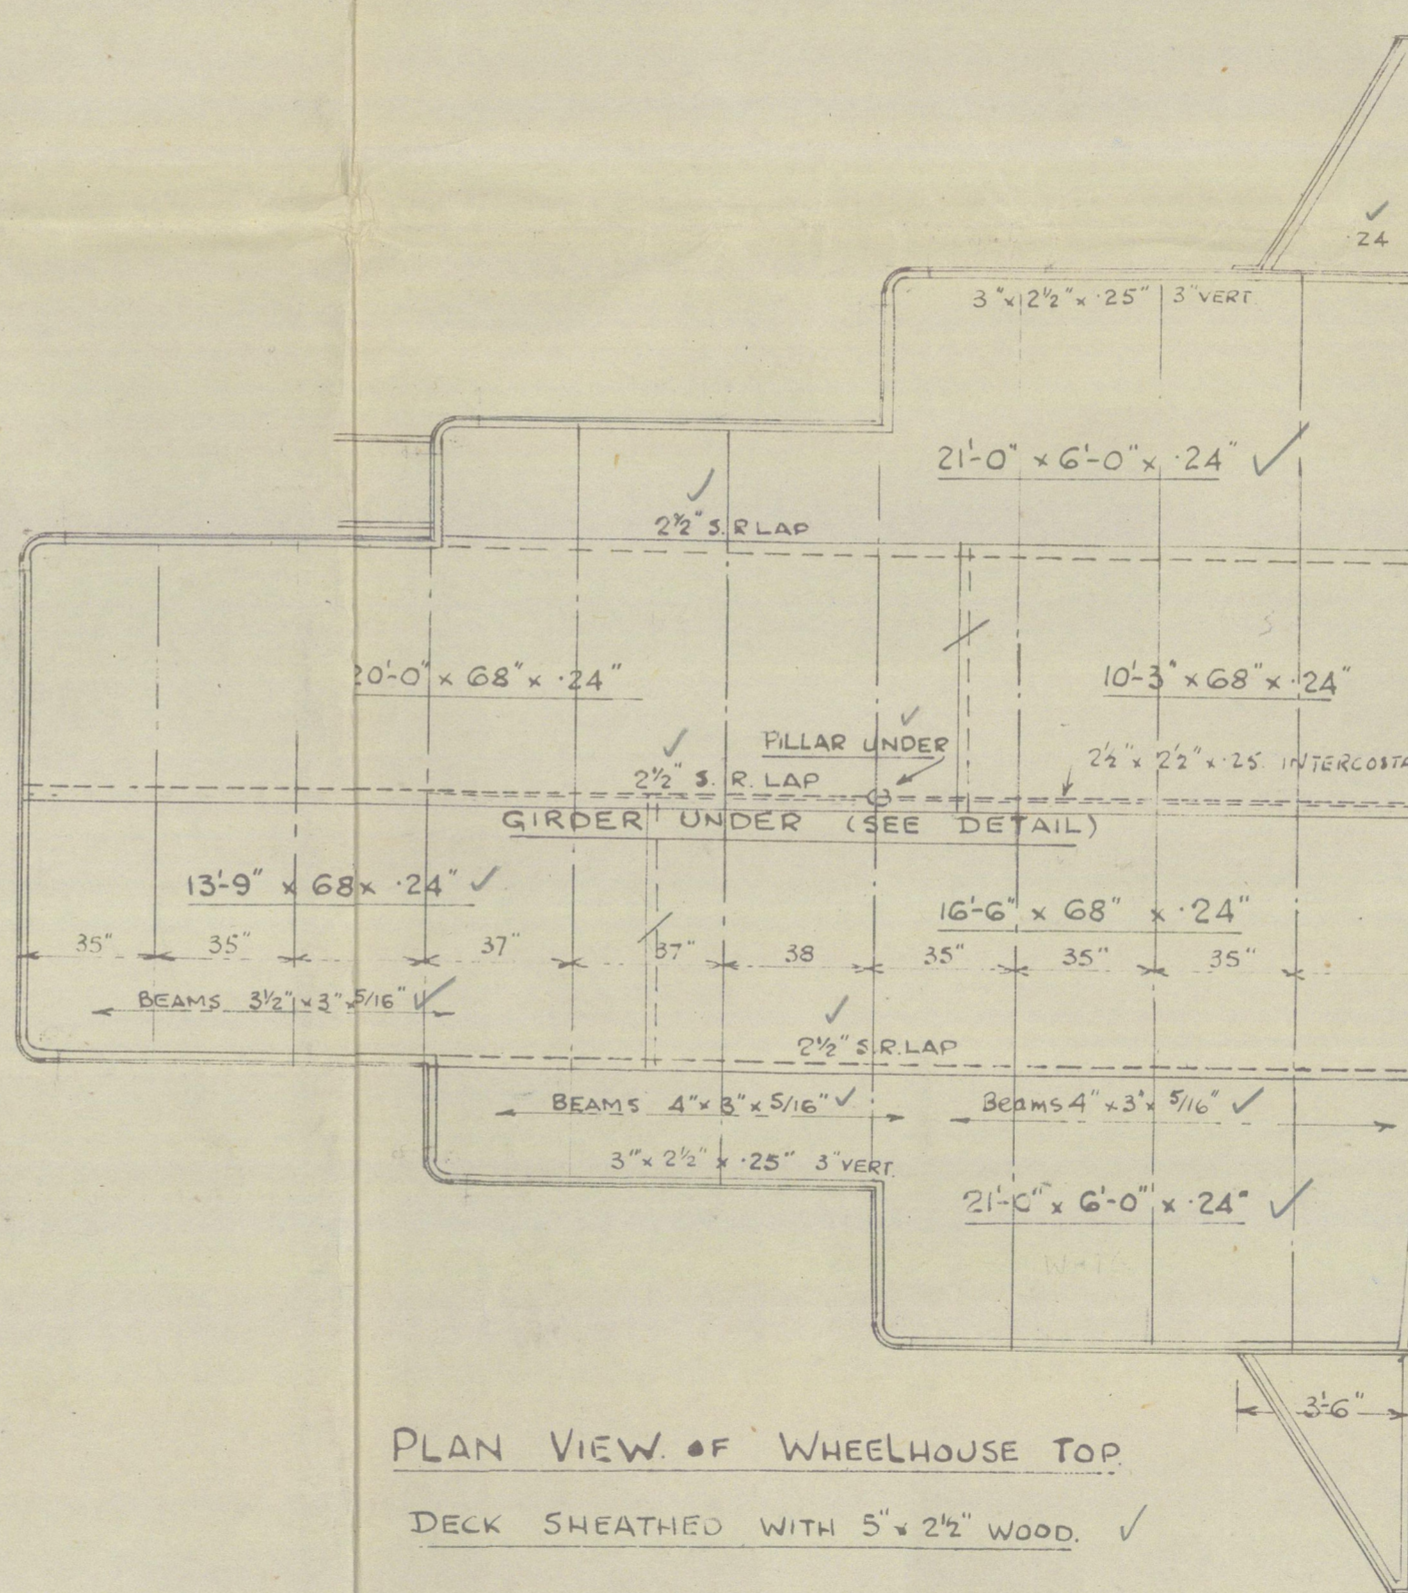


PLAN VIEW OF WHEELHOUSE TOP  
DECK SHEATHED WITH 5" x 25" WOOD

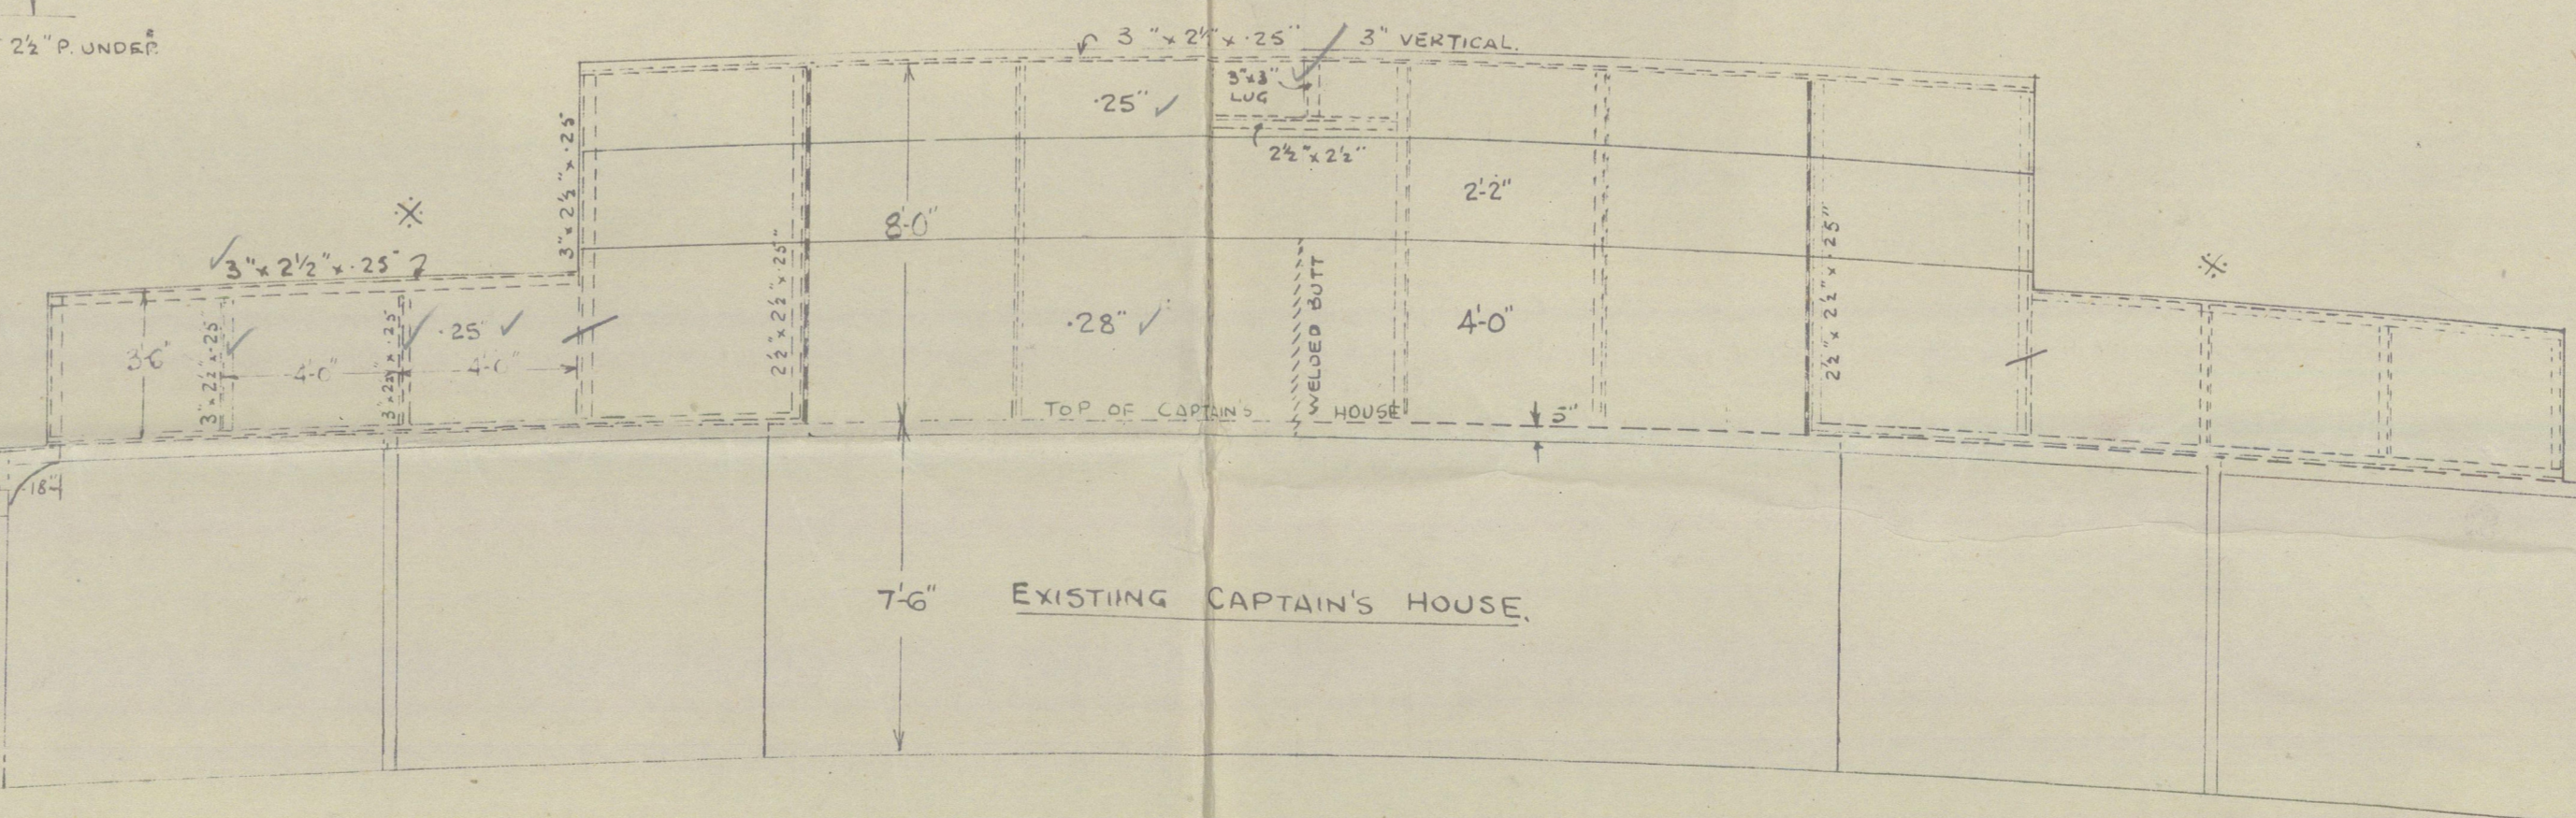


FORE END OF WHEELHOUSE  
(LOOKING AFT)

# "ACAVUS" WHEELHOUSE & CHART RM. ETC (RECONVERSION) 1/4" = 1 FOOT.

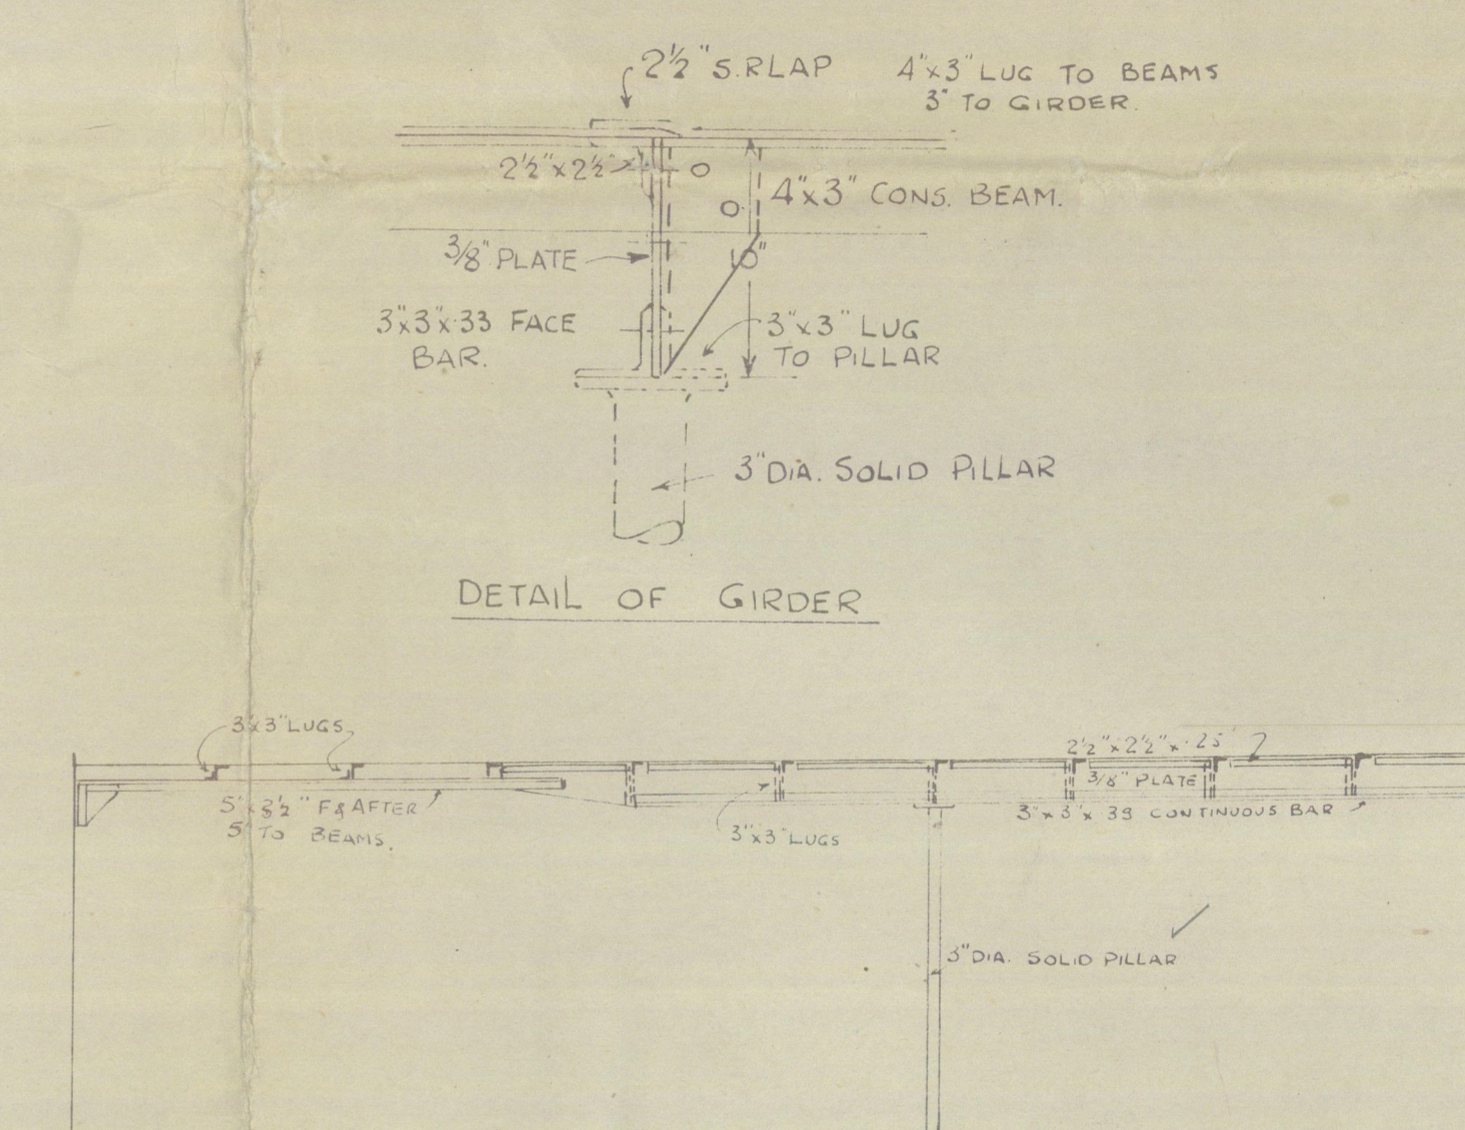

ELEVATION AT G SHOWING GIRDER

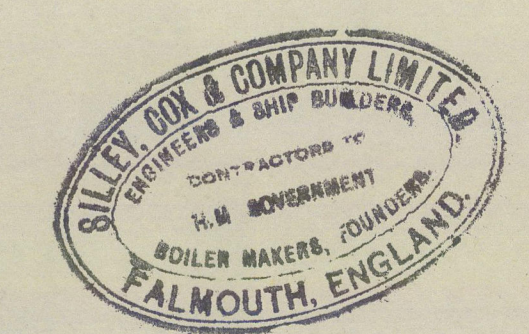

5.0.5726

