

N 5603

LLOYDS APPROVED PLAN N°3.

GENERAL ARRANGEMENT

✓
After conversions
during life of
the ship.

003620-003624-0003

003620-003624-0003



Lloyd's Register
Foundation


"ACAYUS."

N. 5603 - ~~2~~ ~~3~~

Copy of Lloyds approved
plan No. 3.

GENERAL ARRANGEMENT

SECTION IN WAY OF OERLIKONS.

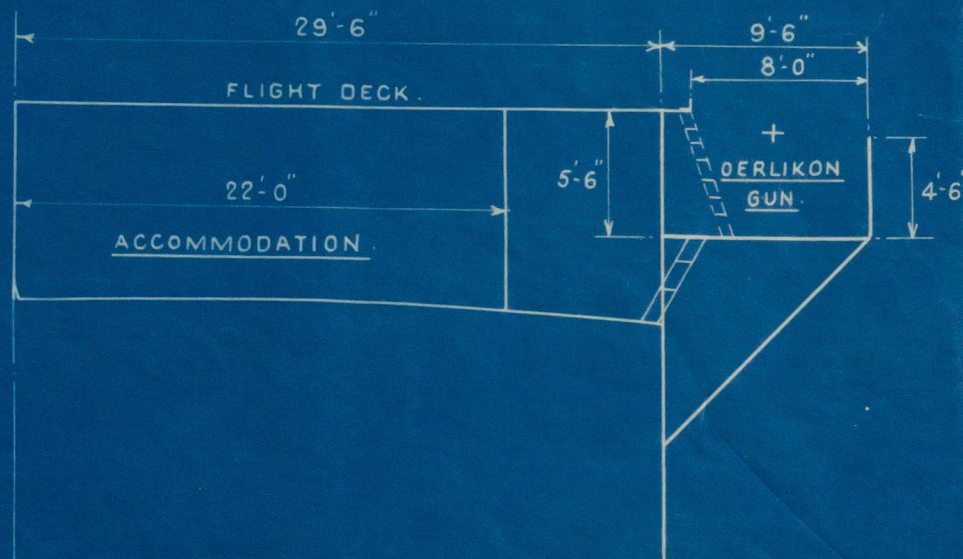

22'-0"

22'-0"

FLIGHT DECK

UPPER BRIDGE