


5 OCT 1943

## Lloyd's Register of Shipping.

Ship's Name M.V. 'ACAVUS'.

Official No. 163564

Memorandum of alterations reported since ship was surveyed for assignment of Load Lines  
in

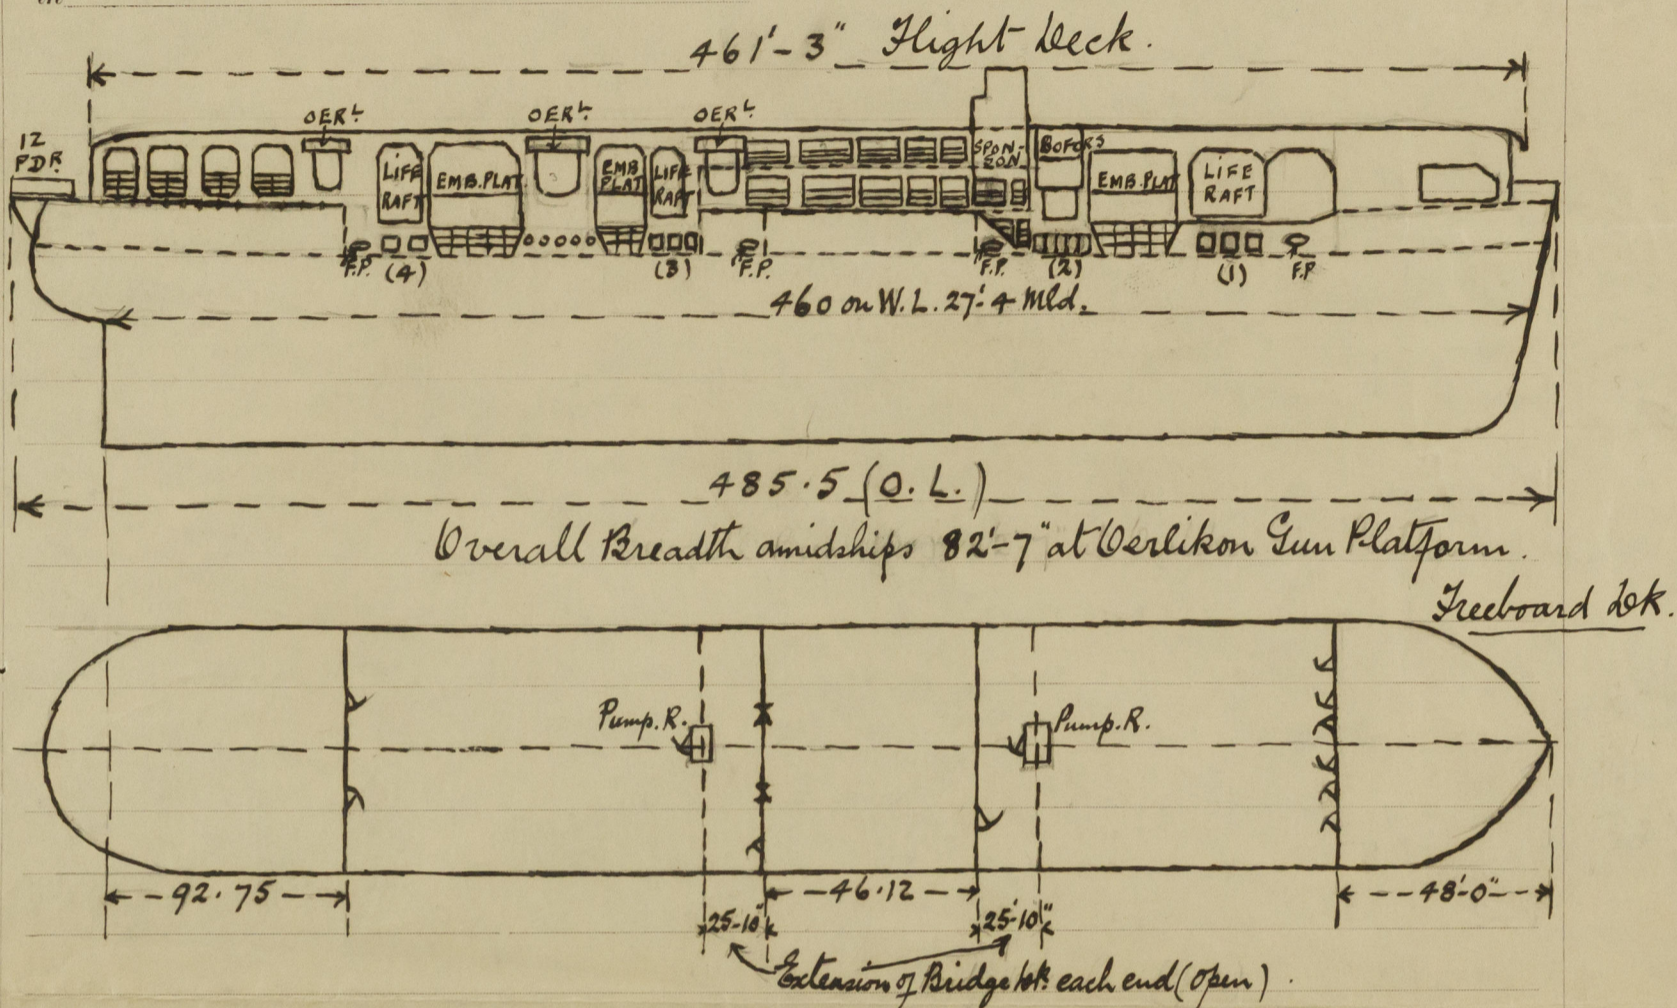

Height of Upper Bridge 7'-6" and Flight deck above Upper Bridge amidships 9'-9 1/2" at C.L.  
10'-2" at Side

Size of Freeing ports each side numbered from Forward.

(1) 4'-5" x 2'-6"	(2) 2'-2 1/2" x 2'-6"	(3) 4'-4 3/4" x 2'-6"	(4) 4'-5" x 2'-3 1/2"
4'-9 1/2" x 2'-6"	2'-7 1/2" x 2'-6"	4'-10" x 2'-6"	4'-10" x 2'-2"
4'-5" x 2'-6"	2'-7" x 2'-6"	4'-5" x 2'-6"	
	2'-8 1/2" x 2'-6"		
	2'-10" x 2'-6"		

3 Longitudinal bars in each.  
(spaced about 7 1/2" apart)

Particulars of Closing (state if capable of being manipulated from both sides). Yes.  
Poop bulkhead. Two hinged steel W.I. doors.

Bridge. After bulkhead. One hinged steel W.I. door. Two portable steel stiffened plates secured by hook bolts.

Bridge Forward bulkhead. One (star side only) hinged steel W.I. door.

Forecastle Bulkhead. Two hinged W.I. doors (companionways) four hinged solid teak doors 15/8"

Arthur Scullard

4. 10. 43