


T.S.S. "ORFORD".


ARRANG^T OF TOURIST ACCOMMODATION.

SCALE $\frac{1}{8}$ INCH = ONE FOOT.

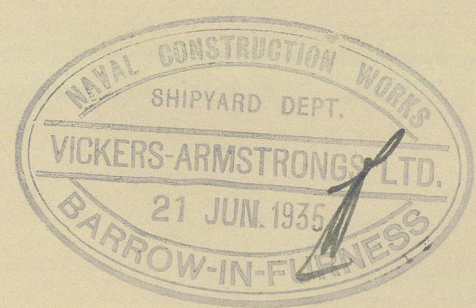

"F" DECK.

EXHAUST FAN TO BE ARRANGED FROM W.C. COMPARTMENTS.
WASH BASINS TO BE "ORION" TYPE (PORCELAIN).
HOT & COLD F.W. SUPPLY TO WASH BASINS.
W.C. SEATS TO BE FULL SHAPE (NOT HORSE-SHOE) & NOT OF WOOD.

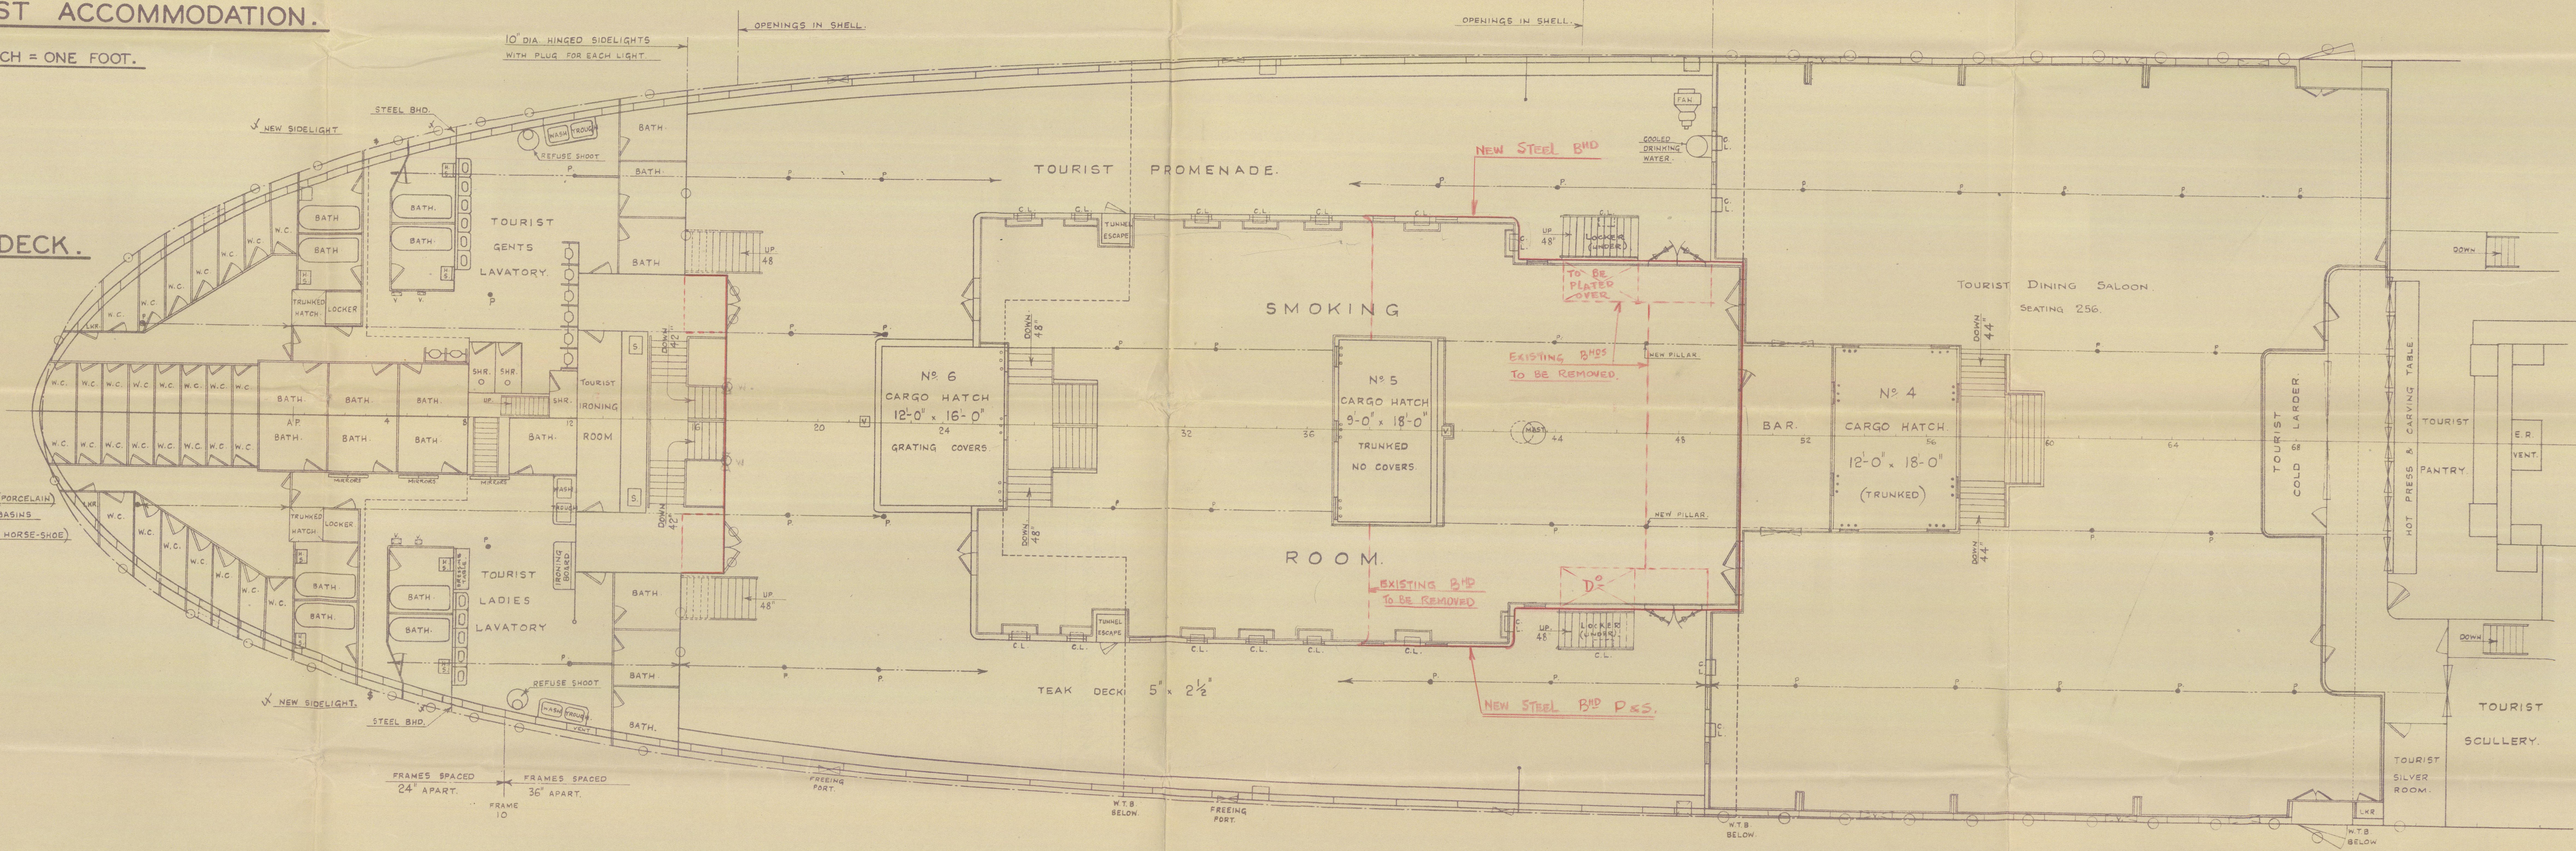

PLAN N^o 2.

003620-003624-0061

Y. S. S. "Orford"

Arrangement of Tourist Accomodation



© 2021

Lloyd's Register
Foundation

003620-003624-0061