

25.3.76

25.3.76

N° 627 637
DIMENSIONS 630 FT B.P. x 75 FT x 47 FT TO E DECK.
CLASS 100A WITH FREEBOARD.
DECK PLANS. SHEET N° 2.
SCALE 1/2" = 1 FOOT.



NOTE:
DIMENSIONS GIVEN AT CORNERS OF OPENINGS ON DECK C, D, E, F, G, H.
PLATING OF ALL DECKS ARRANGED FOR MULTIPLE PUNCHING.
MATCH END BEAMS SAME SIZE AS ORDINARY BEAMS IN THE VICINITY.
SEE SEPARATE SUBMISSION FOR PILLARS & GIERERS.

F. DECK.


G. DECK.

H. DECK.

F. DECK.

G. DECK.


H. DECK.

 

003620-003624-00362

MESSRS VICKERS

War loss


No. 627 - "ORFORD" ^{SUNK} 
+ No 637 - ORONTES

'F', G + H DECKS *

Bureau J. E. Report No 2271

No 637 - "T. S. S. ORONTES"

Bureau J. E. Report No 2331

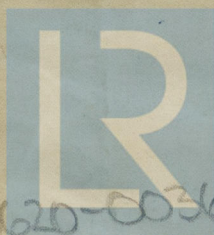

© 2021

Lloyd's Register

003620-003621-0062
Foundation