
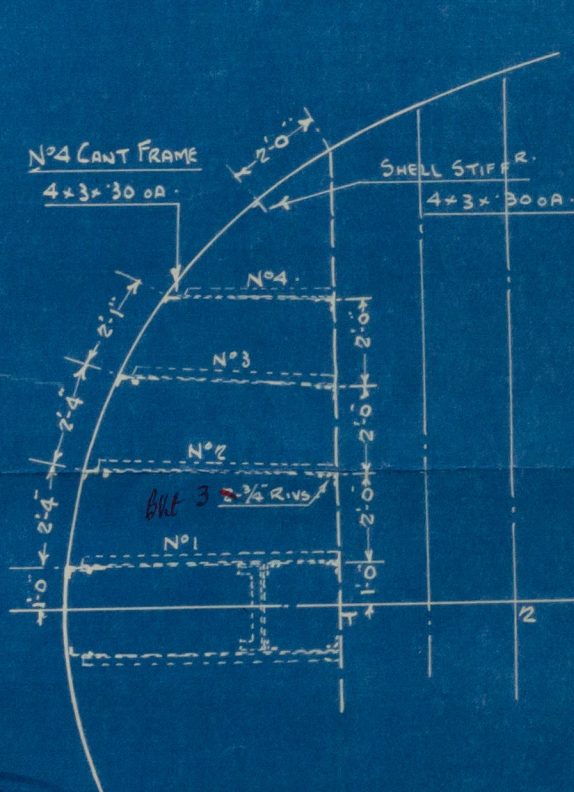
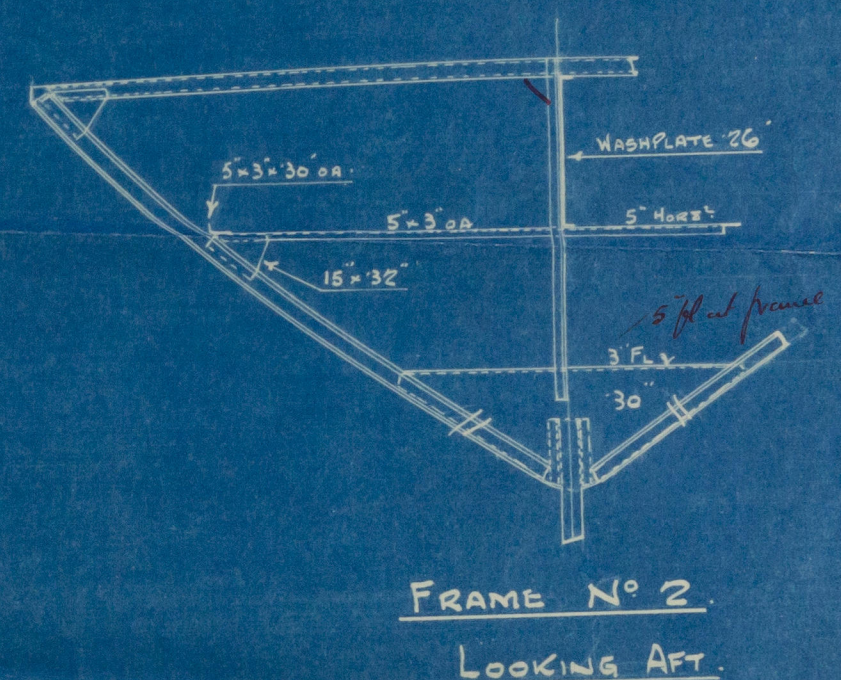
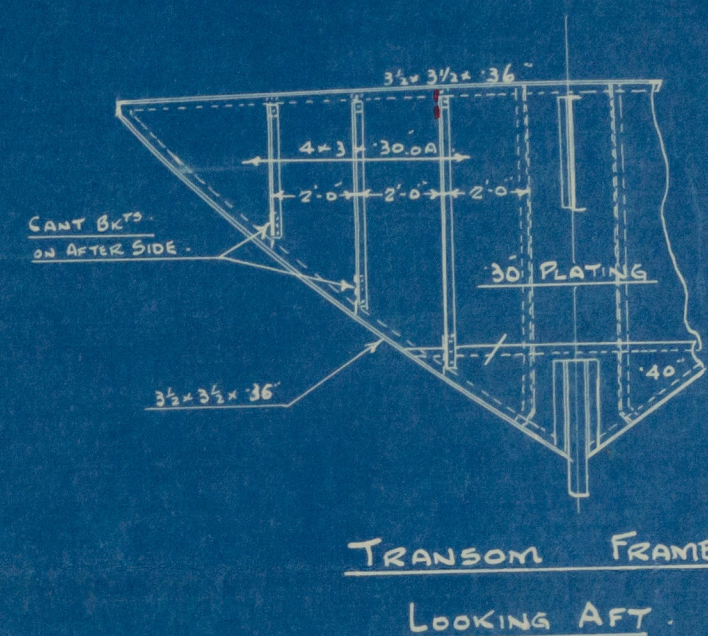


SHIP N° 177. 182-189.


STIFFENING OF STERN.

SCALE $\frac{1}{4}$ " = ONE FOOT.

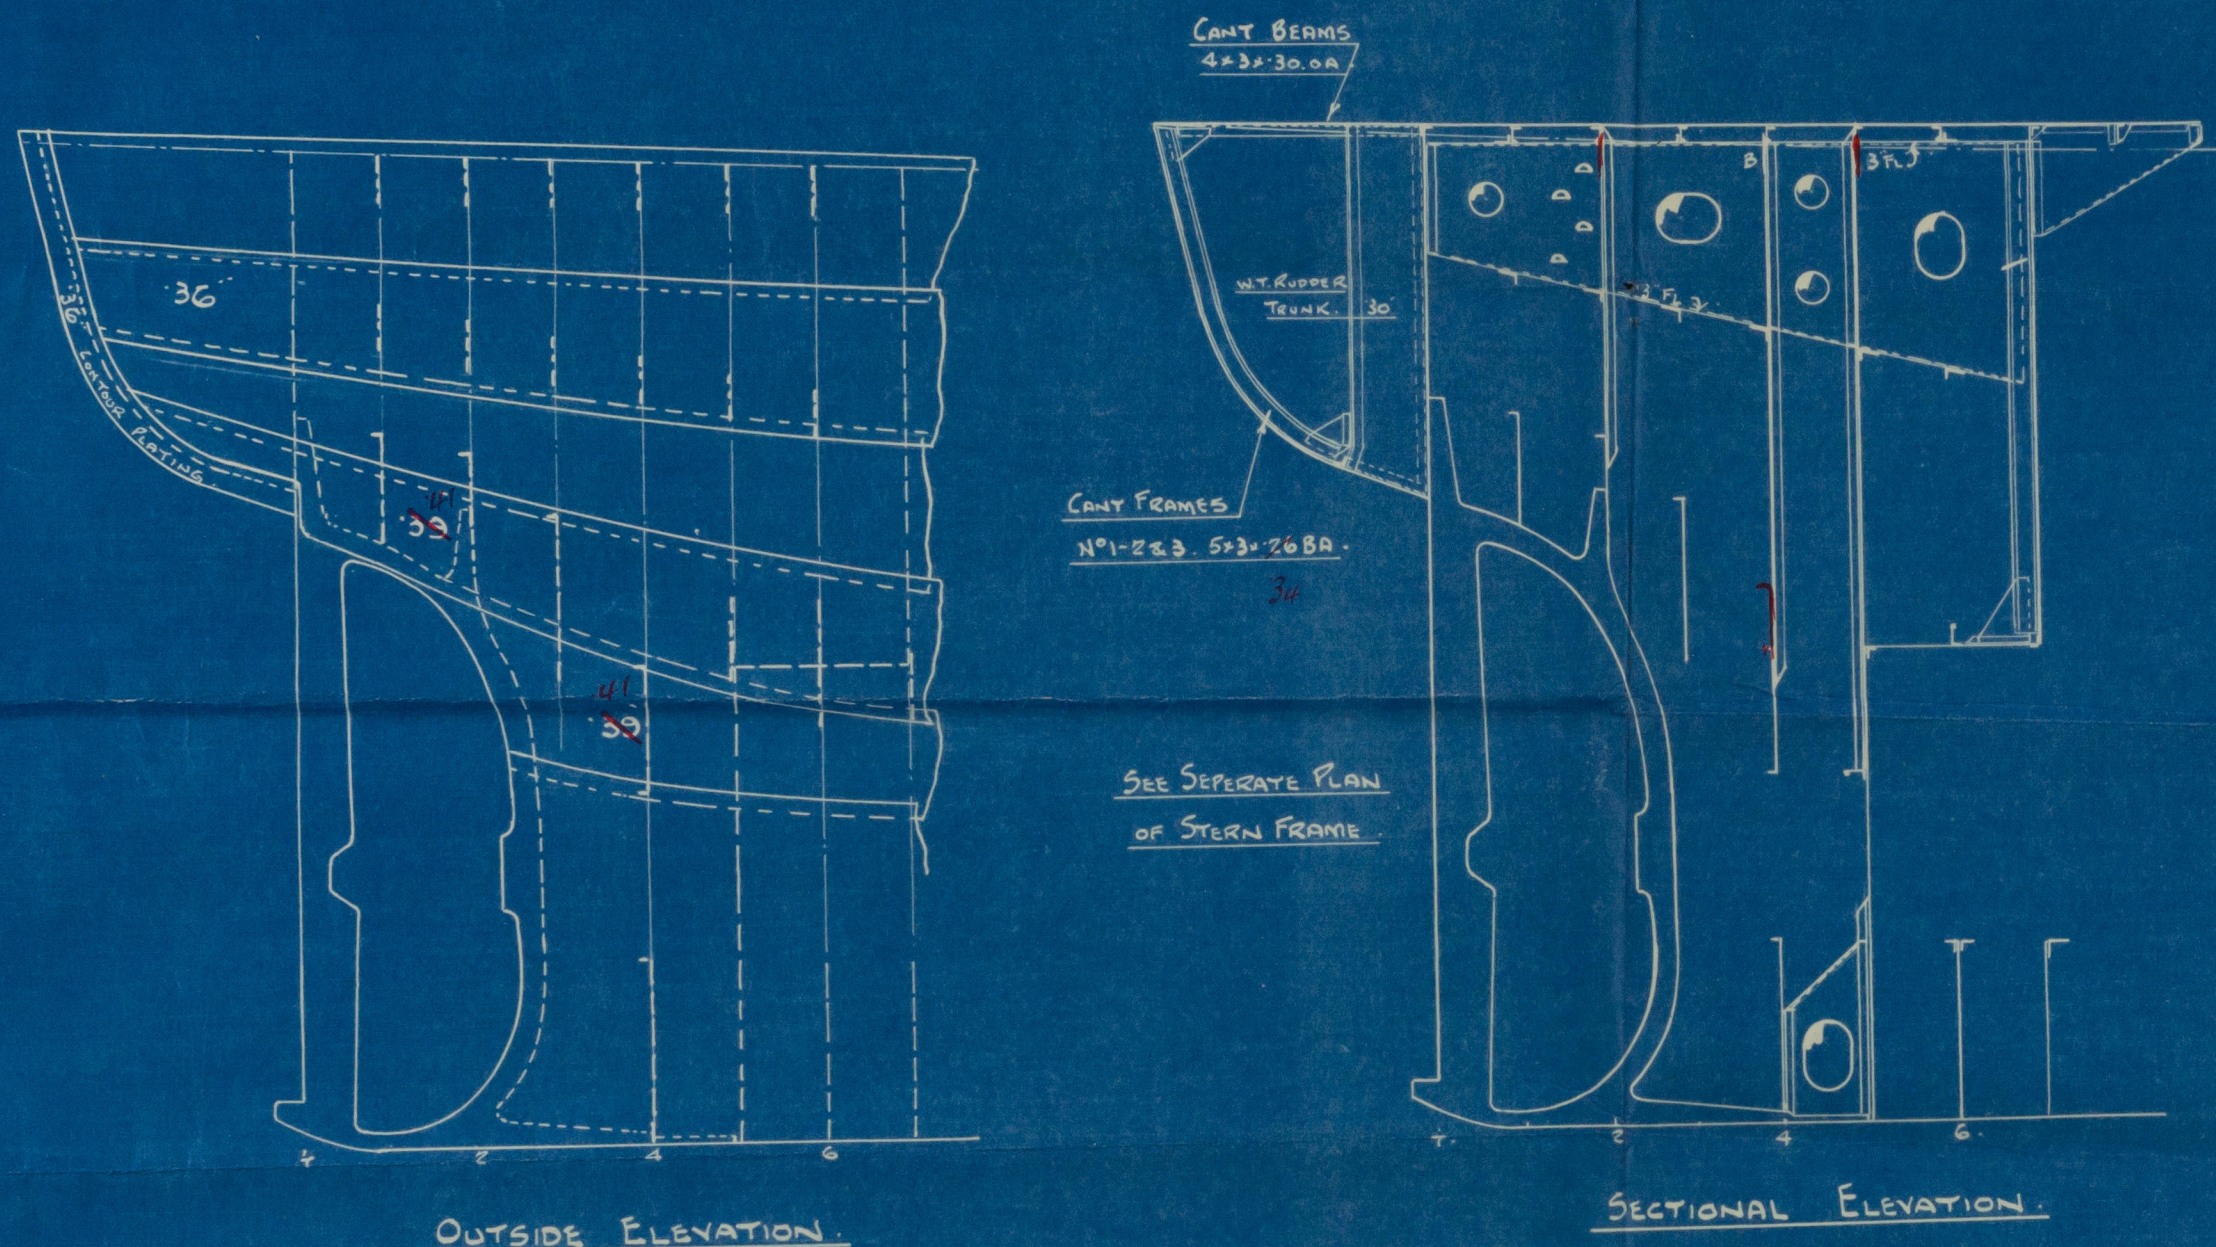

SEE PROFILE FOR SCANTLINGS
OF FRAMES & BEAMS.

APPROVED for P189
LLOYD'S REGISTER OF SHIPPING
Hickerson
DATE 20/2/35

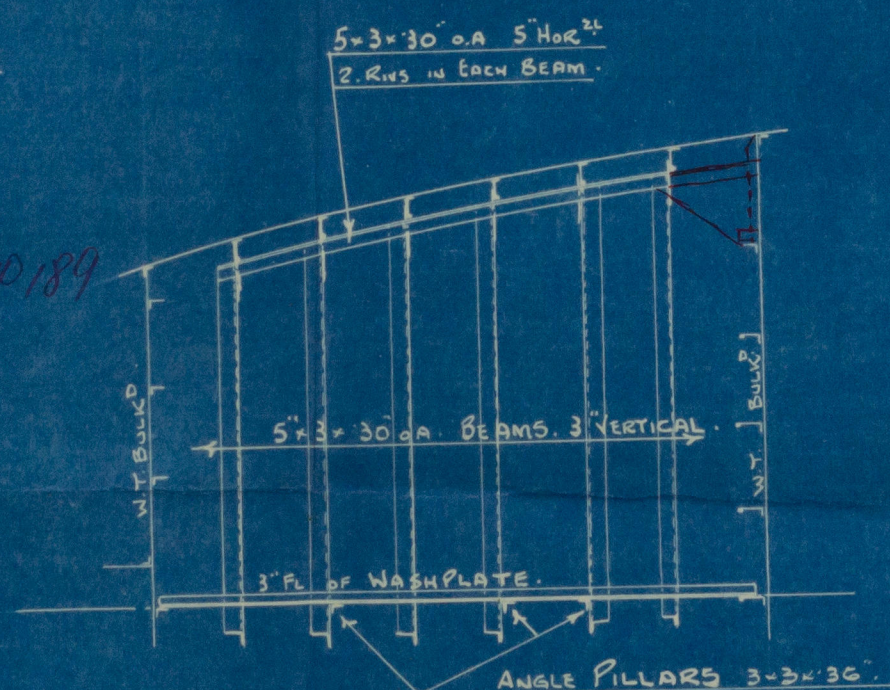

APPROVED
LLOYD'S REGISTER OF SHIPPING
Hickerson
6-3-34

APPROVED
LLOYD'S REGISTER OF SHIPPING
Hickerson
27-2-35

FRAME N° 4.
LOOKING AFT.

PLAN N° P. 23.

003620-003624-0159

THE BURTTISLAND SBC^{CO}
N^o 177

STIFFENING OF STEAM

ⁿ
8/5 Parkwood.

Also N^o 182

ⁿ
s.s. "Avonwood"

Lith. Rpt. No. 18678.

Also N^o 189.

ss "Westwood"

Lith. Rpt. No. 18879



© 2021

Lloyd's Register
Foundation

003620-003624-0189