
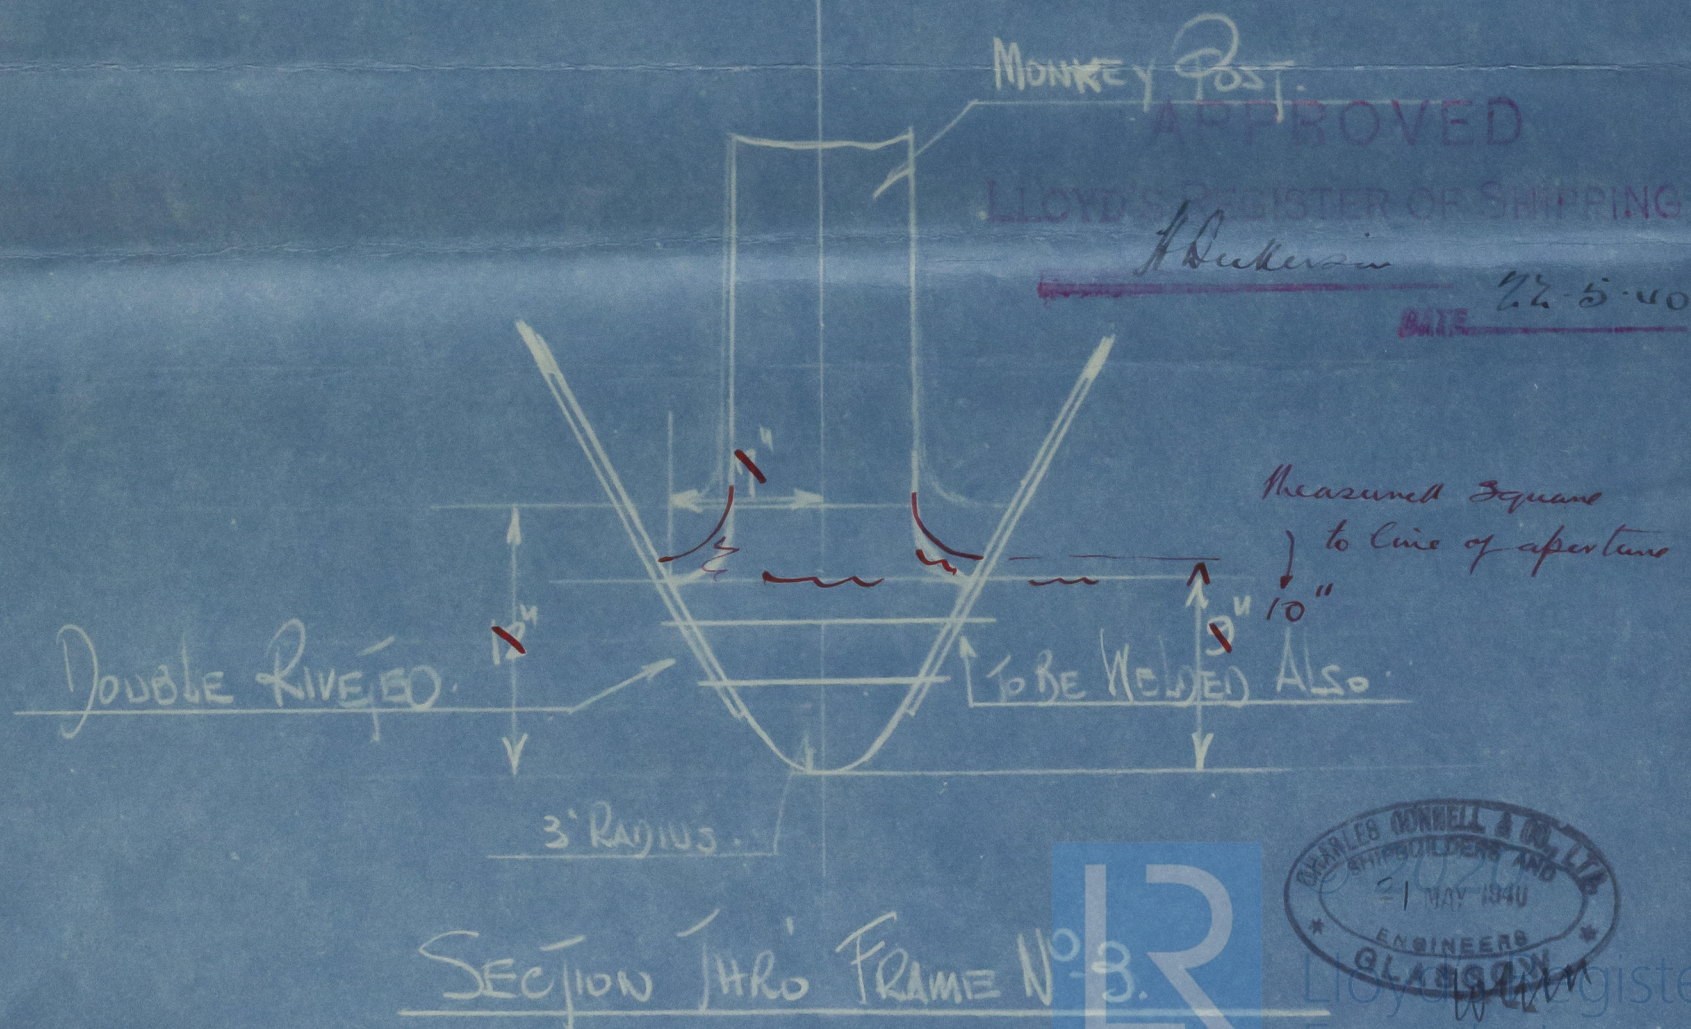
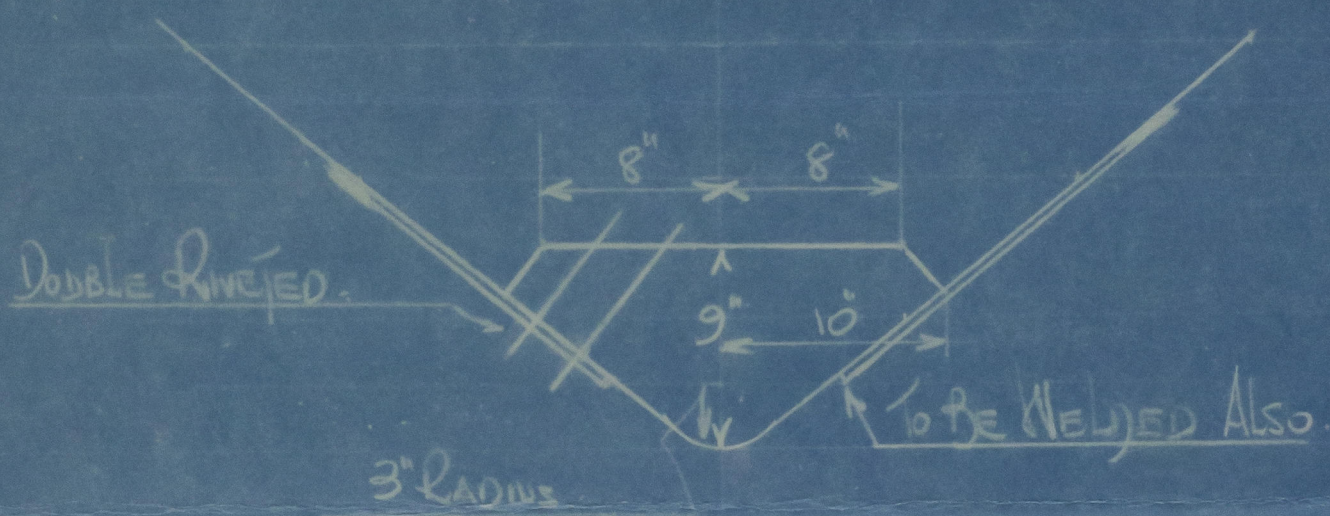



Nº 430 SS.

AMENDED STERNPOST SECTIONS

SCALE $\frac{1}{2}$ = ONE FOOT.

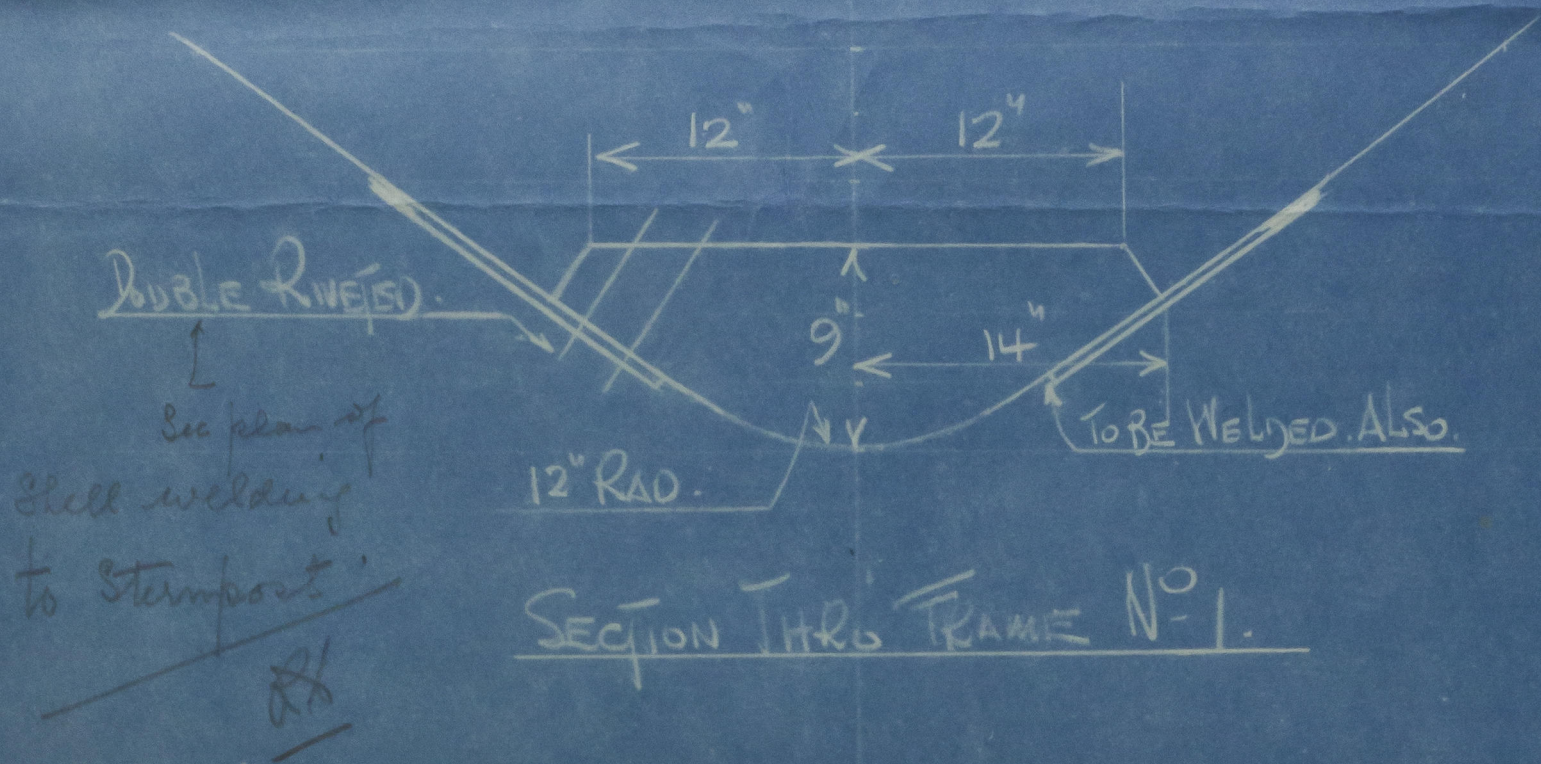

MONKEY POST
APPROVED
LLOYD'S REGISTER OF SHIPPING
H. Duckers
22-5-40
DATE

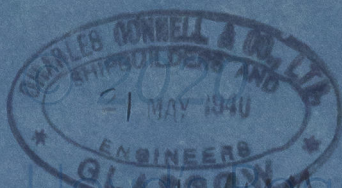

Chas. Bonnell & Co. Ltd.,

No. 430.

Amended Stampost Section.



© 2020

Lloyd's Register
Foundation