

DRAWING. N°4/W.G.D. "ONDINA"


Port Side

Forward.

M.V. "ONDINA" at Fremantle (Nov 1942 to June 1943)

Drawing showing Plan of After Tanks after Temporary Repairs had been done at Fremantle and showing alterations and additions to Pipe lines to suit Petrol & Ballast prior to the Vessel being Chartered by American Navy as Mobile Depot Ship


Drawing done by --- M. J. James SURVEYOR TO LLOYD'S REGISTER.

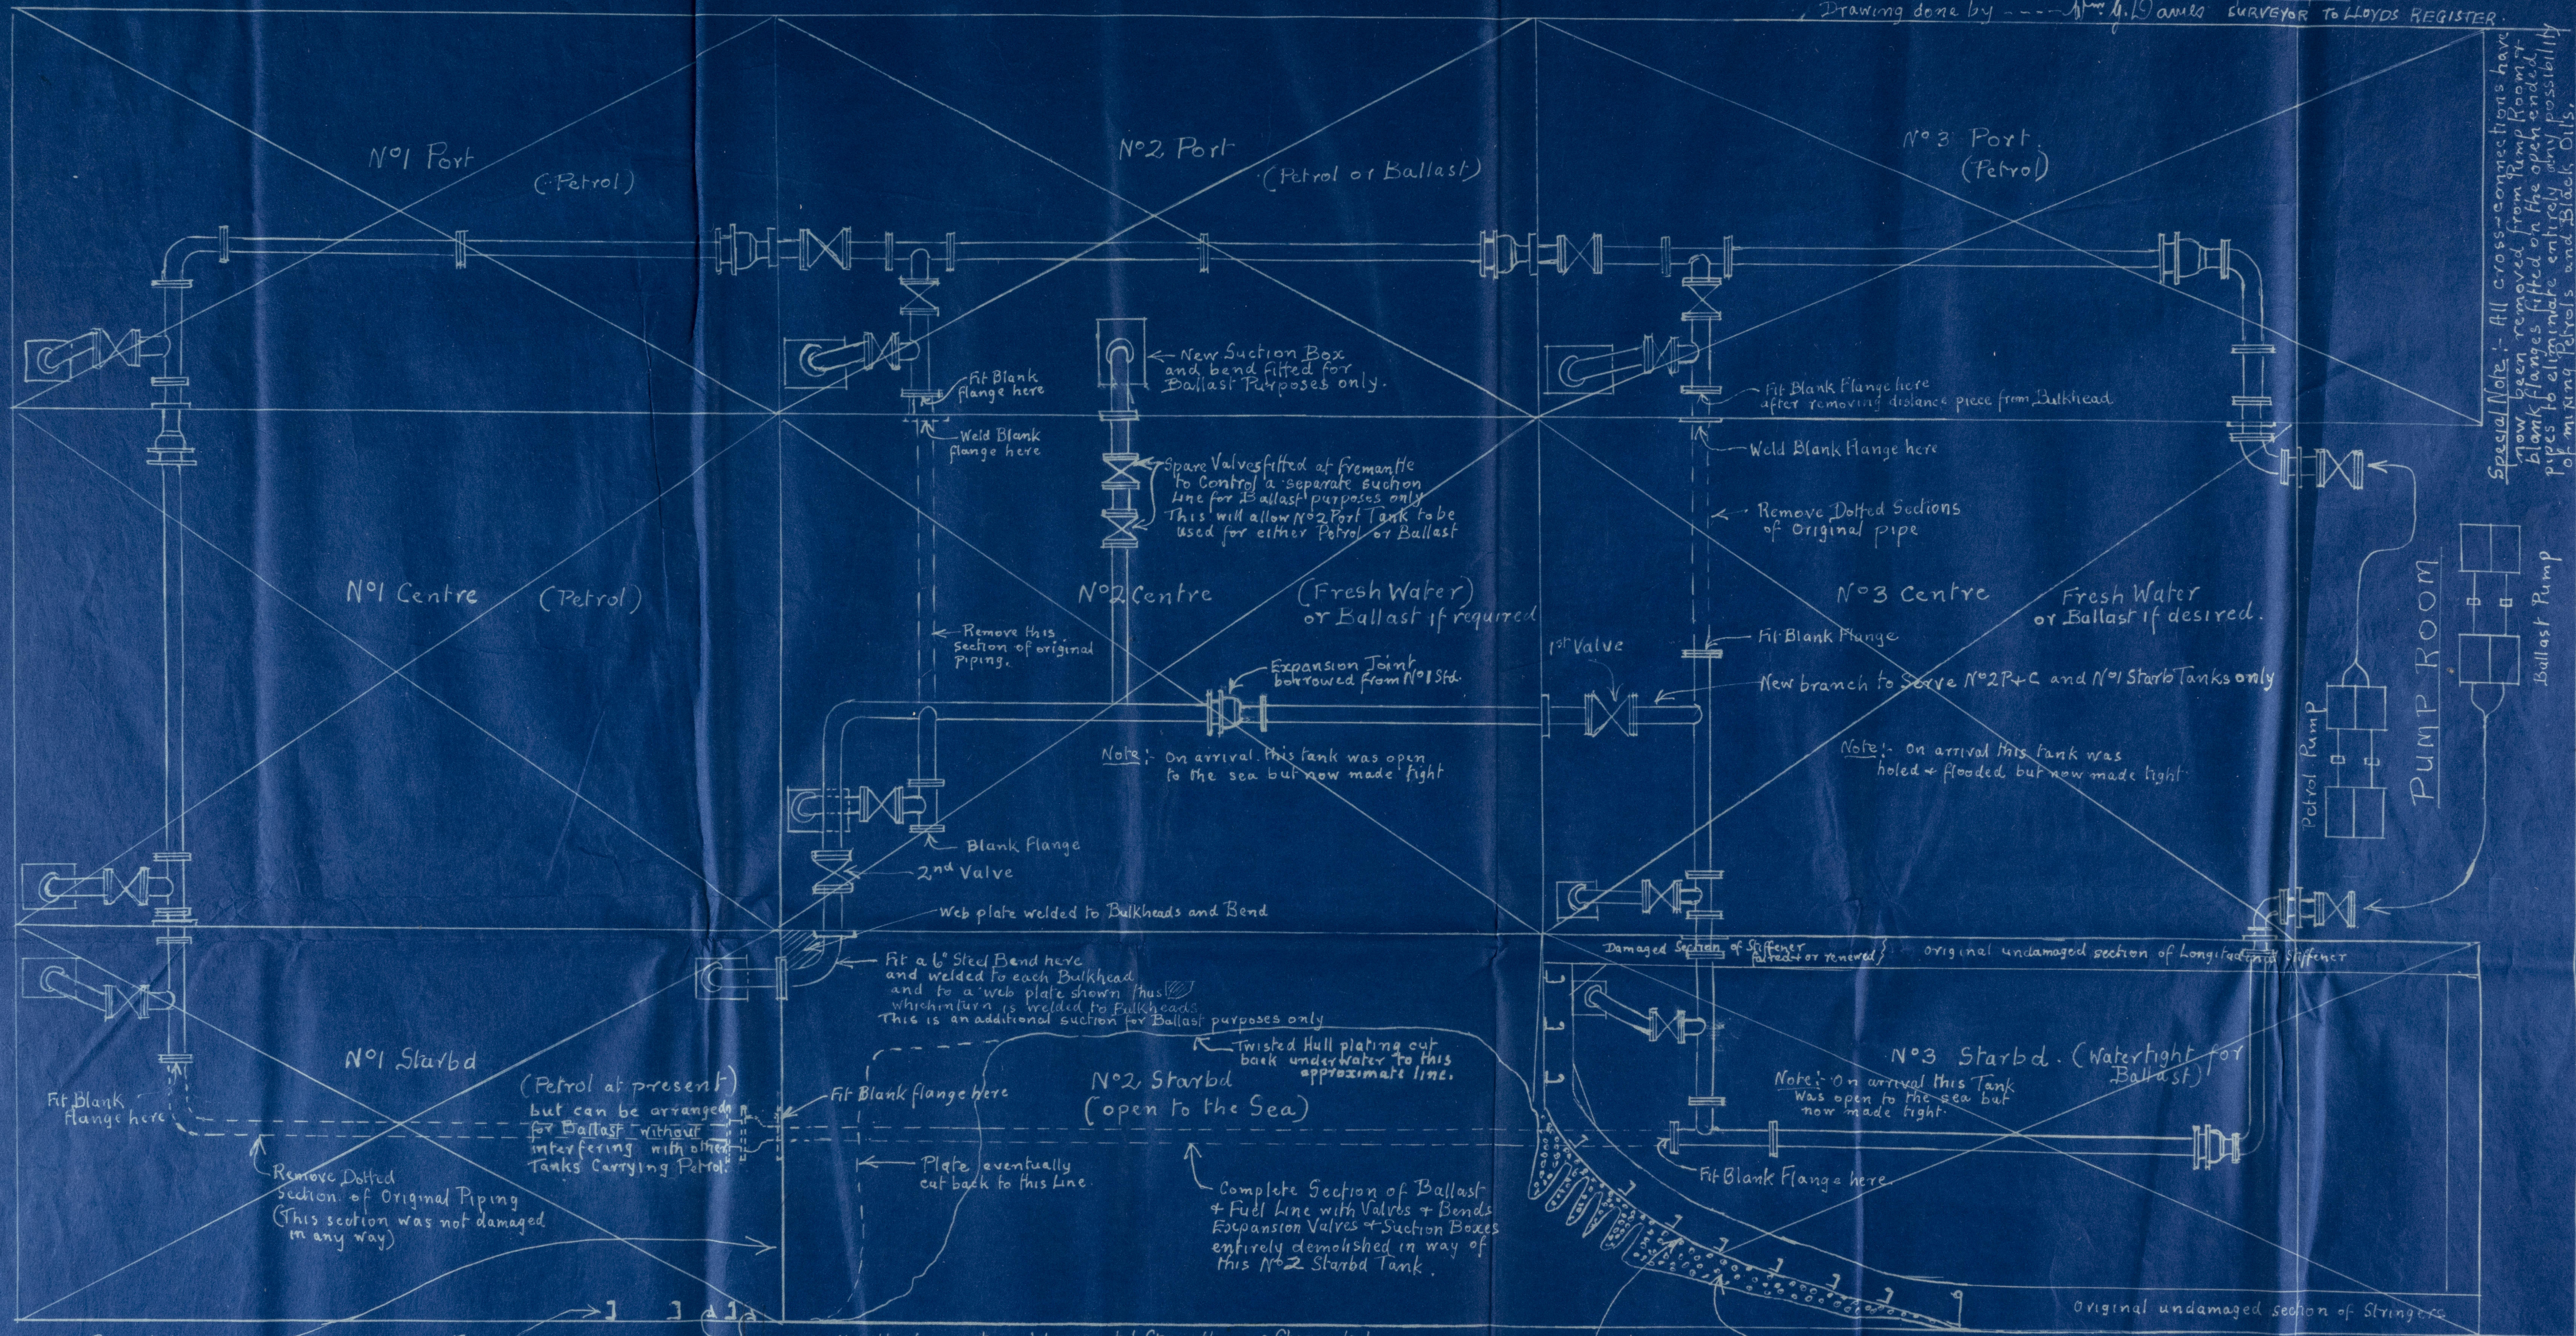

R

003631-003639-0132

See Remarks in Report
regarding additional strengthening
at bottom of this bulkhead &
safeguard against added st
imposed at sea.

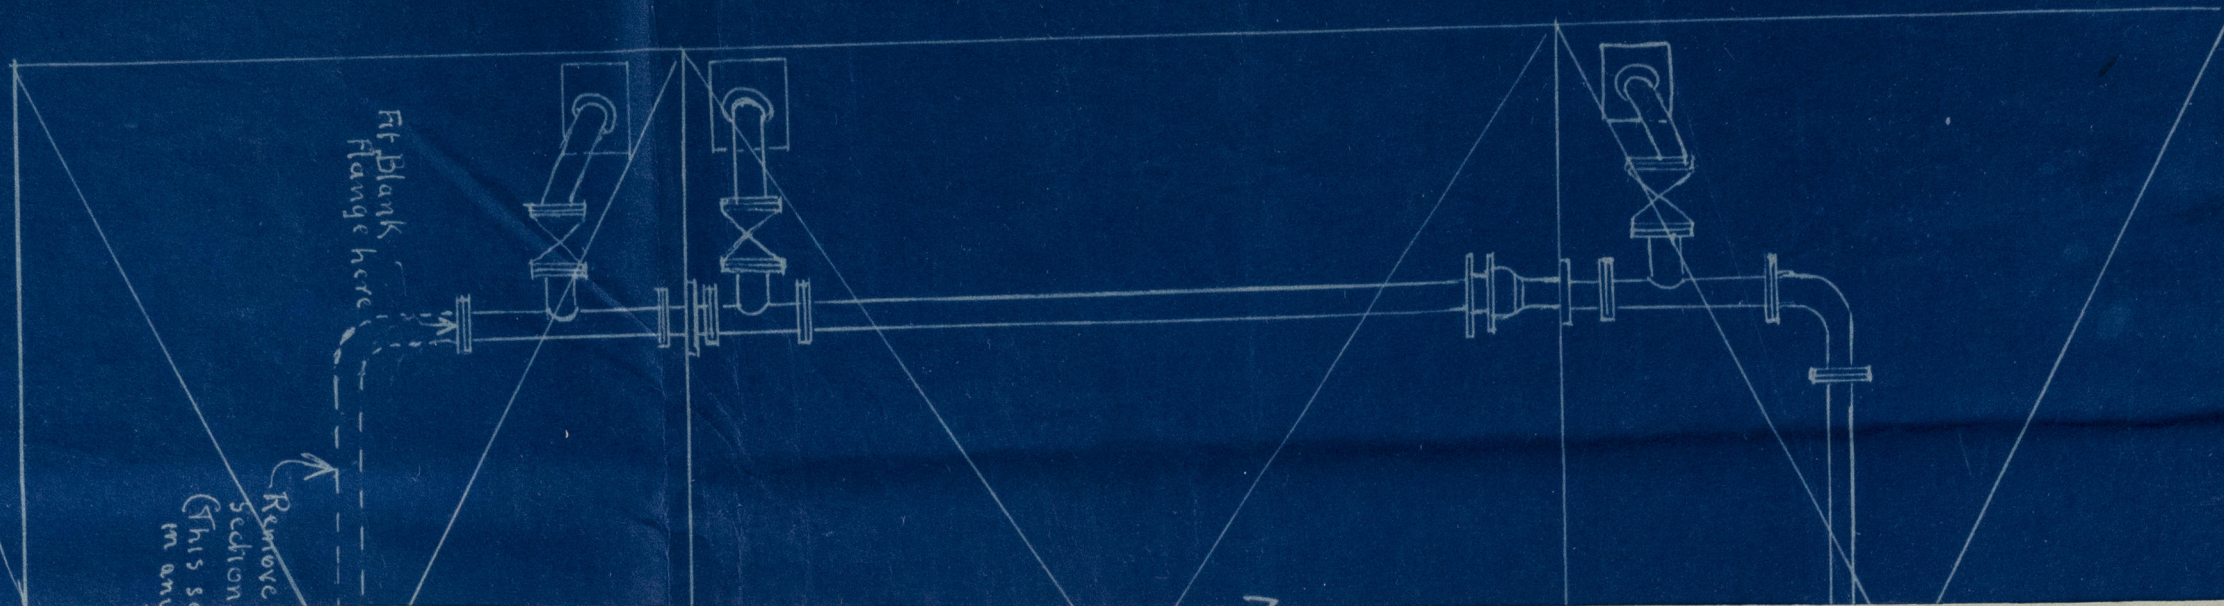

TILLYS LIMITED,
PLAN PRINTERS
724 MAY ST., PERTH

003631-003639-0132



© 2020

Lloyd's Register
Foundation