



# "AVISMERE" - Ex "OCEAN VISION"

SKETCH SHOWING BOTTOM SHELL PLATING CORRUGATIONS AND ADDITIONAL STIFFENING NOW FITTED

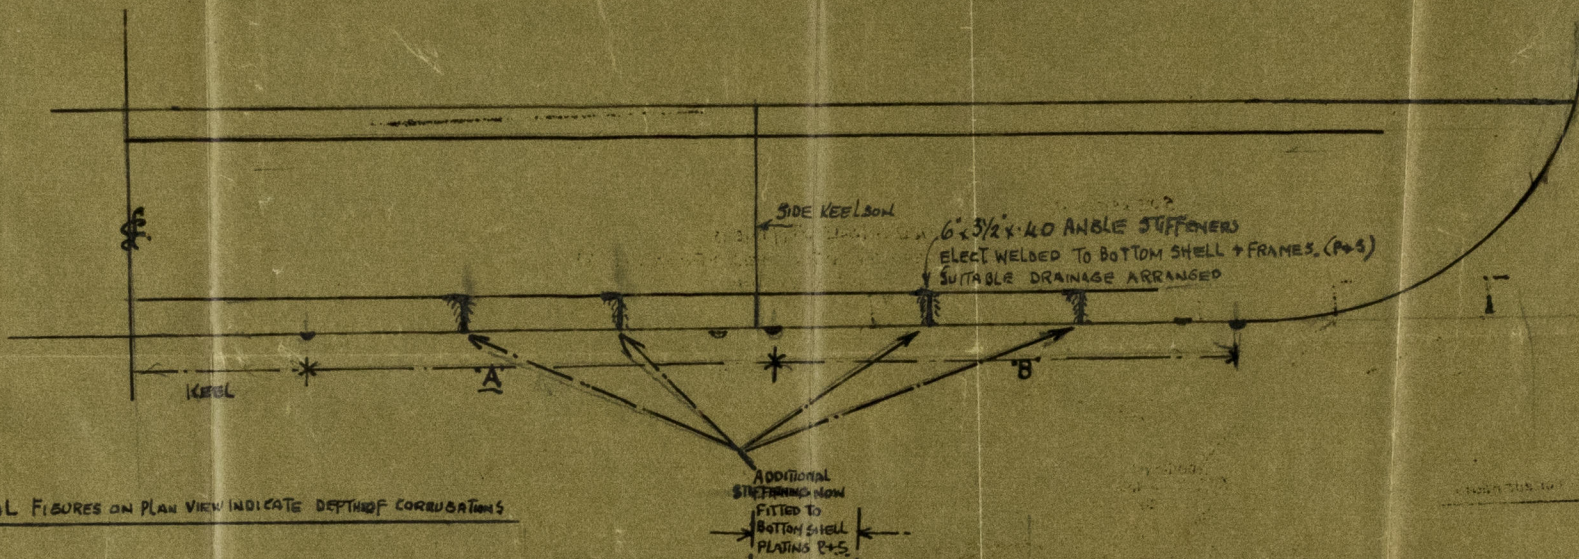

DECIMAL FIGURES ON PLAN VIEW INDICATE DEPTH OF CORRUGATIONS

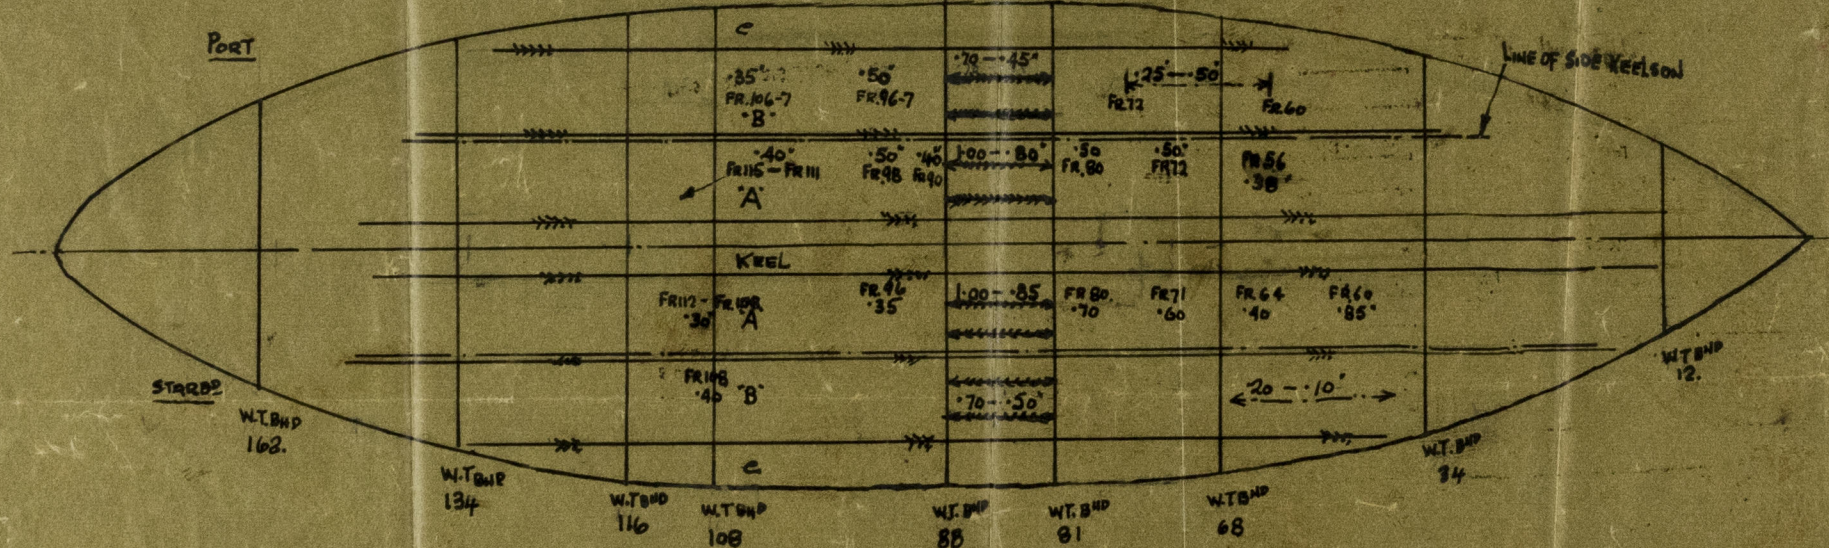

AFT. P.T.	Nº 5 HOLD	Nº 4 HOLD	DEEP TANK	E + B. SPACES	CROSS BUNKER	Nº 3 HOLD	Nº 2 HOLD	Nº 1 HOLD	F.P.T.
-----------	-----------	-----------	-----------	---------------	--------------	-----------	-----------	-----------	--------



Insc rept No. 104761.

