

Centre girder bottom angles
Bottom angles on floors, int

Per. in Union Plan Dept.

$5 \times 2 \frac{1}{2} \times \cdot 8 \cdot 12 \cdot 72$

$\cdot 613 - \cdot 50$

both beams $5 \times 5 \times \cdot 54 - \cdot 50$

Reverse for } $3 \frac{1}{2} \times 3 \frac{1}{2} \times \cdot 45$
angles. }

Right flange may require
to be increased to $4 \frac{1}{2}$ "
if both edges of flange
and side girders are
cut back.

Plan of bracket flange



© 2020

Lloyd's Register
Foundation


003631-003639-0247



1/13

71 D

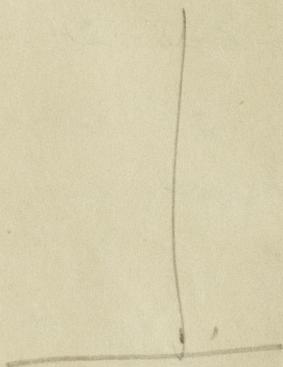

© 2020

Lloyd's Register
Foundation

c
l
o
t
a
g
p
b
i
b
c
b

fu
ad
wi
ab

sug
bot
ren
int
on
of
The
flo
or
thi
pla
side