

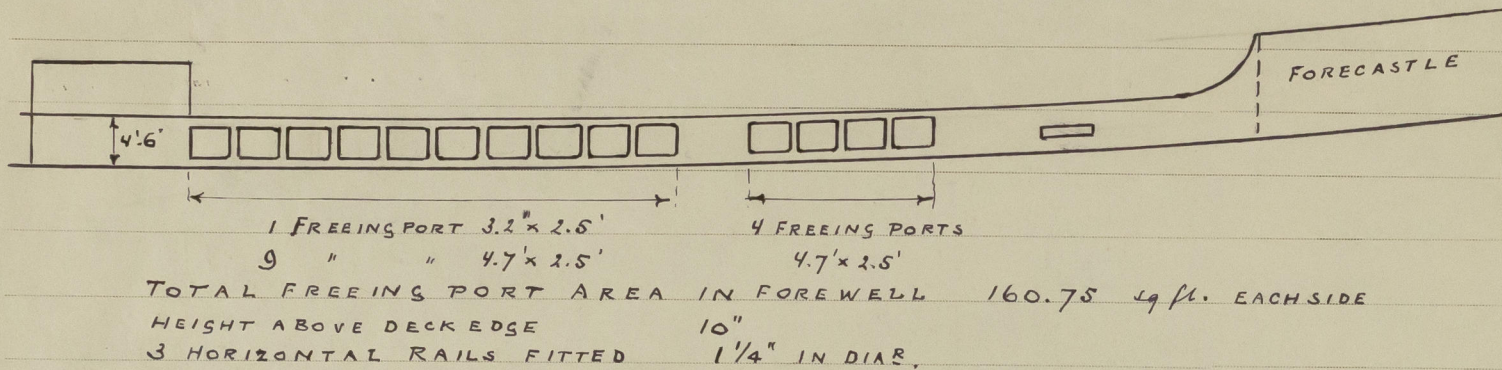
33387

Lloyd's Register of Shipping.

FEB 20 1940

Ship's Name MOTOR TANKER "NORAVIND" Official No. _____

Memorandum of alterations reported since ship was surveyed for assignment of Load Lines
 in Falmouth 5th 26th of Jan. 1932

POSITION OF FREEING PORTS IN FOREWELL.Rotterdam 10th of February 1940

R. W. M. P.

Noted
S. W. B.

20/2/40



© 2020

Lloyd's Register
Foundation