

11 NOV 1952

33432 ✓

Rpt. C. 11 (Contd.)

Index No.

Lloyd's Register of Shipping.

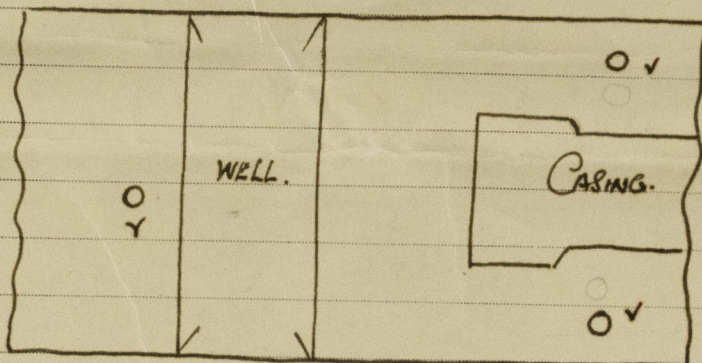
Ship's Name

LAIRD SOALE

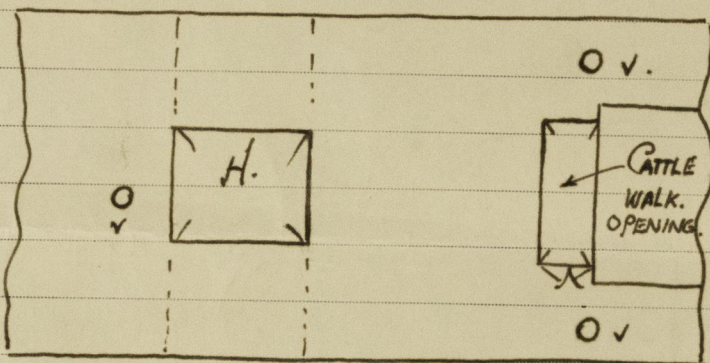
Official No.

152136

Memorandum of alterations reported since ship was surveyed for assignment of Load Lines in ✓

SHELTER DK.

Locals on Shelter deck
23½' dia.
3' 6" x .40 Coaming, stayed
to deck, wood plugs & C.C.
fitted.

MAIN DK.

Cattle walk door
hinged steel. 5' 0" x 3' 1½"
1' 7" x .44 Coaming
hinged 8½' above deck.

H Kemp

6.9.52.

noted.

J.B.

11 NOV 1952