


No 496.


PUMPING PLAN.

SCALE $\frac{1}{8}$ = 1 FOOT.

Brit. Imp.

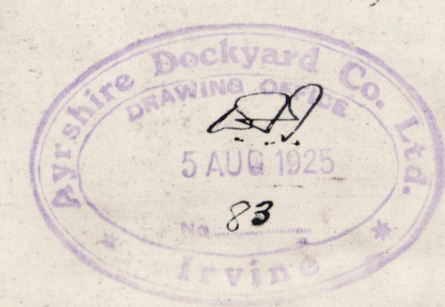


BALLAST MAIN 5 1/2" BORE

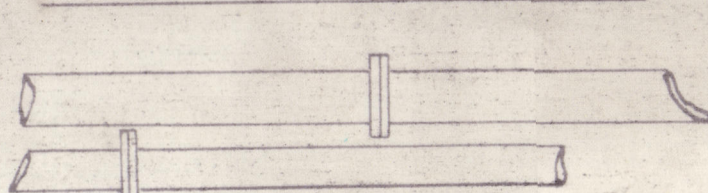


BILGE MAIN 4" BORE

10 AUG 1925

Approved
11/8/25

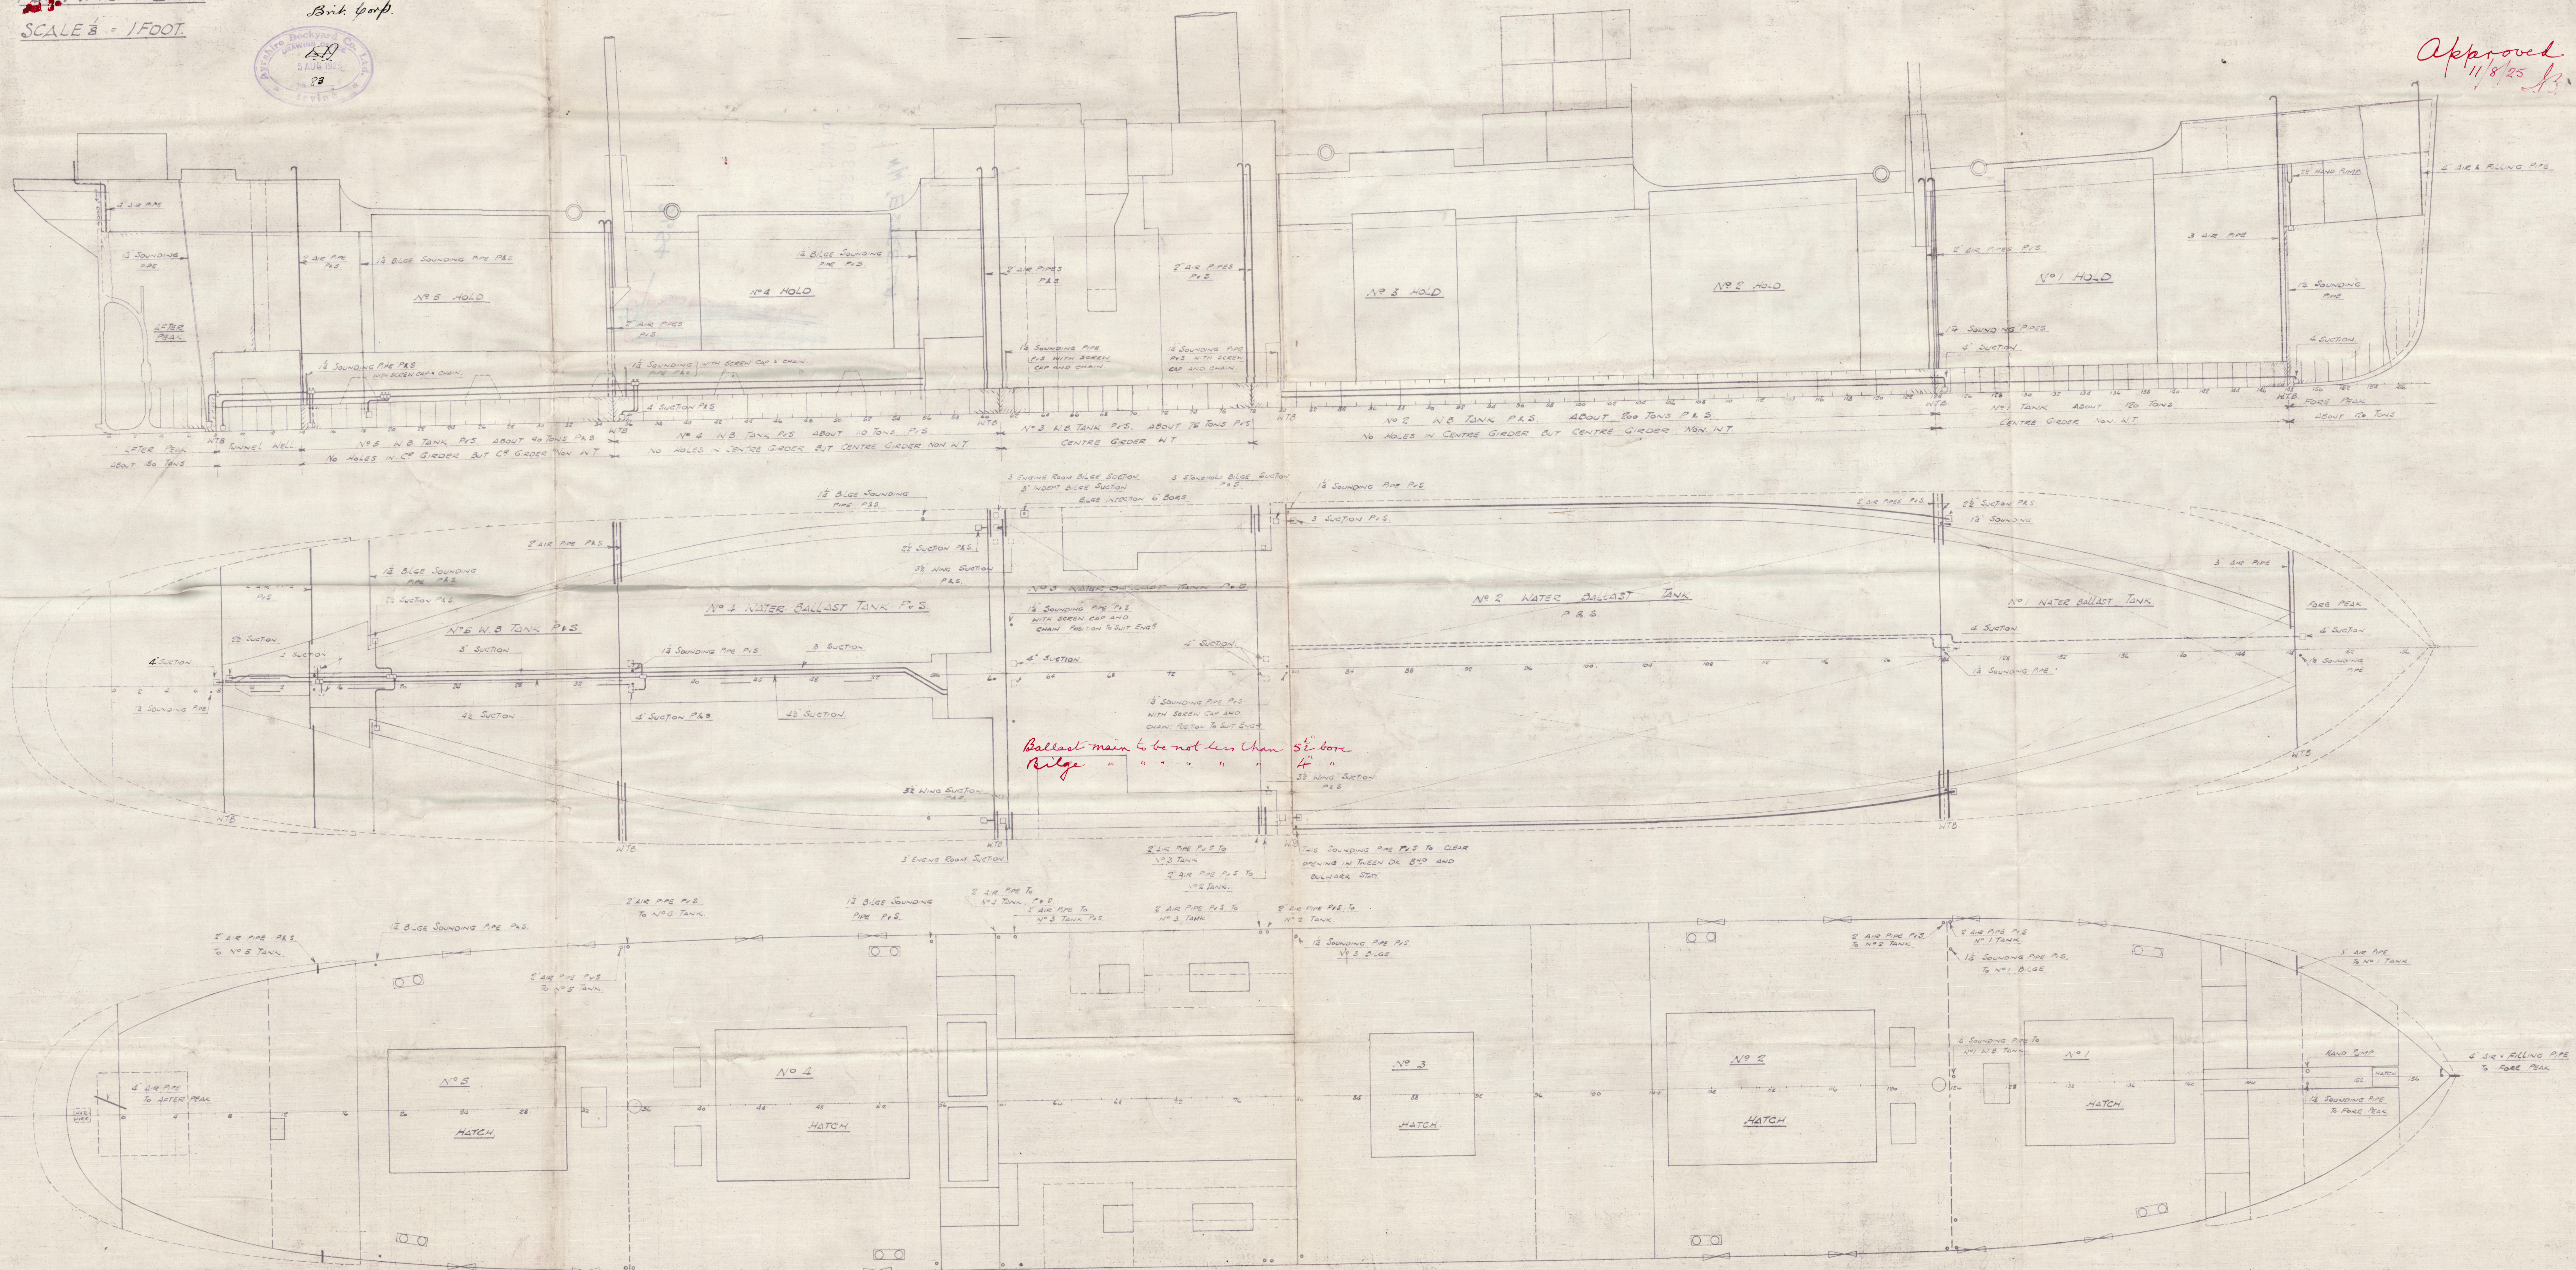

Brit. corp.

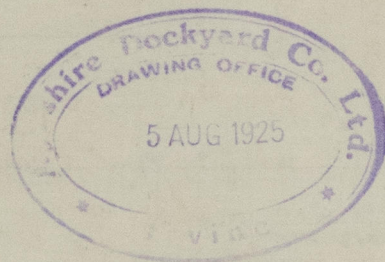

Nº 496
Pumping Plan



© 2020

Lloyd's Register
Foundation

003649-003658-0144

Ayrshire Dk. Co.

L96
3654

Pumping
40

Retain

PLANS TRANSFERRED
TO SISTER VESSEL

Halis Kalkavan
N/W 'ESTRELLA'

Ayrshire Dk. Co.

L96
Pumping Plan

11.8.25

L.



© 2020

Lloyd's Register
Foundation

003649-003658-0144