


DIMS 156'-8" B.P. x 26'-0" MLD. x 15'-0" MLD.
TO CLASS  100 A.I. STEAM TRAWLER

PROFILE & DECK PLAN

STEEL SCREW TRAWLER.


N^o 1159

SCALE 1/4" = 1 FT.

PILLARING TO SUIT ARRANGEMENT &
TO SURVEYORS SATISFACTION.
BULKHEADS STIFFENED TO SURVEYORS SATISFACTION.

TRAWL WINCH SUPPORTED
TO SURVEYORS SATISFACTION.

STEAM WINDLASS SUPPORTED
TO SURVEYORS SATISFACTION.

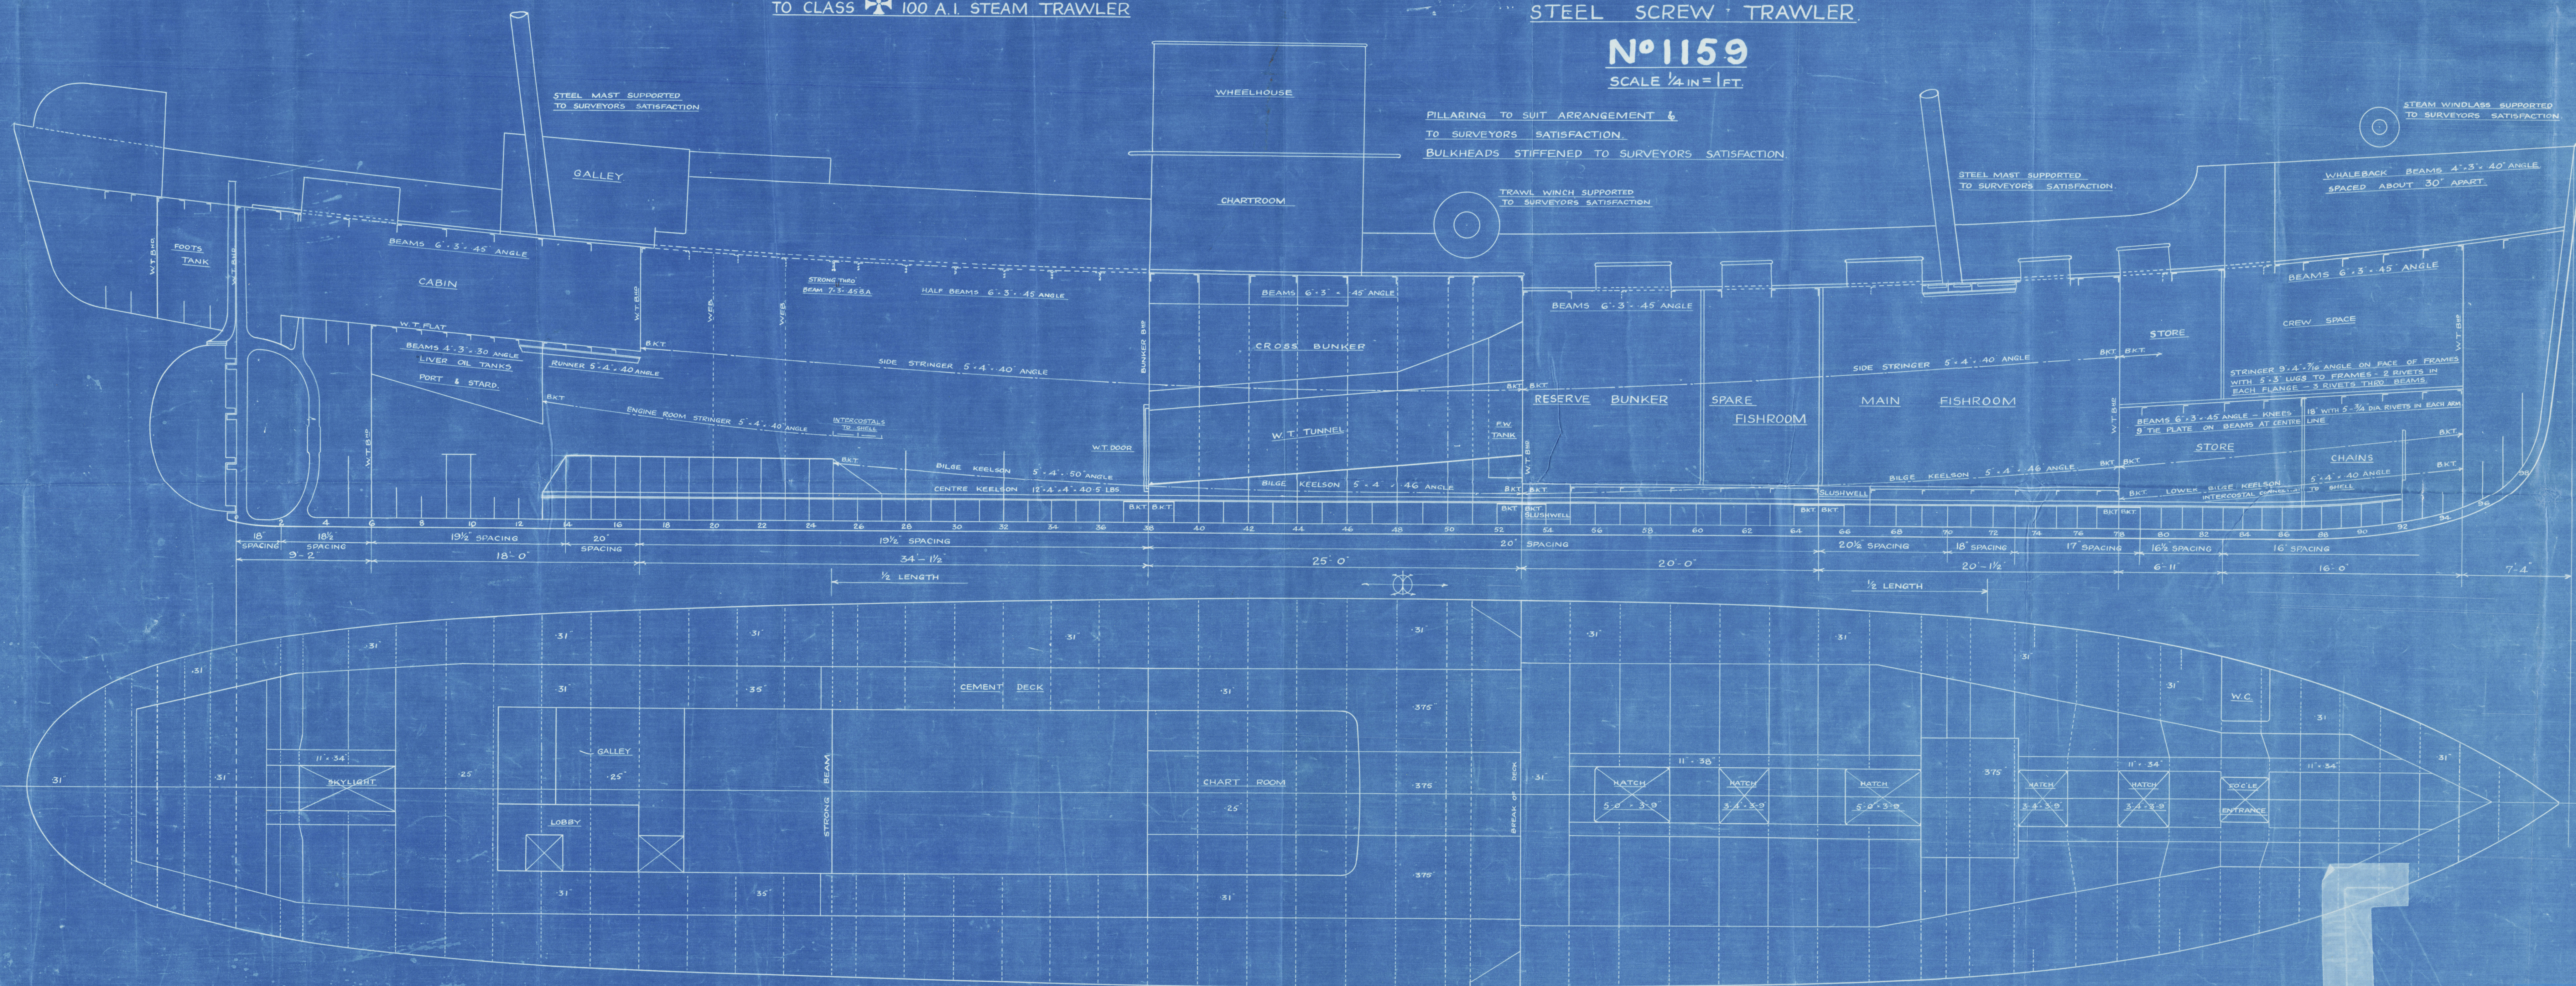

N. 7159

Profile Litch

(as brief)

Cochraner Sans ha.


RENEVA X₇

S.S.

Kirkella

HULL REPORT No.

47007

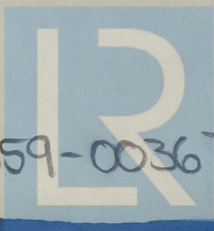

© 2020

003659-003670-0099

Lloyd's Register
Foundation

PLAN No. 4498
FOR ENCLOSURE TO
Lloyd's Register of Shipping
Hull FROM
COCHRANE & SONS, LTD.
SHIPBUILDERS, SELBY.
DATE 25/6/36



003659-003670-0099



© 2020

Lloyd's Register
Foundation