

MIDSHIP SECTION

OIL TANKER

460'0" x 59'0" M⁴⁰ x 34'0" M⁴⁰

CLASS LLOYDS 100.A.I. CARRYING PETROLEUM IN BULK

$\frac{1}{2}$ " SCALE


LONGITUDINAL FRAMING AT BOTTOM AND DECK

CURCHILL & WATSON
BEVIS MARKS HOUSE
BEVIS MARKS
LONDON. E.C.3.

Midship Section


- Yard No. 54 -

Messrs. Odense Staalshitsværft

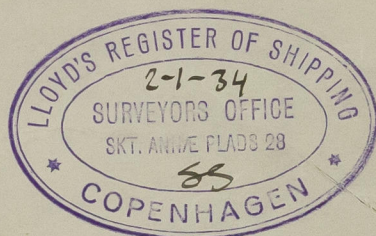

M/s. "Penna"

Gen. Dept. No. 9570.

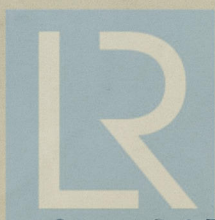

© 2020

Lloyd's Register
Foundation

003659-003670-0117