

# STERNFRAME N<sup>OS</sup> 578-9-80 & 81.

SCALE  $\frac{3}{4}$ " = 1 FOOT.

6-1-9-33 N<sup>o</sup> 582.  
6-9-33 N<sup>o</sup> 587.  
6-12-33 N<sup>o</sup> 590.


HOLES PITCHED  $1\frac{3}{4}$ " & 2" FROM INNER EDGE OF POST  
HOLES DRILLED FOR 1" DIA RIVETS 5 DIAS APART

MATERIAL TO BE FORGED SCRAP STEEL


*Inner Head stated by memo the only under 8" to be 6" rev.*

## TOP & MIDDLE GUDGEON



SCALE 3" = 1 FOOT.

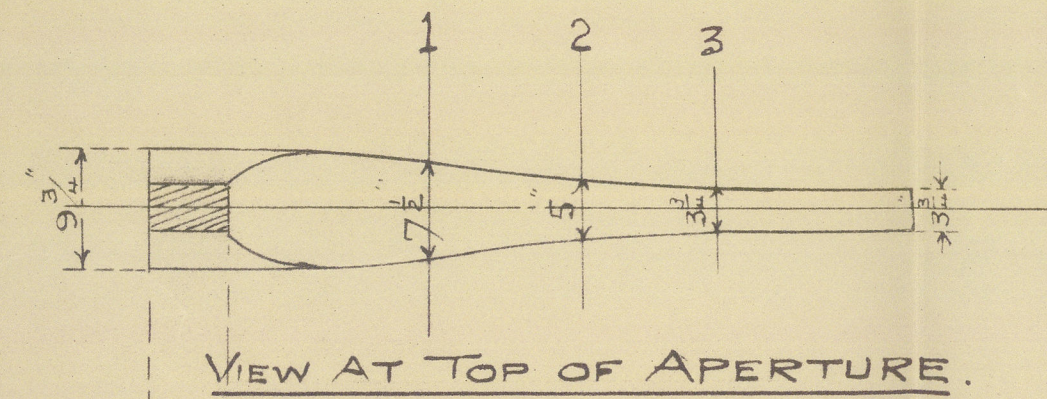

VIEW AT TOP OF APERTURE.

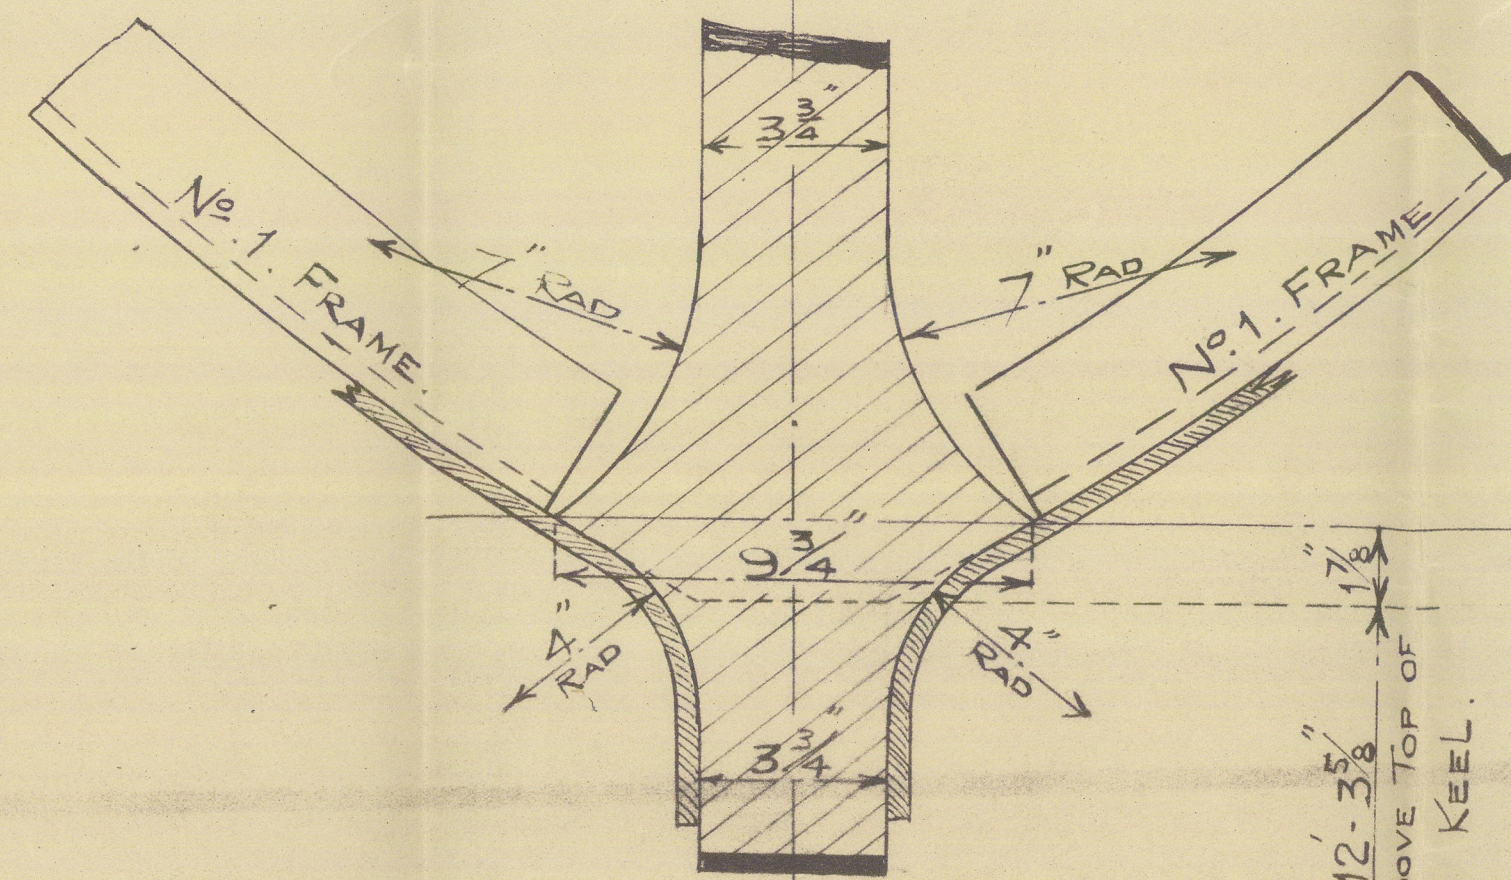


SECTION AT FORE EDGE OF POST.

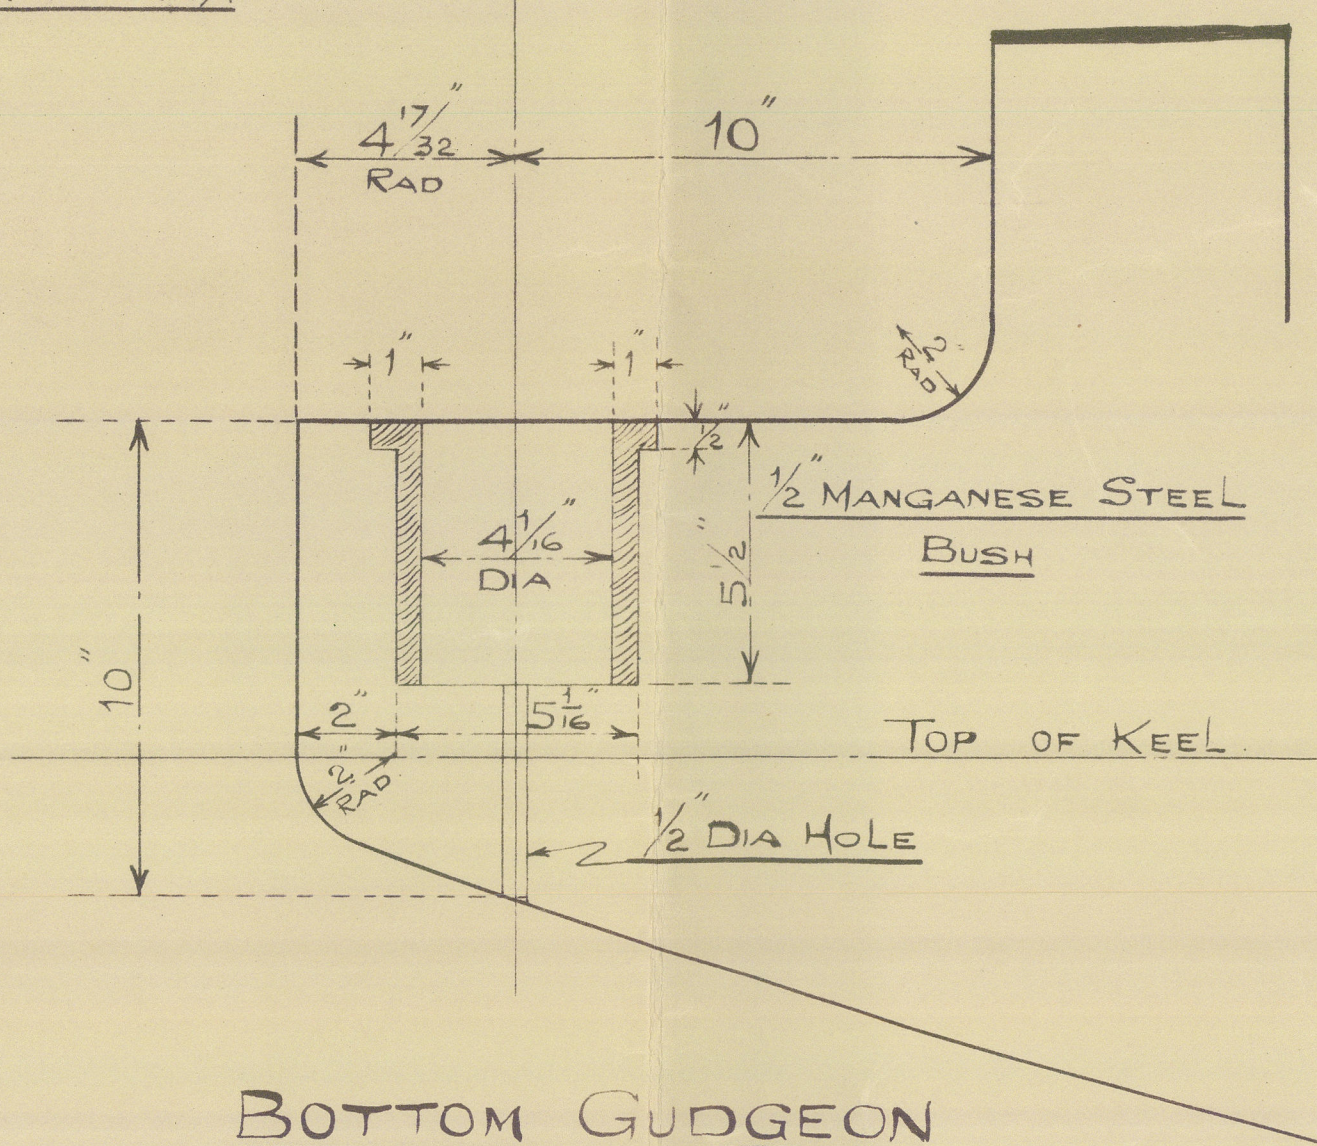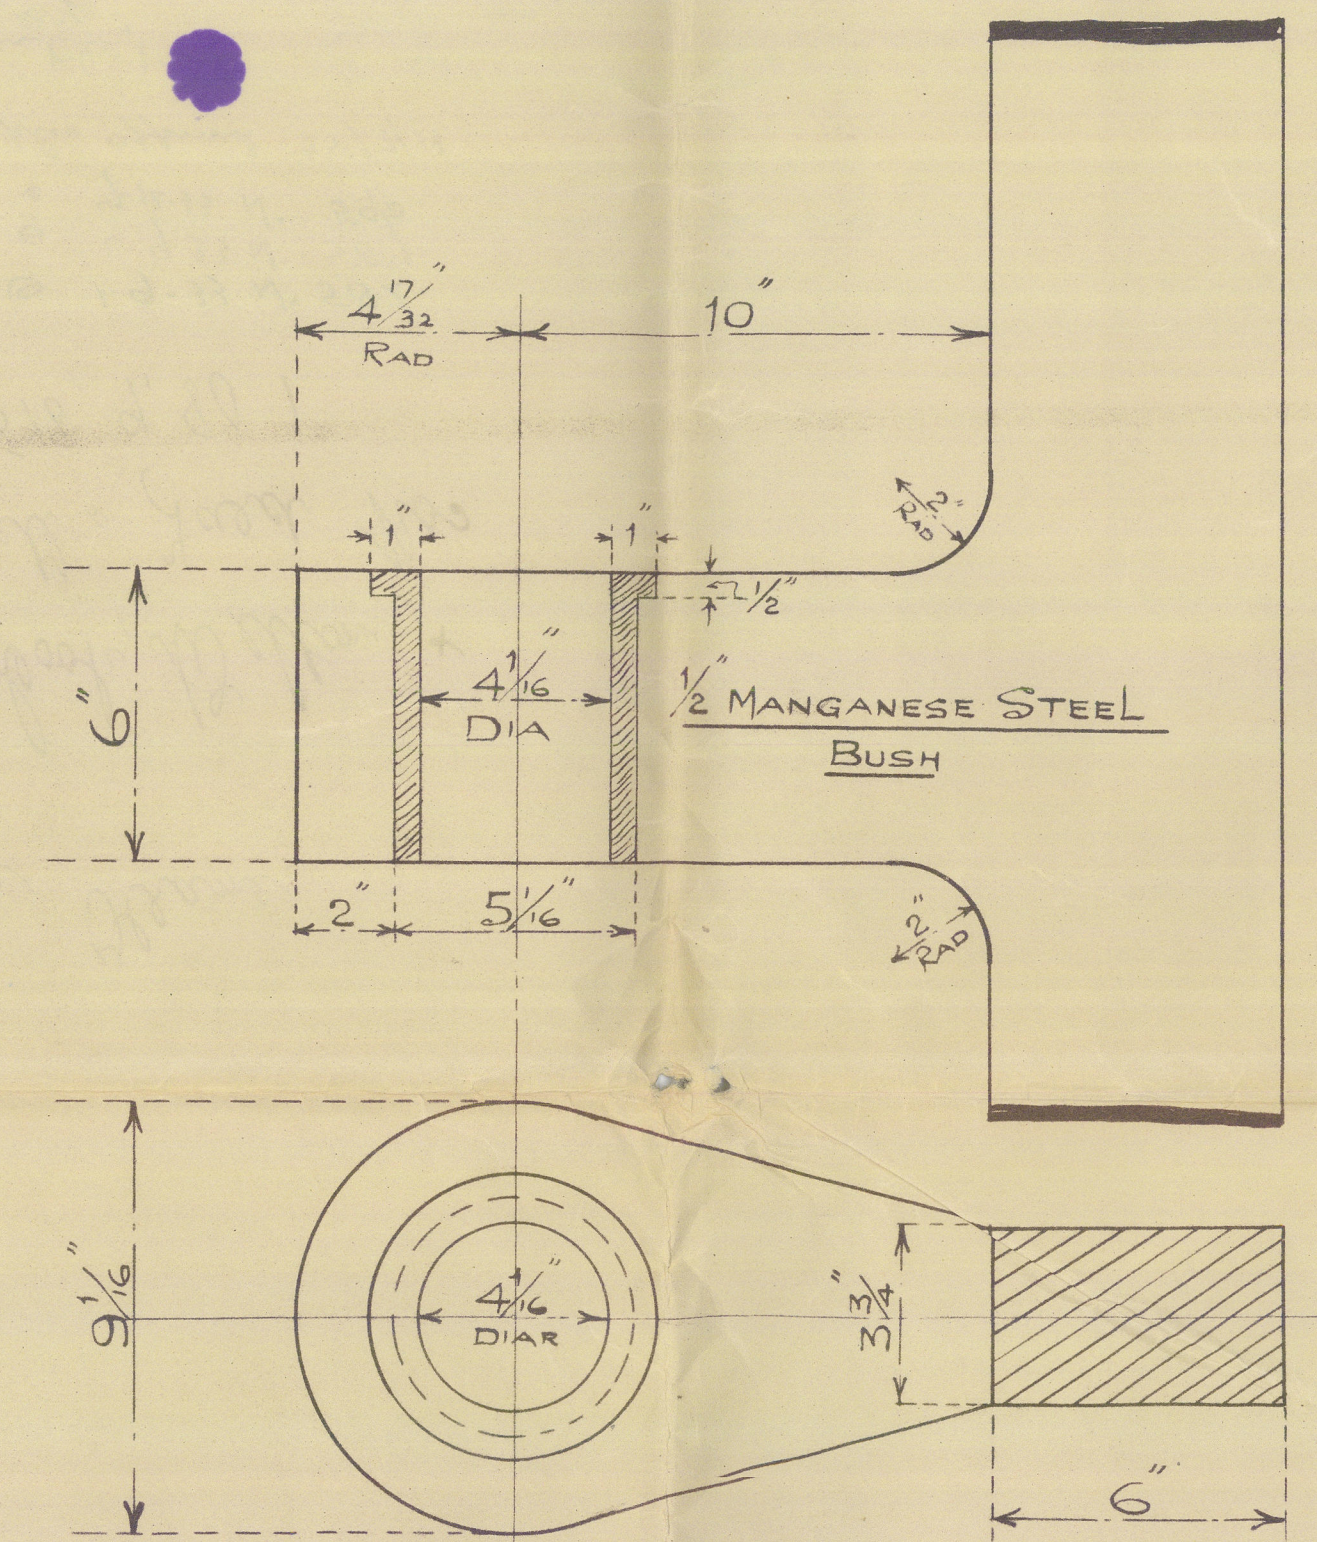

BOTTOM GUDGEON

COOK WELTON & GEMMELL LTD  
SHIPBUILDERS  
BEVERLEY.

APPROVED BY LLOYDS.

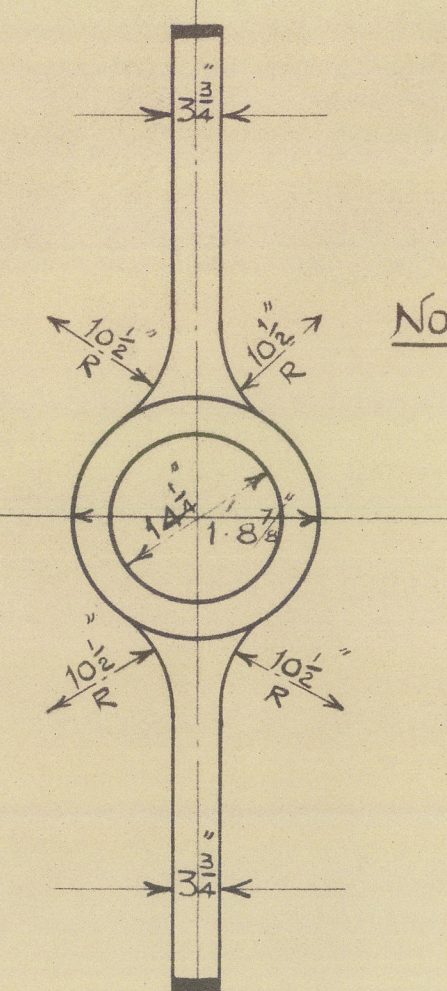


NOTE - HOLE BORED EXACTLY TO SIZE GIVEN VIZ - 14 1/4"

N.B. CENTRE OF BOSS SLOPES SLIGHTLY TO KEEL.

"OERTZ" PATENT RUDDER TO BE FITTED  
SEPARATE PLAN SUBMITTED.

STERN POST GUDGEONS TO BE FACED.

TOP OF KEEL.

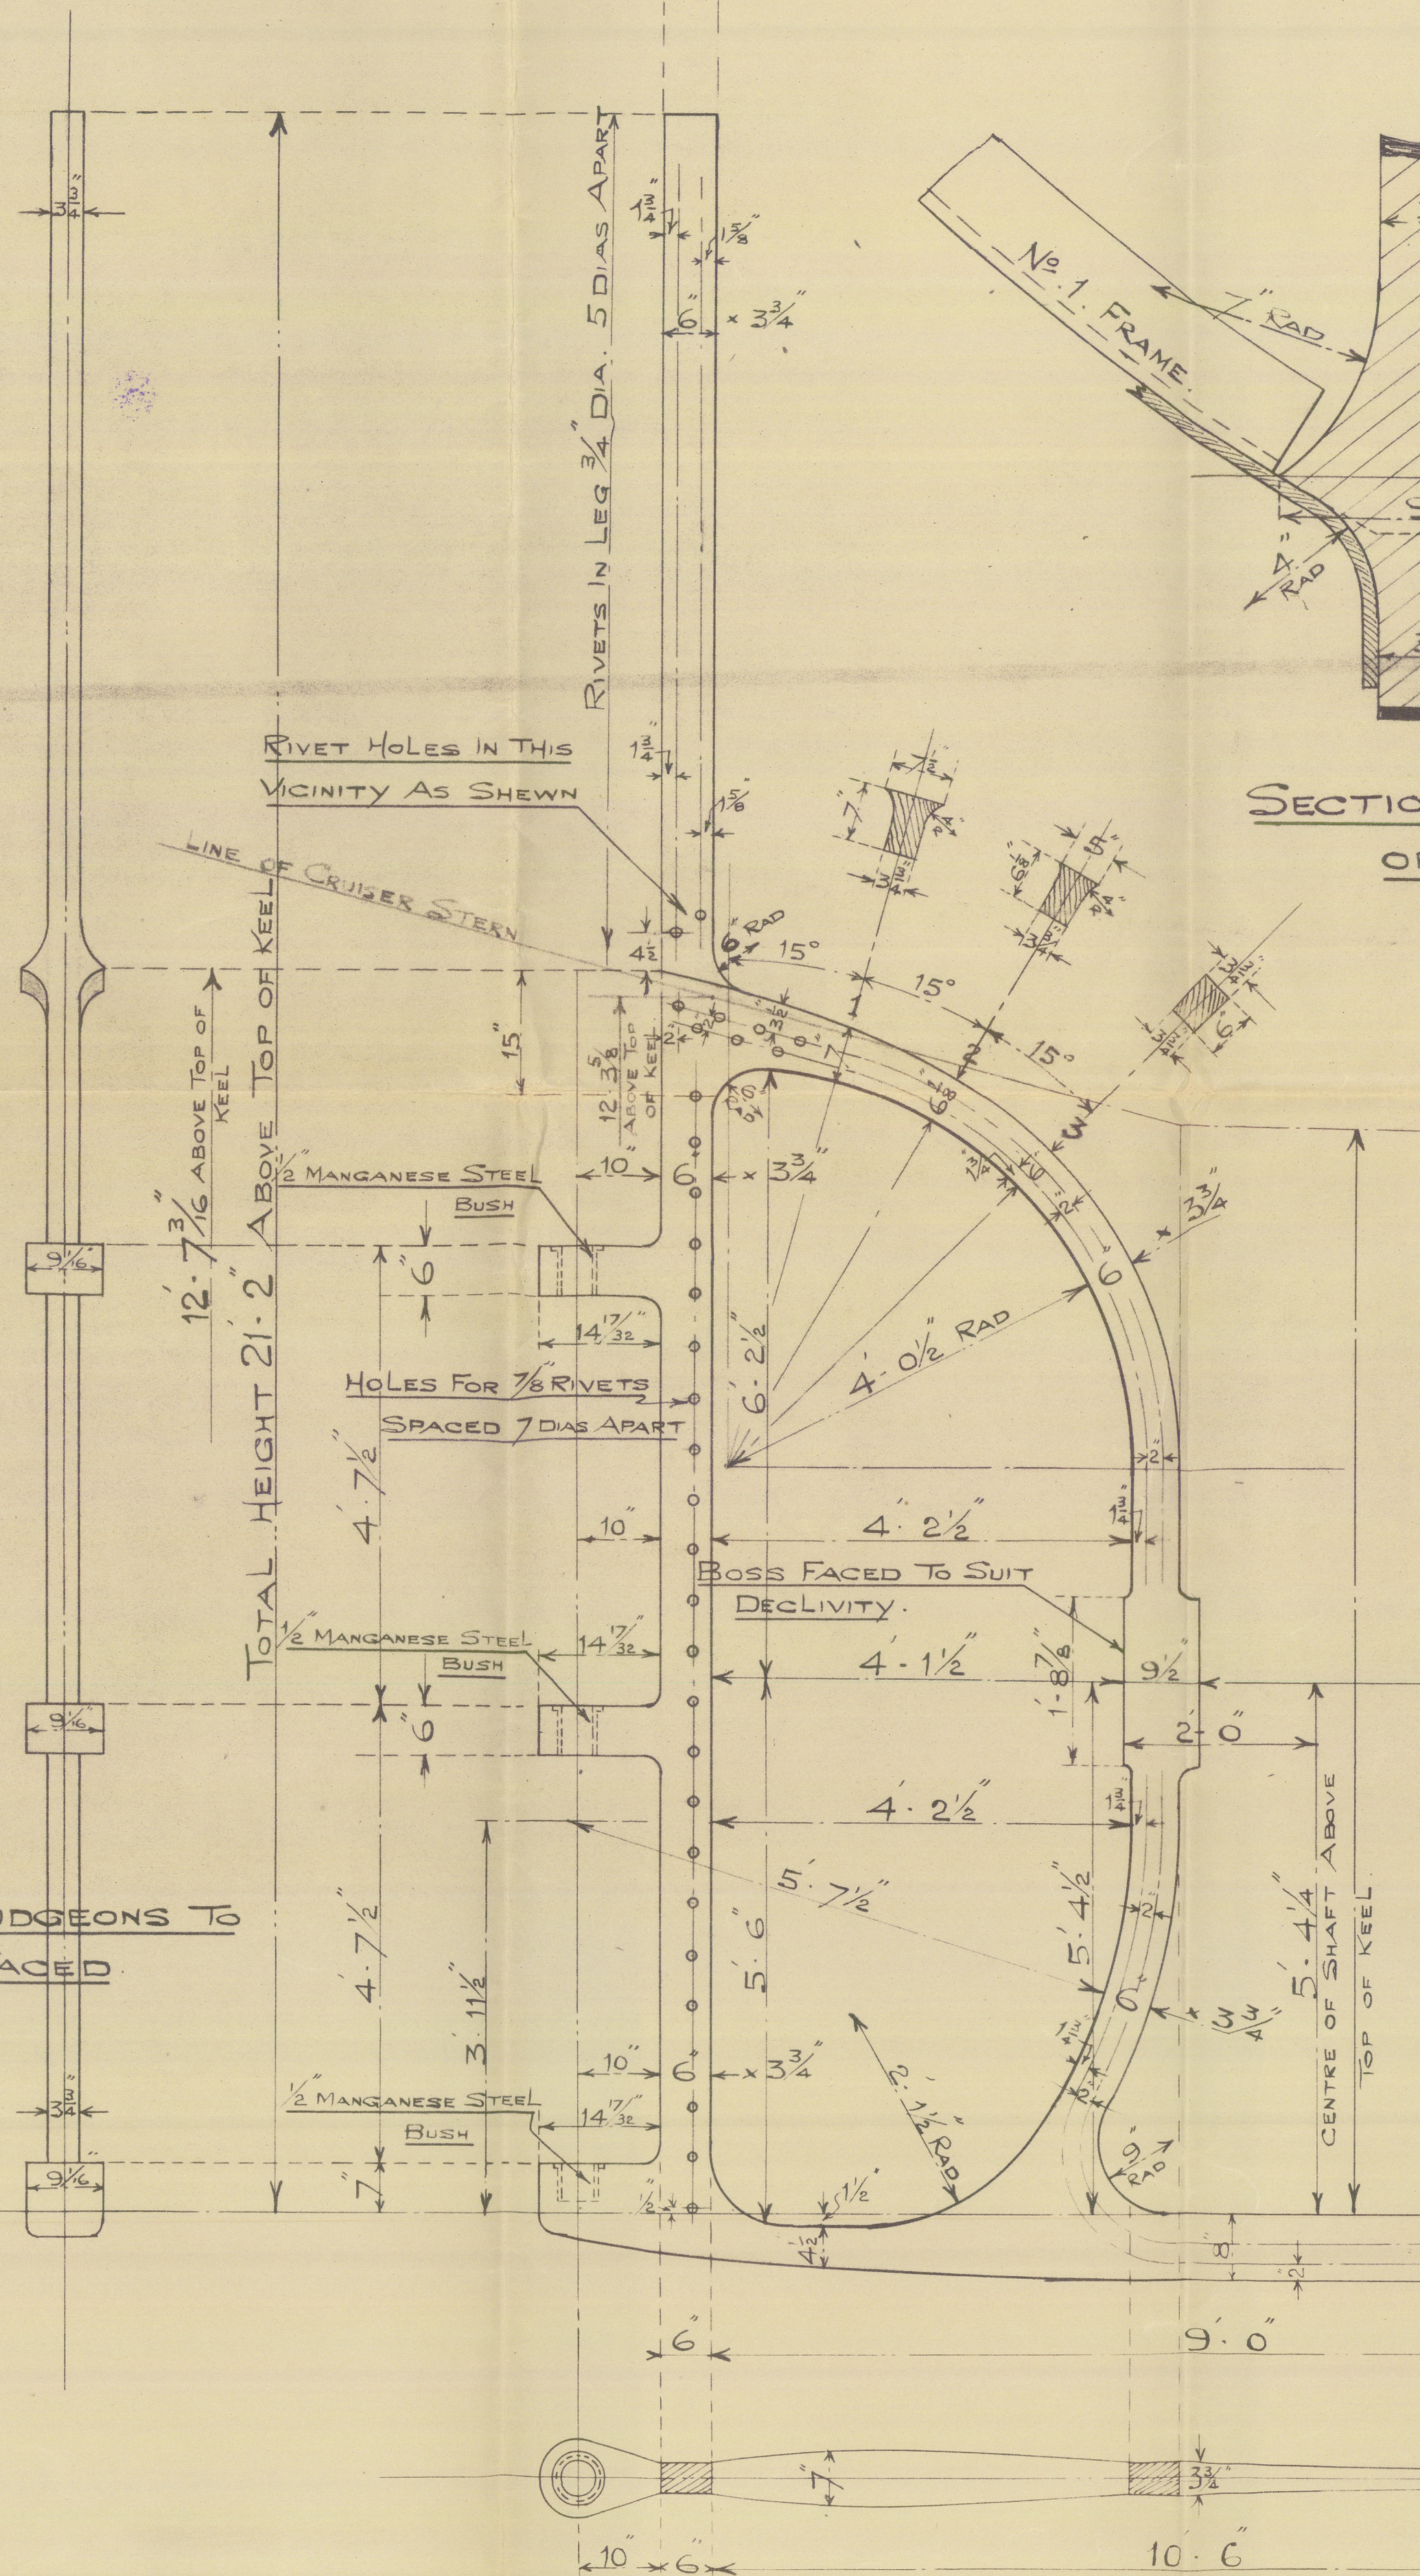

7. 7. 33

© 2020



Steen Krame.

Messrs. Cook, Welton +  
Gemmell's Yard Nos  
578, 9, 80, 1.

⑥ 1-9-33 N° 582.  
⑥ 6-9-33 N° 587.  
• 7-12-33 N° 590

See later plus appended 25/7/33.

Red Gauntlet<sup>ex</sup>

578 Arab

579 "Lorenzo"

580 "Picador"

581 "Baque"

582 "Loch Leafort"

587 "Dervish"

590 "Brontis"

27/5 526

Transferred to Reptonian



© 2020

Lloyd's Register  
Foundation

003671-003678-0003