

18.8.33

6.19.33 N° 582.
6.6.33 N° 587.
6.7.11.33 N° 590

SCANTLING IN CRUISER STERN /
FRAMES 4" x 3" x 40 SPACED 21" APART 18 BEAM KNEES
FORE & AFT BEAMS 4" x 3" x 40 SKTD TO SHELL 12 KNEES
FLOOR PLATES 34" REV. FRAMES 3" x 3" x 34
3/4" INTERCOSTALS SINGLE LUGS TO FLOORS (CONNECTED TO SHELL)

STEEL MIZZEN MAST
SUPPORTED TO SURVEYORS
SATISFACTION

1 SPECIAL FIXED LIGHTS IN BHD 12' BELOW
DECK WT GUNMETAL FRAMES 3/8" THICK
SUITABLY FITTED WITH 1 ARMOUR PLATE GLASS

WHEELHOUSE

CHARTROOM

PROFILE & DECKS.

N° 578-9-80-81

N° 582.
N° 587.

DIMENSIONS 154' 0" B.P. x 25' 6" B.M.D. x 14' 9" D.M.D.


SCALE 1/4" = 1 FOOT

WINCH DECK SUPPORTED BY
8 3 DIA SOLID PILLARS

PPINE FOREMAST
SUPPORTED TO
SURVEYORS SATISFACTION


WHALEBACK

PLATING 31
STIFFERS 4" x 3" x 40 SPACED 30" APART
& BRACKETED TO DECK

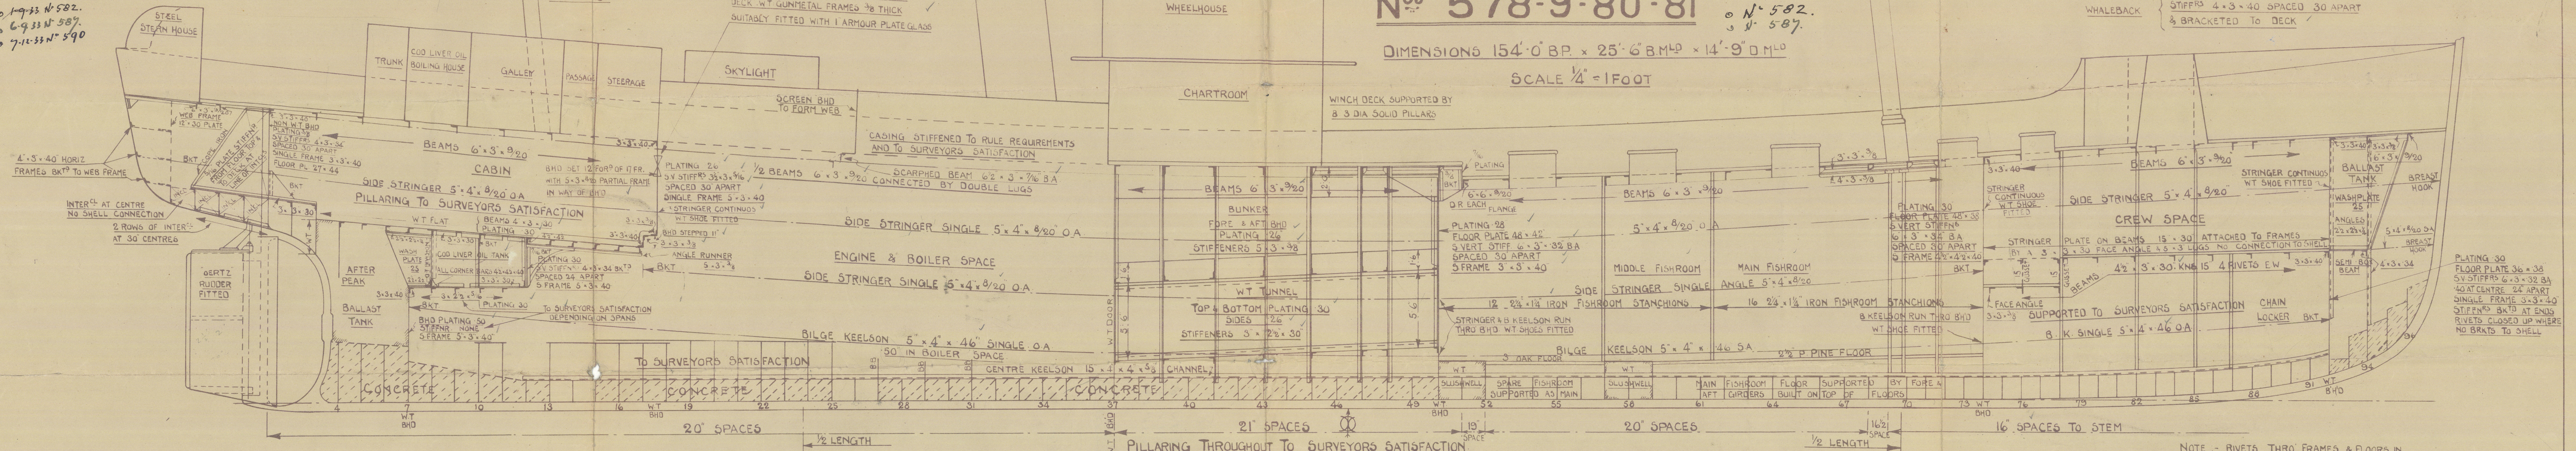

PLATING 30
FLOOR PLATE 36" x 38"
5V STIFFERS 6" x 3" x 32 BA
40" AT CENTRE 24" APART
SINGLE FRAME 3" x 3" x 40
STIFFERS BKT'D AT ENDS
NO BRKTS TO SHELL

NOTE - RIVETS THRO' FRAMES & FLOORS IN
WAY OF GARBOARD & 2 ADJOINING
STRAKES FORD OF 68 FT. TO BE 4" APART

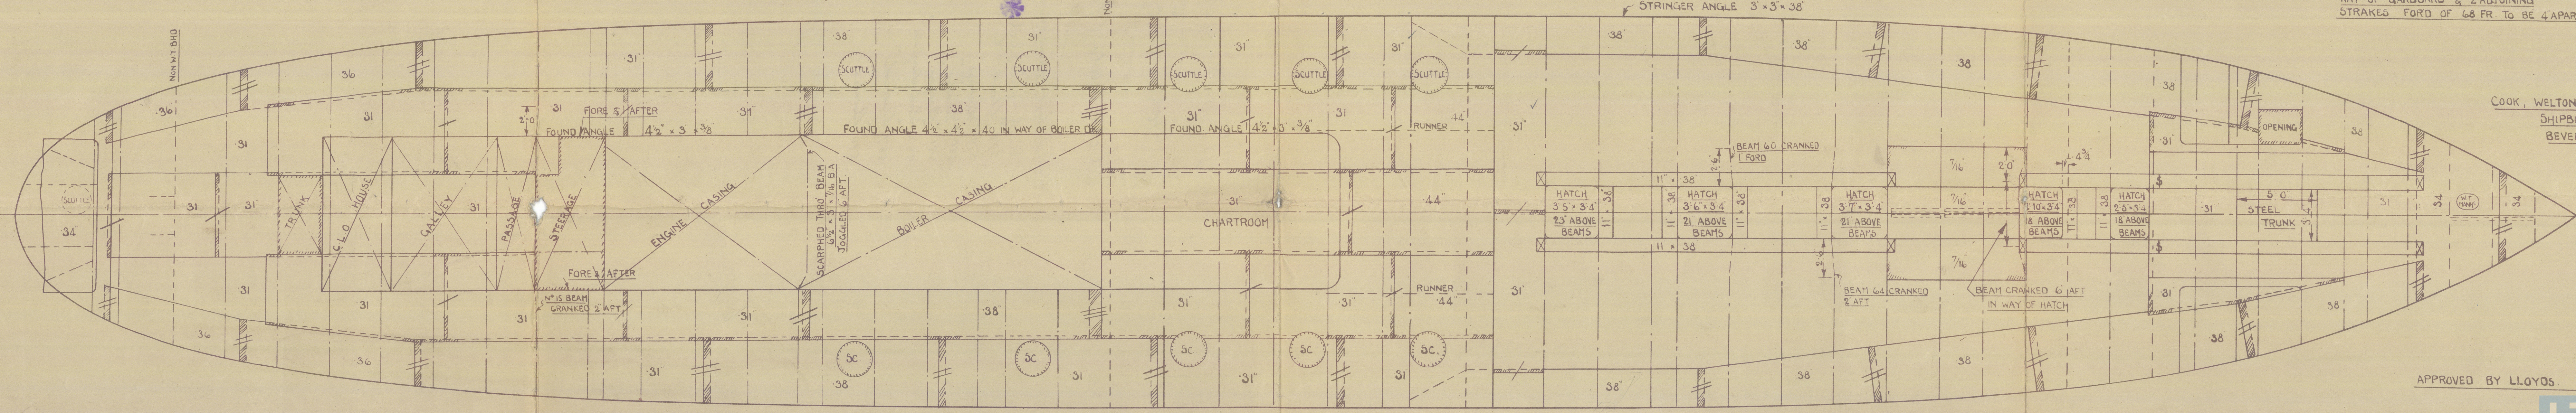

COOK, WELTON & GEMMELL LTD
SHIPBUILDERS
BEVERLEY

W.J.
18.8.33.

APPROVED BY LLOYDS

18/8/33

N^o 578-9-80-81

Profile & Deck


6 1-9.33 N^o 582.

6 6-9.33 N^o 587.

6 7.12.33 N^o 590

Cook, Walter Pennell L.

Kindly Latest approved plan 18/8/33.

Red Gauntlet 

578 "Arab" ex

579 "Lorenzo"

580 "Picador"

581 "Basque"

582 "Loch Seaforth"

587 "Derrish"

590 "Brontis" ✓

Transferred to Reptonian

D. 144

JJ class

WS 526



© 2020

Lloyd's Register
Foundation

003671-003678-0007