

S. S. N° 504-8.



385-0 B.P. x 53-9 Ext. x 26-0 1/4 MLO.

SCALE 1/8" = 1 FOOT.

SHELTER & UPPER DECK
RESERVE BUNKER HATCHES 10-7 1/2 - 16-0
END & SIDE COAMINGS .36
1 CENTRE FORE & AFTER 11-56 BULB 62 ANGLES
2 SIDE " 8-3-1/4 L.B.A.

N°s 1, 2, 4, 8, 5.
SHELTER DECK HATCHES 25-6-16-0
SIDE COAMINGS .50 END COAMINGS .40
4 HATCH WEBS 19 TO 14 x 3/4
2-3-3-1/2 ANGLES ON UPPER & LOWER EDGES
WEBS TO BE INCREASED 3 IN LIEU OF BRACKETS.

N°s 1, 2, 4, 8, 5.
UPPER DECK HATCHES 25-6-16-0
SIDE COAMINGS .50 END COAMINGS .40
4 HATCH WEBS 19 TO 14 x 3/4
2-3-3-1/2 ANGLES ON UPPER & LOWER EDGES
6-6-1/2 SINGLE LUGS 5 RIVETS

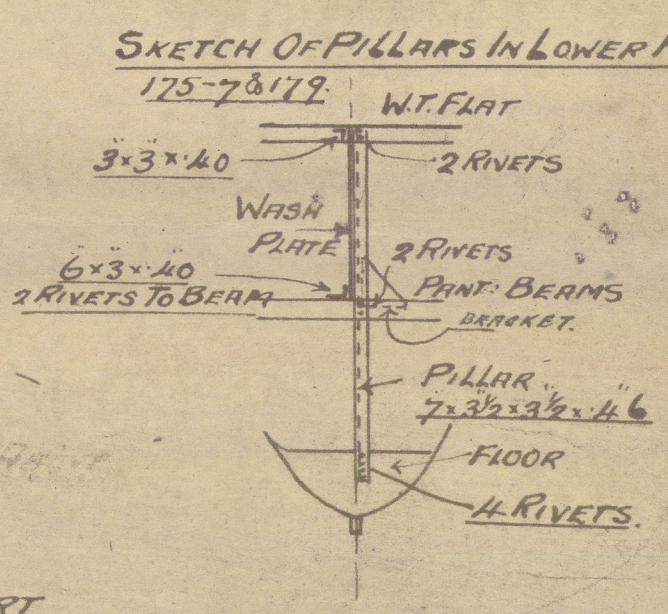 

J. L. Thompson
+ Sons

Profile

⁴ as built ⁴

No. 504
N. N. RAZMANSO*
s/s Nordie

S.L.O. Rpt. No. 26237

no 508
s/s 'Sydie'

RECORDS DEPT.
LONDON.



© 2020

Lloyd's Register
Foundation

003679-003676-0032