

Lloyd's Register of Shipping.

(Report on Vessel No. 15050 Port Middlebro)

No. SHIP FORGINGS OR CASTINGS.

I have to report that the undermentioned Iron or Steel Forgings or Castings, manufactured by Y. S. Foster & Co. Ltd. of Sunderland for the Vessel No. 963, being built by Messrs Smith, Dock Ltd. of South Bank Middlebro have been inspected by me as set forth below and found to be, so far as can be seen, sound

to be struck out as may be required.

work on Forgings or Castings.


Lloyd's
No. 4009
W.F. 19.9.33

J. T. Hasw.
Sunderland

	STERN FRAME.	RUDDER FRAME.	STEM.
Material*	<u>Scrap iron</u>		
How made	<u>Forged & smithed</u>		
annealed			
Dimensions	<u>5" x 5 3/4"</u>		
Progress on Inspection	<u>Forging & smithing</u>		
Date when Inspected	<u>18 & 19. 9. 33.</u>		
CASTINGS.			
Tests on Standard Test Pieces.			
Tensile Test—			
Tons per square inch			
Extension per cent.			
3rd Bending Test—			
Angle before fracture			
Proof Test—			
Height from ground			
Numbering Test—			
If made according to Rules and found satisfactory			

Settled in 965

SKETCHES OF FRAMES SHOWING POSITION AND DESCRIPTION OF WELDS OF FORGINGS.

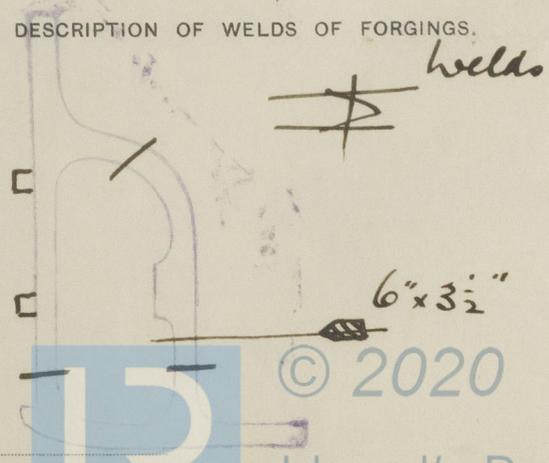

Fee (if any chargeable) £

To be paid at

If of Iron, state whether scrap or puddled Iron. If of Steel, state whether made on the Open Hearth process.

