


Lloyd's Register
Foundation

Mt. Burmeister & Wain,
Copenhagen.

Newbuilding Yard No. 555

Sternframe & Rudder

Correct Plan. M/S "YANDRA"
Joh. of Port Adelaide.
989 Tons Gross.

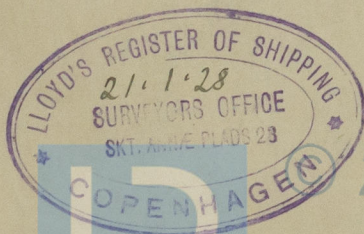

Copenhagen Report No. 7808

003679-003686-0062

Lloyd's Register
Foundation