


Corpo vessel
BUQUE DE CARGA "RIA DE EL FERROL"
 EX-PORTO
 of DE 3000 TNS. DE PESO MUERTO dead weight
 ESCALA 1:100

CARACTERÍSTICAS PRINCIPALES

ESLORA PA	50.00	<i>See the modified breadth</i>
PUNTA DE TRAZADO	12.24	
PUNTA	5.37	<i>See the breadth</i>
CALADO	5.50	<i>Brought</i>

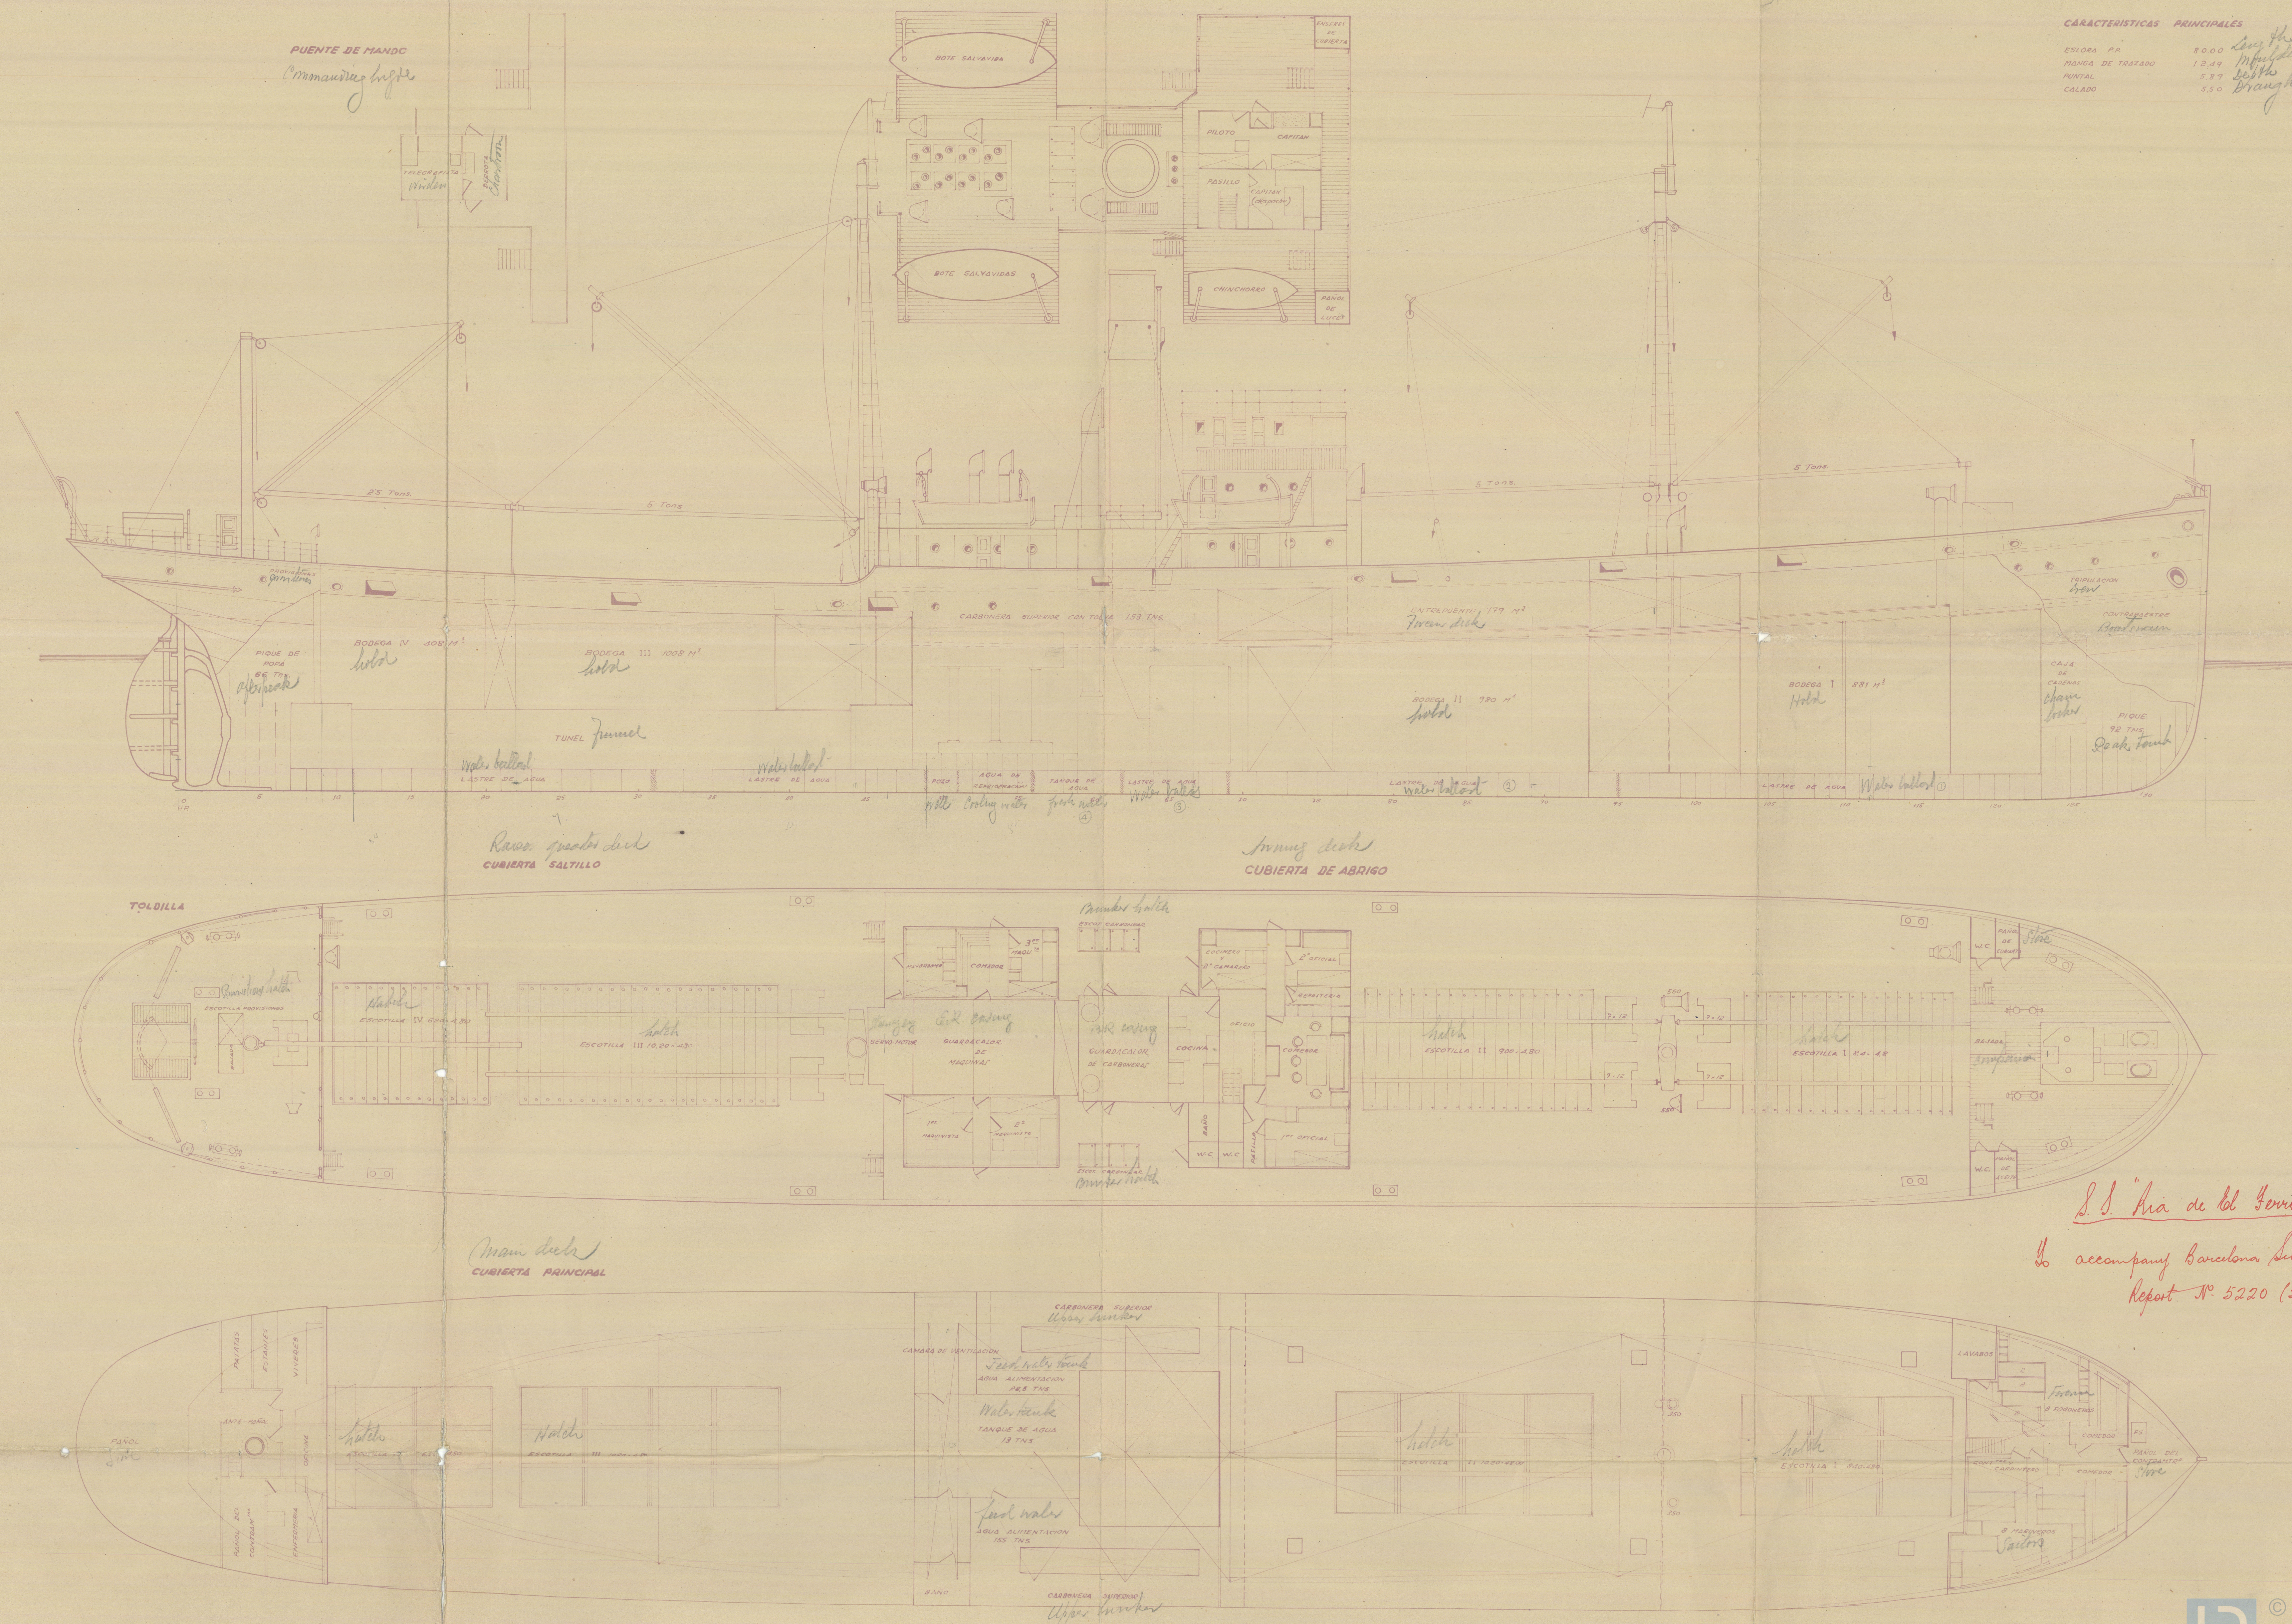


S. S. "Ria de El Ferrol"

to accompany Barcelona Surveyor's Report N° 5220 (5/107)

"RIA DE EL FERROL" ★

General arr.

RECORDS DEPT.,
LONDON

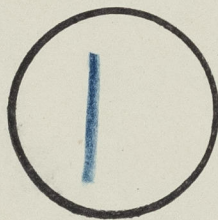

003679-003686-0171



© 2020

Lloyd's Register
Foundation