


Office

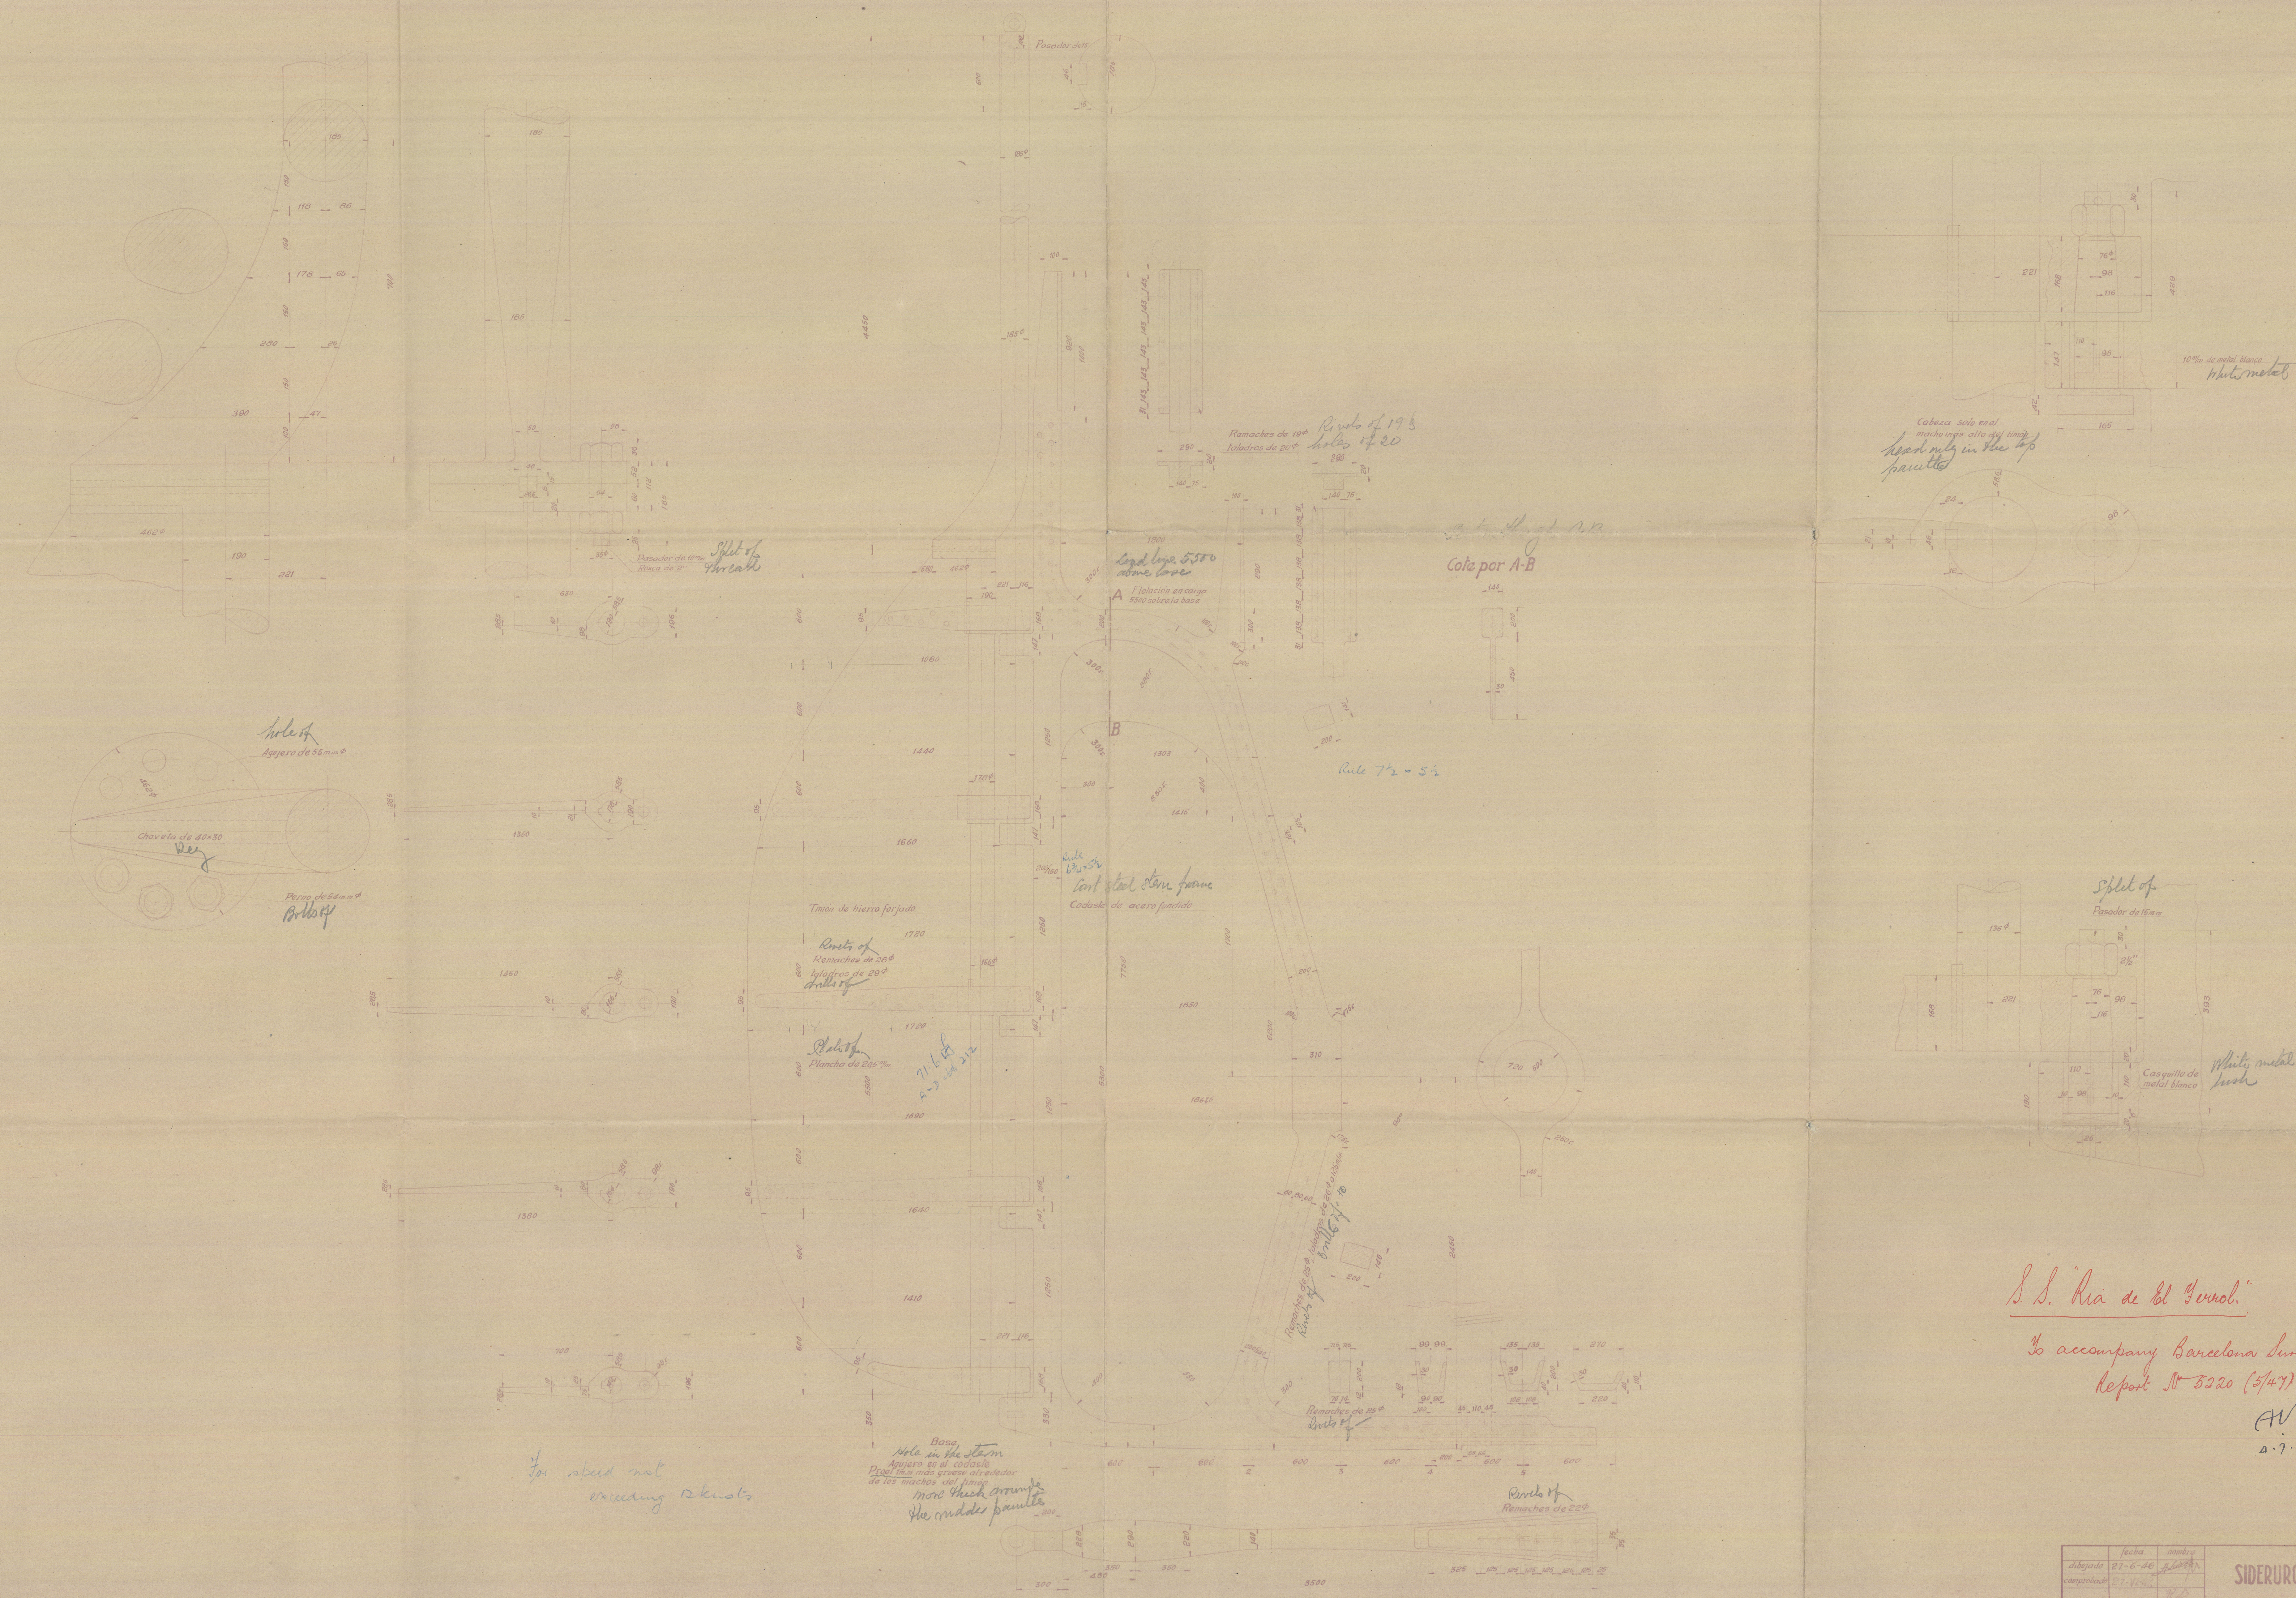

S.S. "Ria de El Ferrol"  
To accompany Barcelona Surveyors  
Report No 5220 (5/47)  
A. J. A. 7


Office



"RIA DE EH FERROL" ★

*Henframl e rudder*

RECORDS DEPT.,  
LONDON

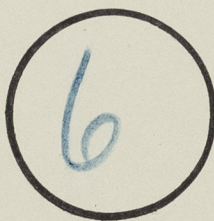

003679-003686-0175



© 2020

Lloyd's Register  
Foundation