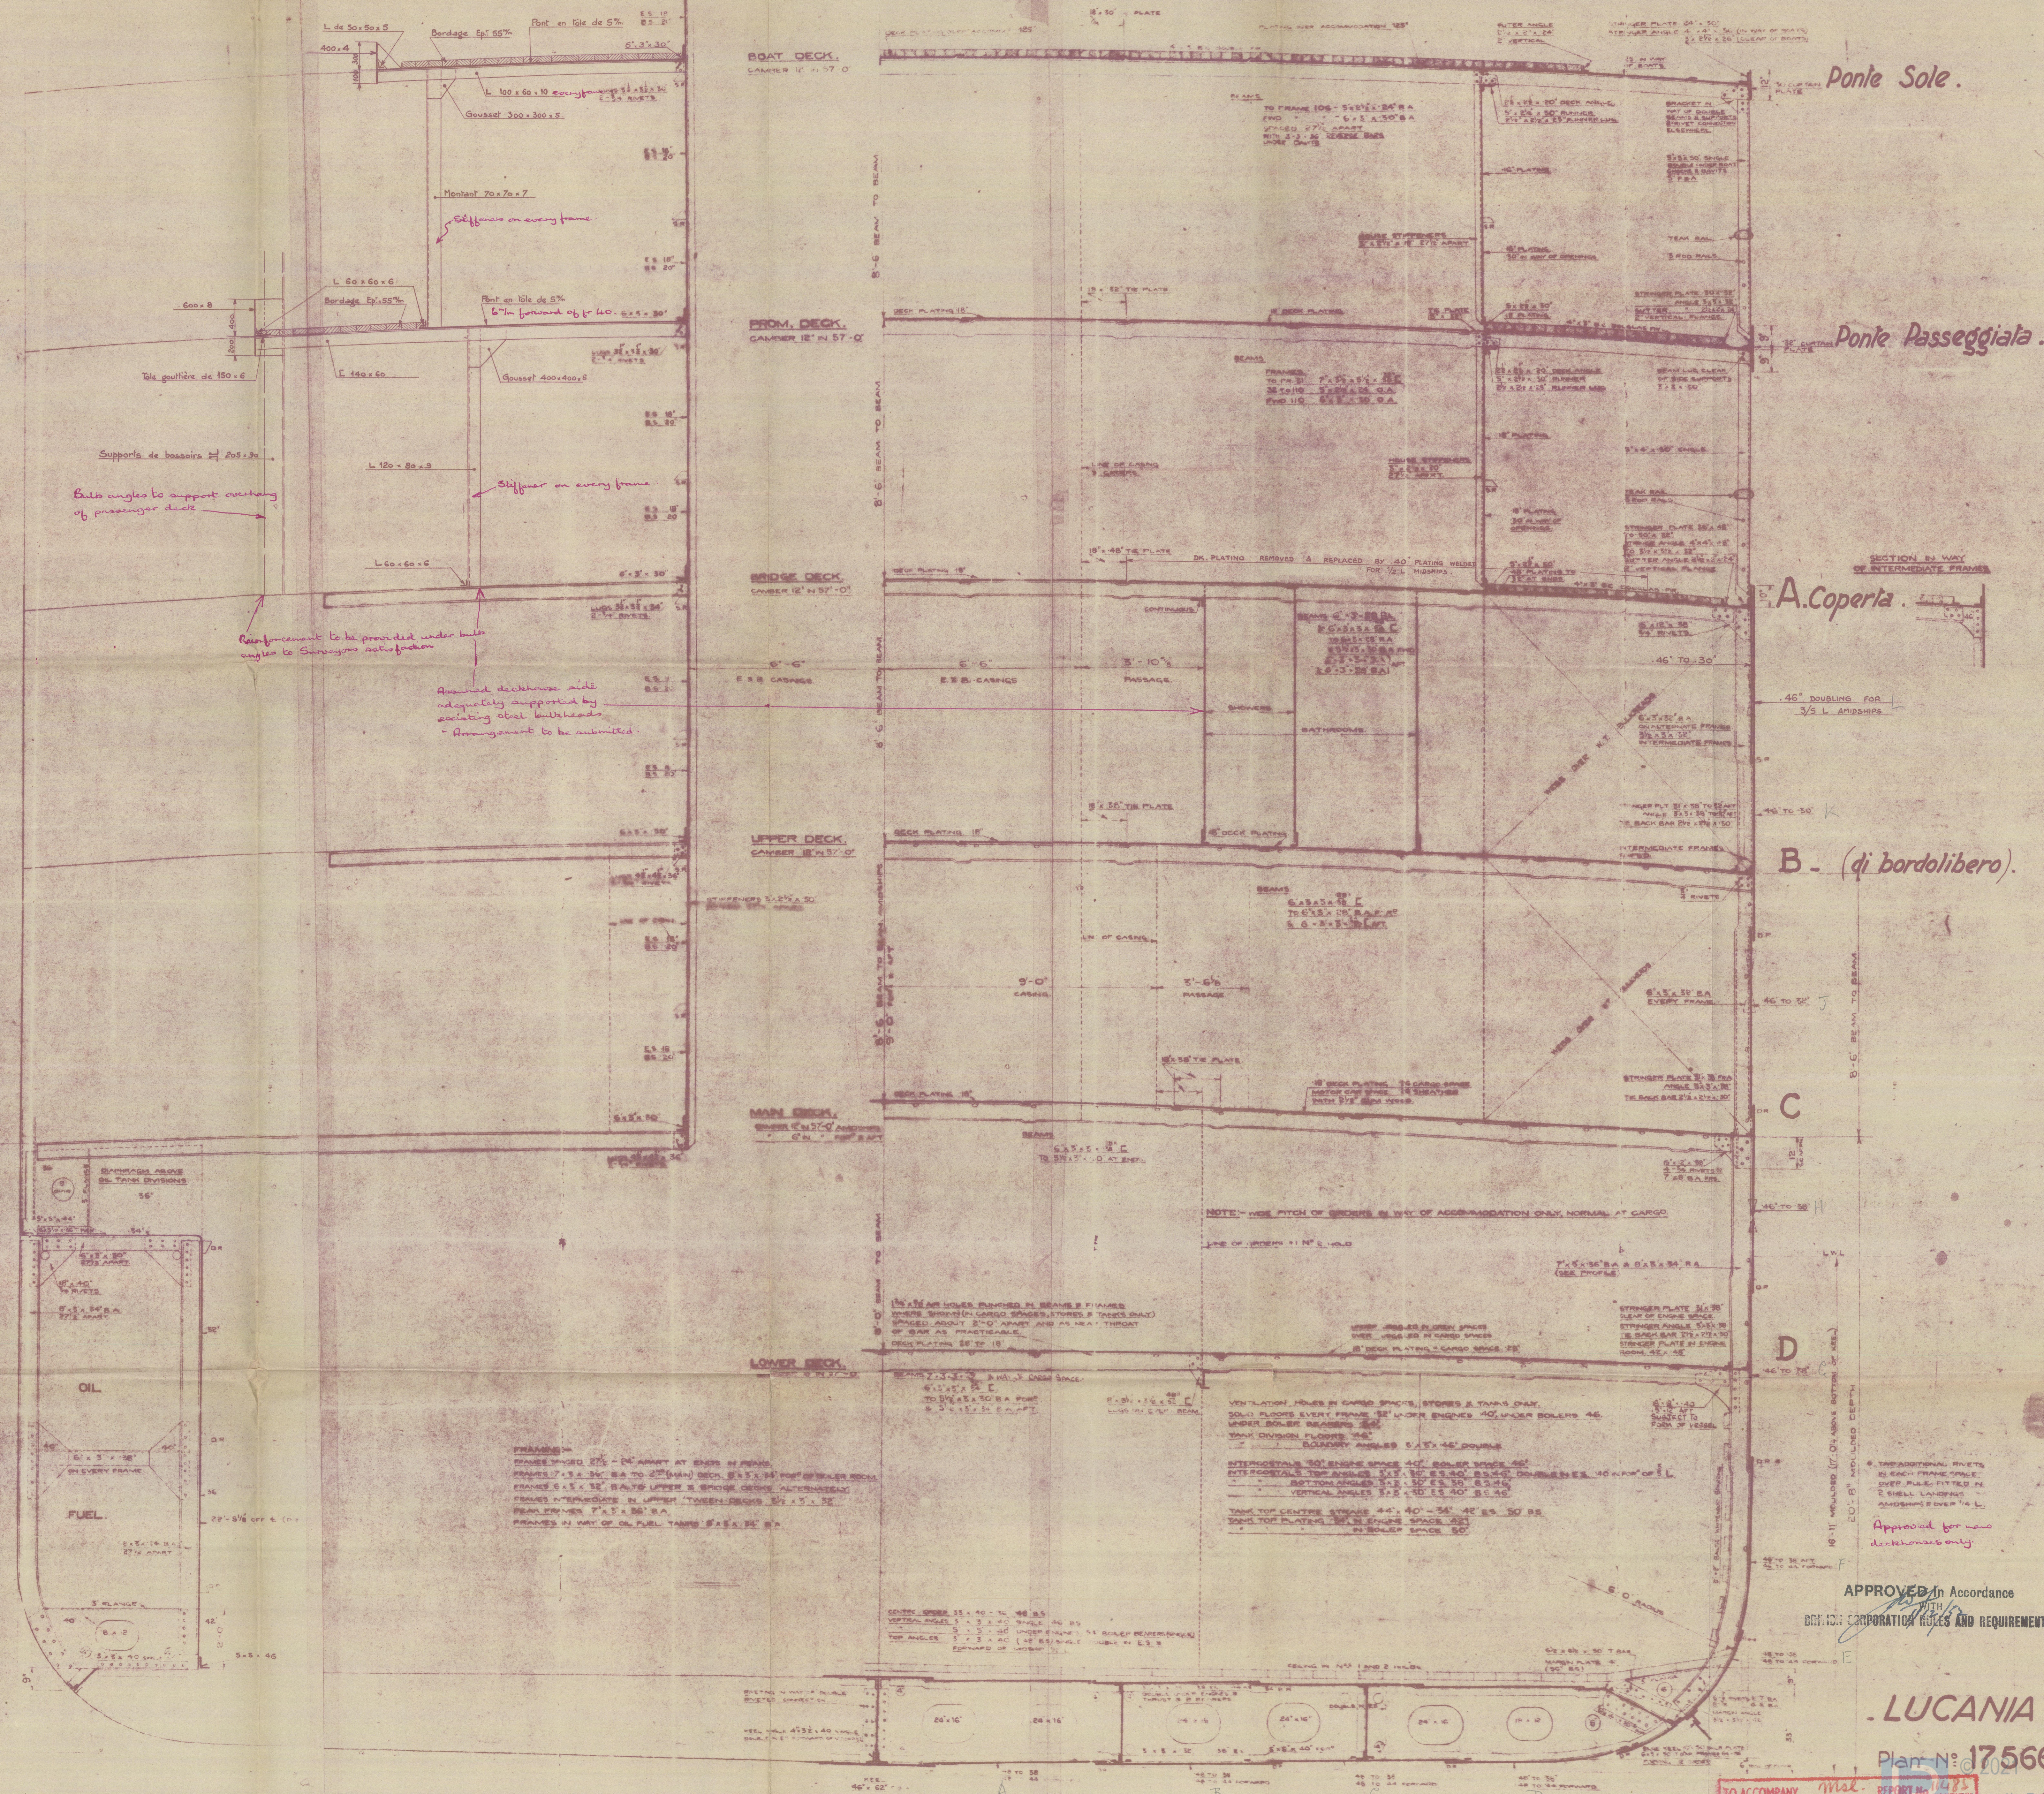


SCALE:- $\frac{1}{2}$ " - ONE FOOT.

[illegible]

APPROVED In Accordance
WITH
NATION CORPORATION RULES AND REQUIREMENTS

LUCANIA.

Plan N° 17566 A


TO ACCOMPANY *Inst.* REPORT No. *11483*
DATED *6/57*
003681-003697-0261

LUCANIA ★

Rpt- No. 11485.

Midships Section

RECORDS DEPT.
LONDON

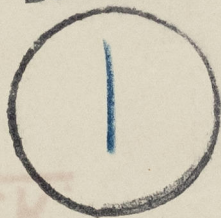

003687-003697-0261



© 2021

Lloyd's Register
Foundation