
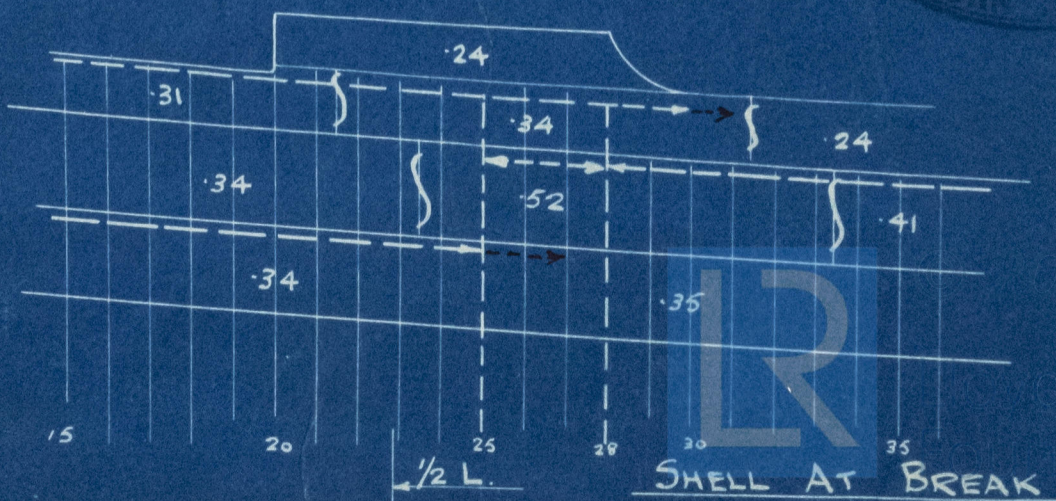
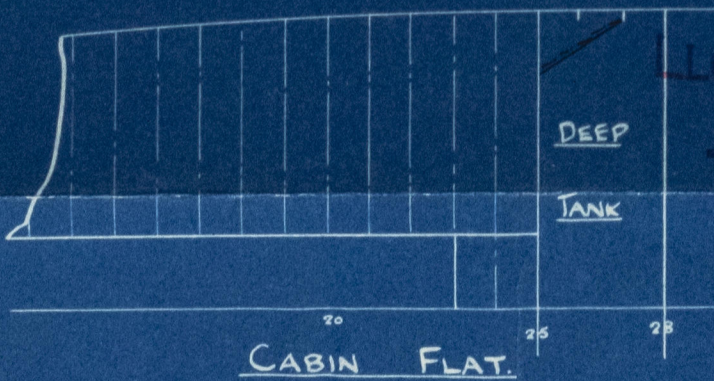
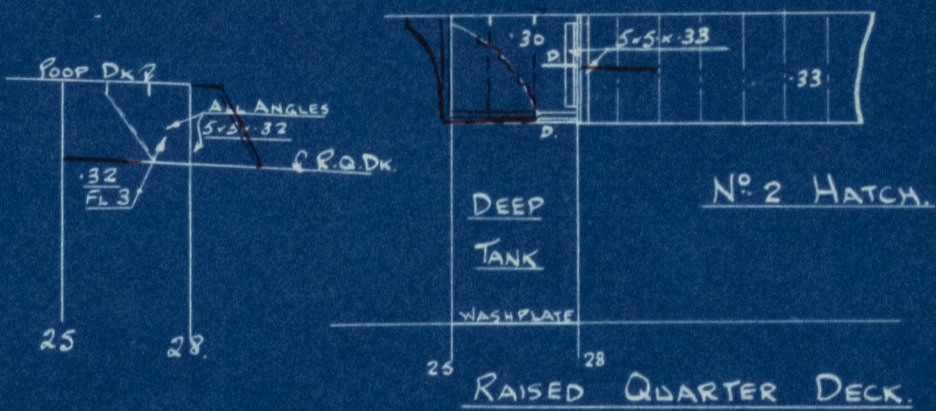


SHIP N^o 228

MODIFICATION - TO PROFILE & DECKS IN WAY OF DEEP TANK.

SCALE:- $\frac{1}{8}" = \text{ONE FOOT.}$

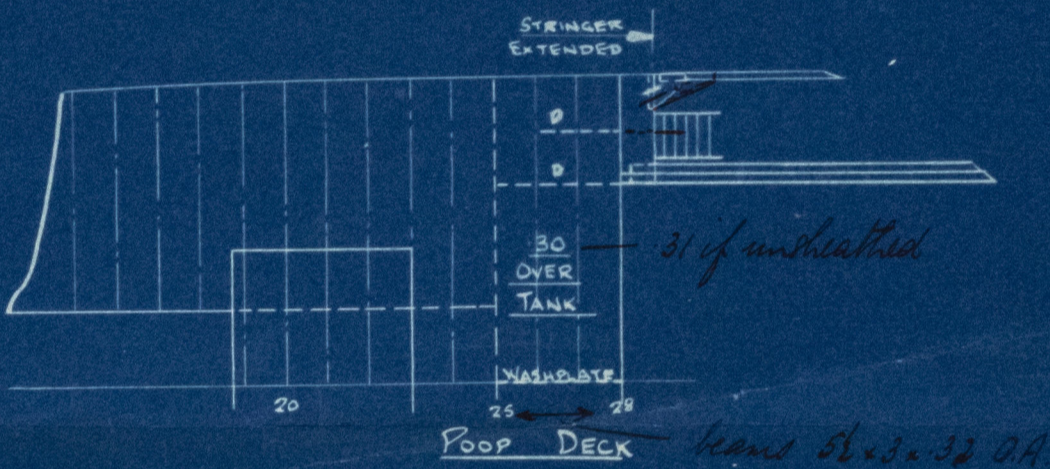

PLAN N° P. 14.

DATE 7/12/86

Danishland SBC: 22
Nº 228, 245.

modification to Profile & Duns
in way of Deep Tank

TRAQUER

M/M. 3700

m.v. "Guernsey Queen"

Lth. Rpt. No. 19840

M.V. "CHANNEL QUEEN"

Leith Report Nº 20178

w/s 853

RETAIN



© 2020

Lloyd's Register
Foundation

003698-003705-0058