


SHIP N^o 228. 245.

AMENDMENT TO PROFILE & DECKS.

HOLD PILLARS ON MIDDLE LINE.

SCALE: - 1/8" = ONE FOOT.

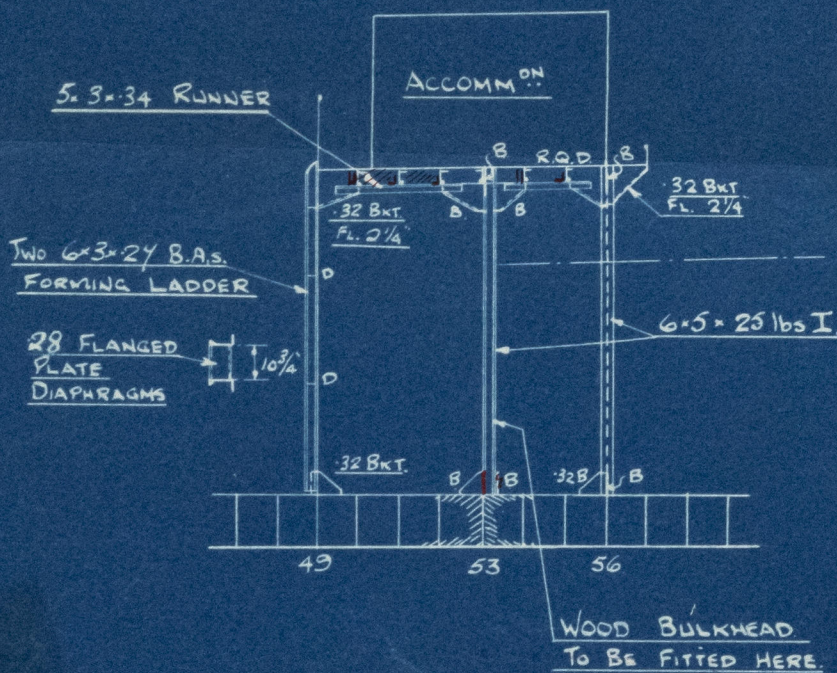

APPROVED for 1/6 245.

LLOYD'S REGISTER OF SHIPPING

R. Duckers

DATE 9/11/39

APPROVED

LLOYD'S REGISTER OF SHIPPING



003698-003705-0059



PLAN N^o P. 13.

Burntisland SBC²
N^o 228, 245.

Amendment to Profile
and Decks.

M/M 3700

TRAQUAIR

m.v. "Guernsey Queen"

Leith Rpt. No. 19840

M.V. CHANNEL QUEEN.

Leith Report N^o 20178

w/s 853

w/AIR

© 2020

Lloyd's Register
Foundation

003698-003705-0059