

### MIDSHIP SECTION

SCALE  $\frac{1}{2}$ " = 1 FOOT.

The Scantlings are submitted on the understanding that they are the minimum acceptable for Class.

Errors & Omissions excepted

[illegible]

FOR EQUIPMENT <sup>D</sup>(AS BELOW) 15514.







BUILDERS. Grangemouth Dockyard Ltd.

YARD NO. 402

PLAN. Midship Section  
as built.

SHIP'S NAME, "Cassard"

GLASGOW REPORT No 39718

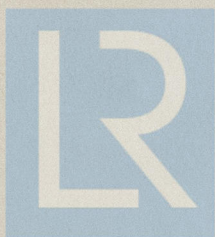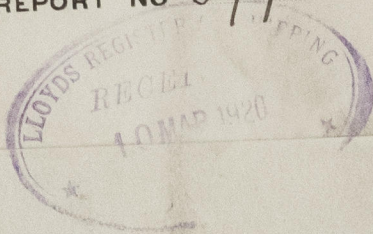

© 2020

Lloyd's Register  
Foundation

003698-003705-0207