

LLOYD'S REGISTER OF SHIPPING  
8, Rue Montyon, 8  
NANTES  
Téléphone 316-35

# Lloyd's Register of Shipping.


## SURVEYS FOR FREEBOARD.

(CONDITIONS OF ASSIGNMENT.)

5 OCT 1951

Ship's Name ex. Cassard - now Penrhieure Port of Survey Nantes  
Official Number \_\_\_\_\_ Surveyor's Signature J. J. Brunel  
Nationality and Port of Registry French - Nantes Date of Survey 5<sup>th</sup> Mars 1948

Disposition and dimensions of superstructures, trunks, deckhouses and machinery casings to be inserted in the diagrams and tabular statement: -

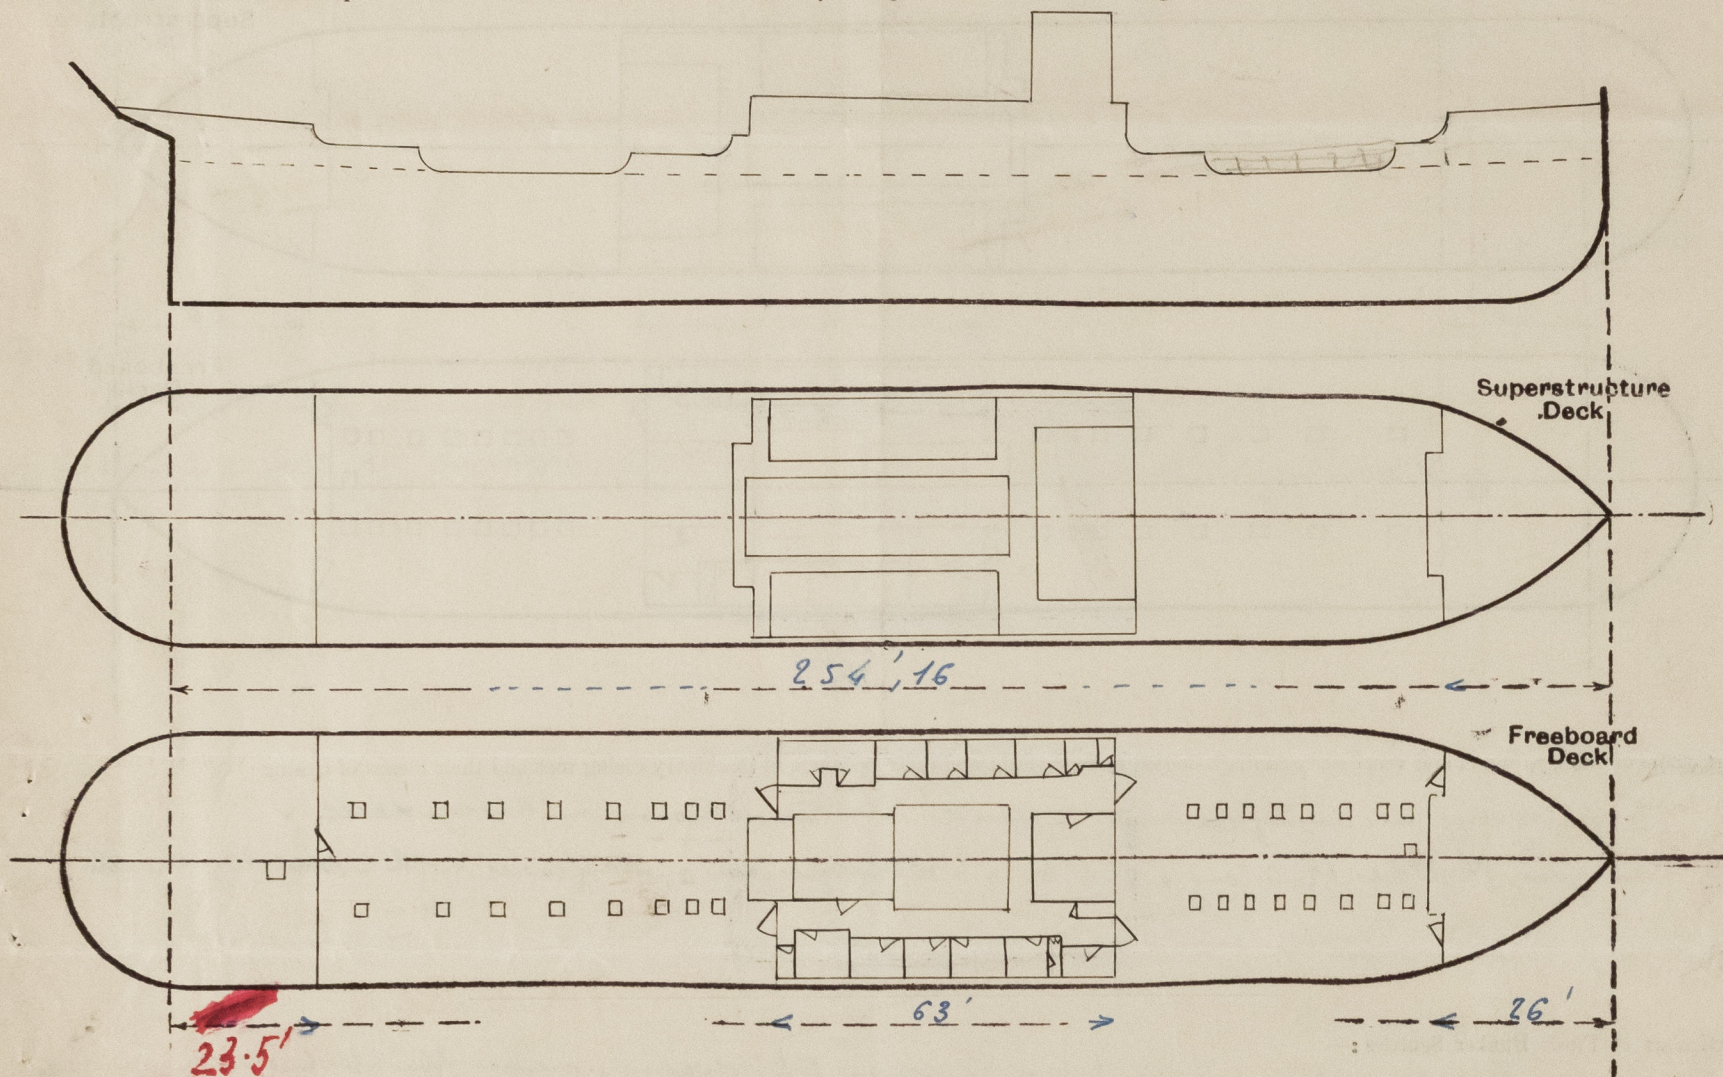

Particulars of Superstructures, Trunks, Casings, Deckhouses.

	Coaming	Plating	Stiffeners	Spacing	End Attachments of Stiffeners	Size of Openings	Height of Sills	Height of Casings
Poop Bulkhead ...	.47" ✓	.40" ✓	L 7½" x 3" x .38	2'-6" ✓	brackets ✓	h=4'-10" b=2'-9"	14"	7'-0" ✓
Raised Quarter Deck Bulkhead ...								
Bridge, After Bulkhead ...	.40" ✓	.32" ✓	L 5" x 3" x .36	2'-6" ✓	brackets ✓	h=4'-10" b=2'-0"	14"	7'-0" ✓
Bridge, Forward Bulkhead ...	.47" ✓	.40" ✓	L 7½" x 3" x .38	2'-6" ✓	brackets ✓	h=4'-10" b=5'-6"	14"	7'-0" ✓
Forecastle Bulkhead ...	.40" ✓	.32" ✓	L 5" x 3" x .36	2'-6" ✓	brackets ✓	h=4'-10" b=2'-0"	14"	7'-0" ✓
Trunk, Aft ...						h=4'-10" b=2'-9"		
Trunk, Forward ...								
Exposed Machinery Casings on Freeboard or Raised Quarter Decks ...								
Exposed Machinery Casings on Superstructure Decks ...								
Machinery Casings within Superstructures not fitted with Class I Closing Appliances ...								
Deckhouses on Flush Deck Ships ...								


Particulars of Closing Appliances (state if capable of being manipulated from both sides).

Poop Bulkhead ...	1 watertight iron door - 3 side lights 10"
Raised Quarter Deck Bulkhead ...	
Bridge, After Bulkhead ...	2 watertight iron doors - 2 15" side lights
Bridge, Forward Bulkhead ...	2 watertight iron doors
Forecastle Bulkhead ...	3 non watertight iron doors - 2 10" side lights
Exposed Machinery Casings on Freeboard or Raised Quarter Decks ...	
Exposed Machinery Casings on Superstructure Decks ...	
Machinery Casings within Superstructures not fitted with Class I Closing Appliances ...	
Deckhouses on Flush Deck Ships ...	



# PARTICULARS OF PROTECTION TO OPENINGS, ETC.

The following diagrams should be used to indicate the positions of cargo and coaling hatchways, gangway, cargo and coaling ports, ventilators, companionways, etc., which would affect the seaworthiness of the ship:—

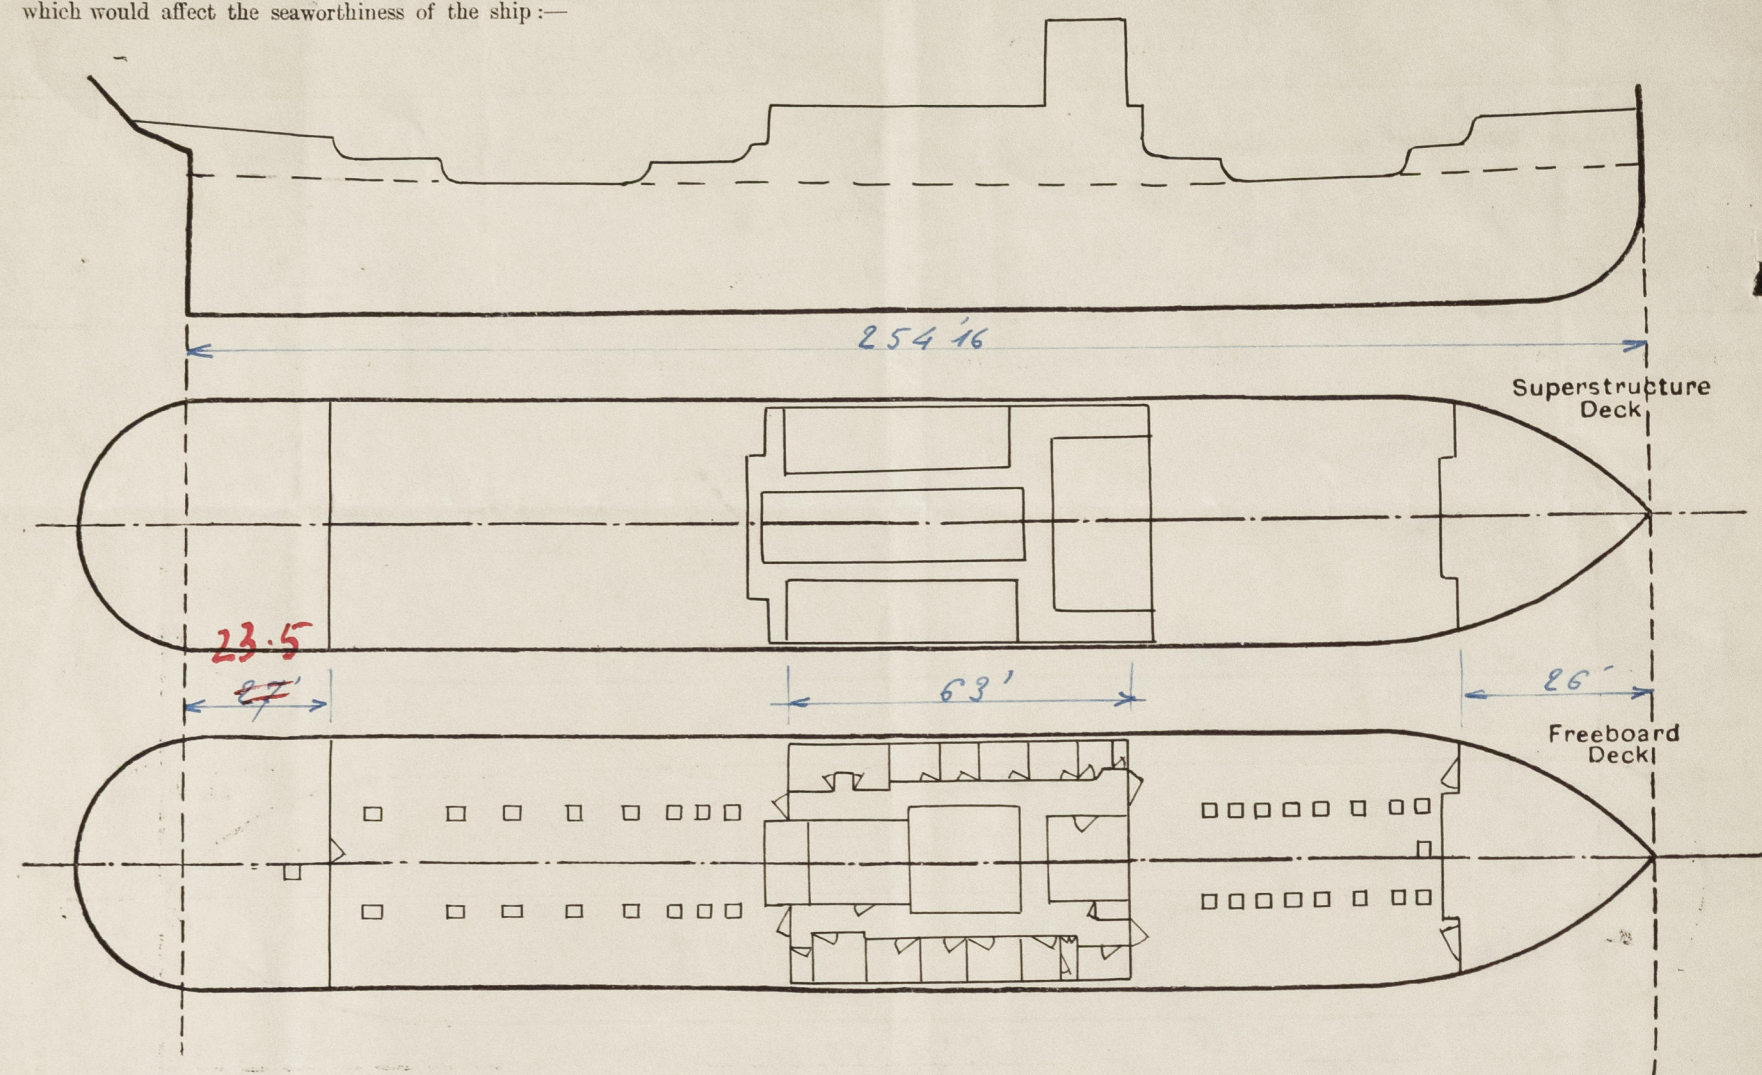

Particulars of fiddle, funnel and ventilator coamings, engine room skylight and other openings in machinery casing tops and their means of closing:—

*Fiddle and machinery casings enclosed into Deck house on bridge deck ✓  
Engine skylight 12'-0" long x 8'-6" br. - 6 weatherproof iron opening covers with 2 dead lights each ✓*

Particulars of Flush Bunker Scuttles:—

*Oil bunkers fitted by 2 pipes 5 1/2" diam. near the bulwarks at sides of front bulkhead of bridge deck and fitted with blind joints. ✓*

Particulars of Companionways:—

*None ✓*

Particulars of Ventilators in exposed positions on freeboard and superstructure decks:—

*Just one small ventilation touching the after part of the coaming of the forward escape hatch, about 9 feet from the Forecastle bulkhead.*

*Closing appliances?*

Particulars of Air Pipes in exposed positions on freeboard, raised quarter, or superstructure decks:—

*No air pipe exposed ✓*

Particulars of Gangway Cargo and Coaling Ports:—

Particulars of Scuppers and Sanitary Discharge Pipes:—

Particulars of Side Scuttles:—

*4 side scuttles on each side of Deck, 7 on each side of bridge and 1 on each side of forecabin - All 10" weatherlights, & Deadlights? ✓*

Vertical distance of Sill of lowest Side Scuttle above top of keel *The bottom of the lowest side scuttle is about 27'-0" above the keel*

Particulars of Guard Rails:— *h= 5'-0" - 3 rails (see plan) ✓*

Particulars of Gangways, Lifelines, etc.:—

*Lifelines on gangways*

## Particulars of Freeing Arrangements.

	Length of Bulwark	Height of Bulwark	Size of Freeing Ports	Number each side	Area each side	Rule area each side
After Well ... ..	<i>Plan see forward plan</i>				<i>then rails &amp; length of bulwark?</i>	
Forward Well ... ..	<i>do</i>					

State position of each freeing port ... .. (After Well:—  
(F. and A. position and height above deck edge) (Forward Well:—

State whether the freeing ports are fitted with shutters, bars, or rails, and give particulars of such:—

Additional area where sheer is less than standard.



PARTICULARS OF PROTECTION TO OPENINGS, ETC.

HATCHWAYS ON FREEBOARD AND SUPERSTRUCTURE DECKS.									
Description of Hatchway	...	...	...	33 small Hatches	for access in the wine vaults	✓			
Dimensions of Hatchway	...	...	...	27.6"	x 23.6"	✓			
COAMINGS	{	Height above Deck	...	3'-3"					
		Thickness	{	Sides	...	.40"			
			{	Ends	...	.40"	✓		
		Stiffeners	...						
		Brackets, Stays	...						
HATCH BEAMS	{	Number	...						
		Spacing	...						
		Scantling and Sketch	...						
		Bearing Surface	...						
FORE AND AFTERS	{	Number	...						
		Spacing	...						
		Unsupported Lengths	...						
		Scantling and Sketch	...						
		Bearing Surface	...						
HATCH COVERS	{	Material	...	Wood					
		Thickness	...	.32					
		How fitted	...	is no hinges - rubber foot and locking device	✓				
		Bearing Surface	...						
Spacing of Cleats	...	...	...						
Number of Tarpaulins	...	...	...						
<p>*Are wood fore and afters steel shod at all bearing surfaces ?</p> <p>Are battens and wedges efficient and in good condition ?</p> <p>Are tarpaulins in good condition and in accordance with rule requirements ?</p> <p>Are lashings provided in accordance with rule requirements ?</p>									

Particulars of any special features :—

Endorsement at first survey and at surveys for renewal of Certificate :—

The fittings and appliances are in accordance with the particulars shown on this form (or as now modified) and are in good condition.

