


DWG No 45/7/2.

S.S. "JALAJYOTI"


HEIGHTS OF BOTTOM SHELL ABOVE NORMAL LINE
OF BOTTOM.

STAB^D SIDE

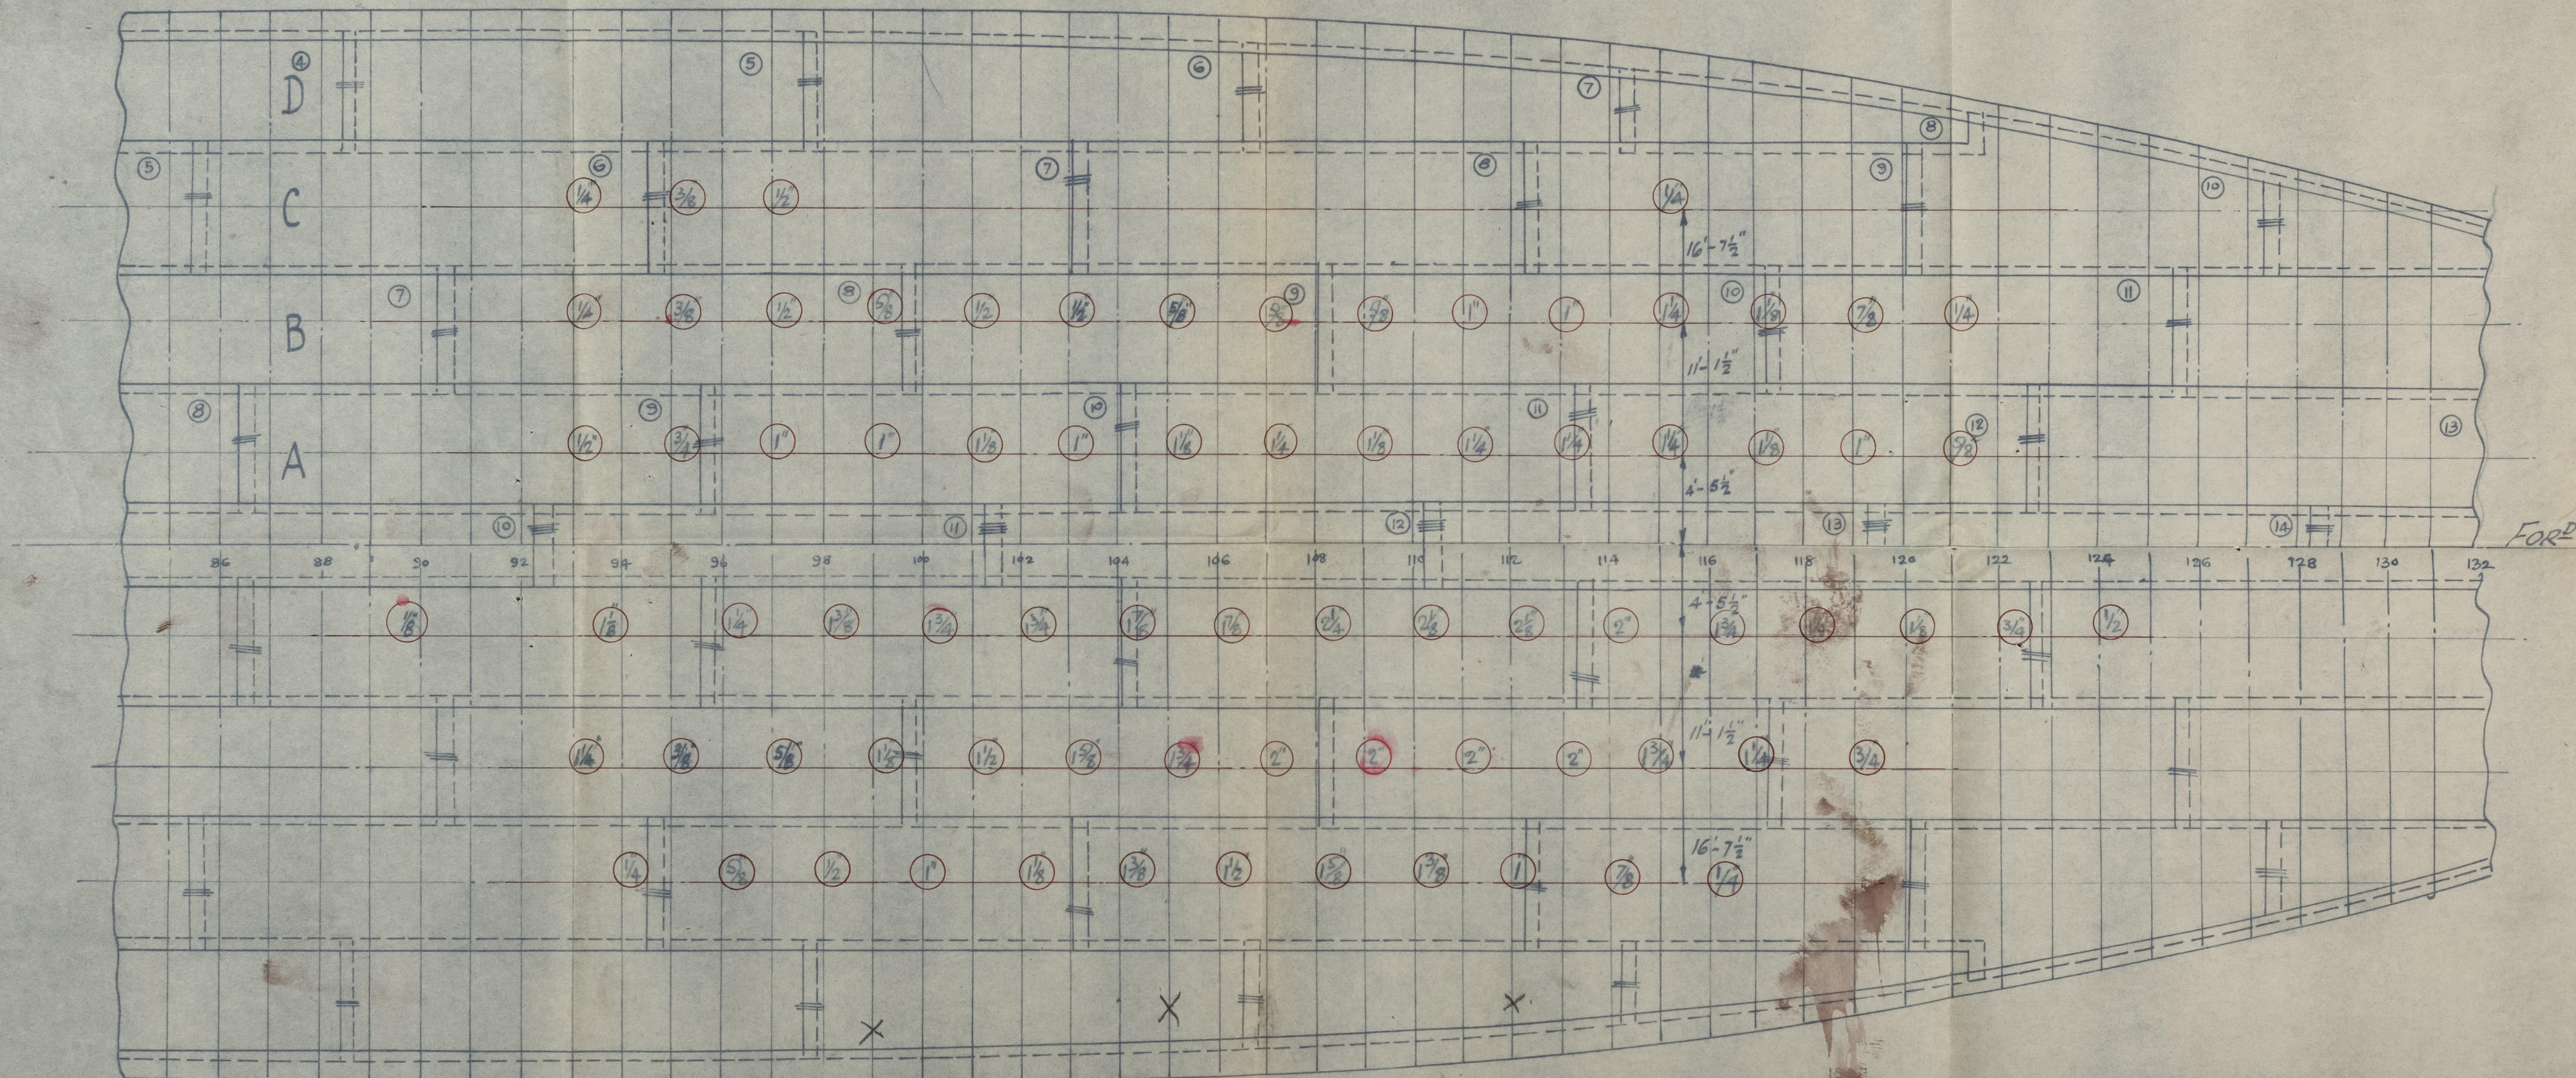

LOOKING FROM BOTTOM

PORT SIDE

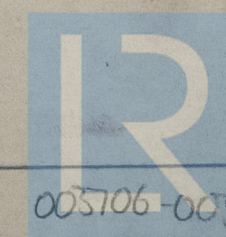

© 2020


Lloyd's Register

005106-005711-F-0114 Foundation

TALATONAN

Bottom Shell.

Rept. No. 16278

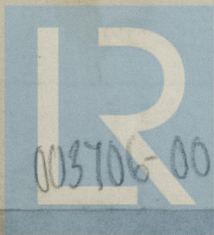

© 2020

003706-003711-0114
Hoyd's Register
Foundation