


Office

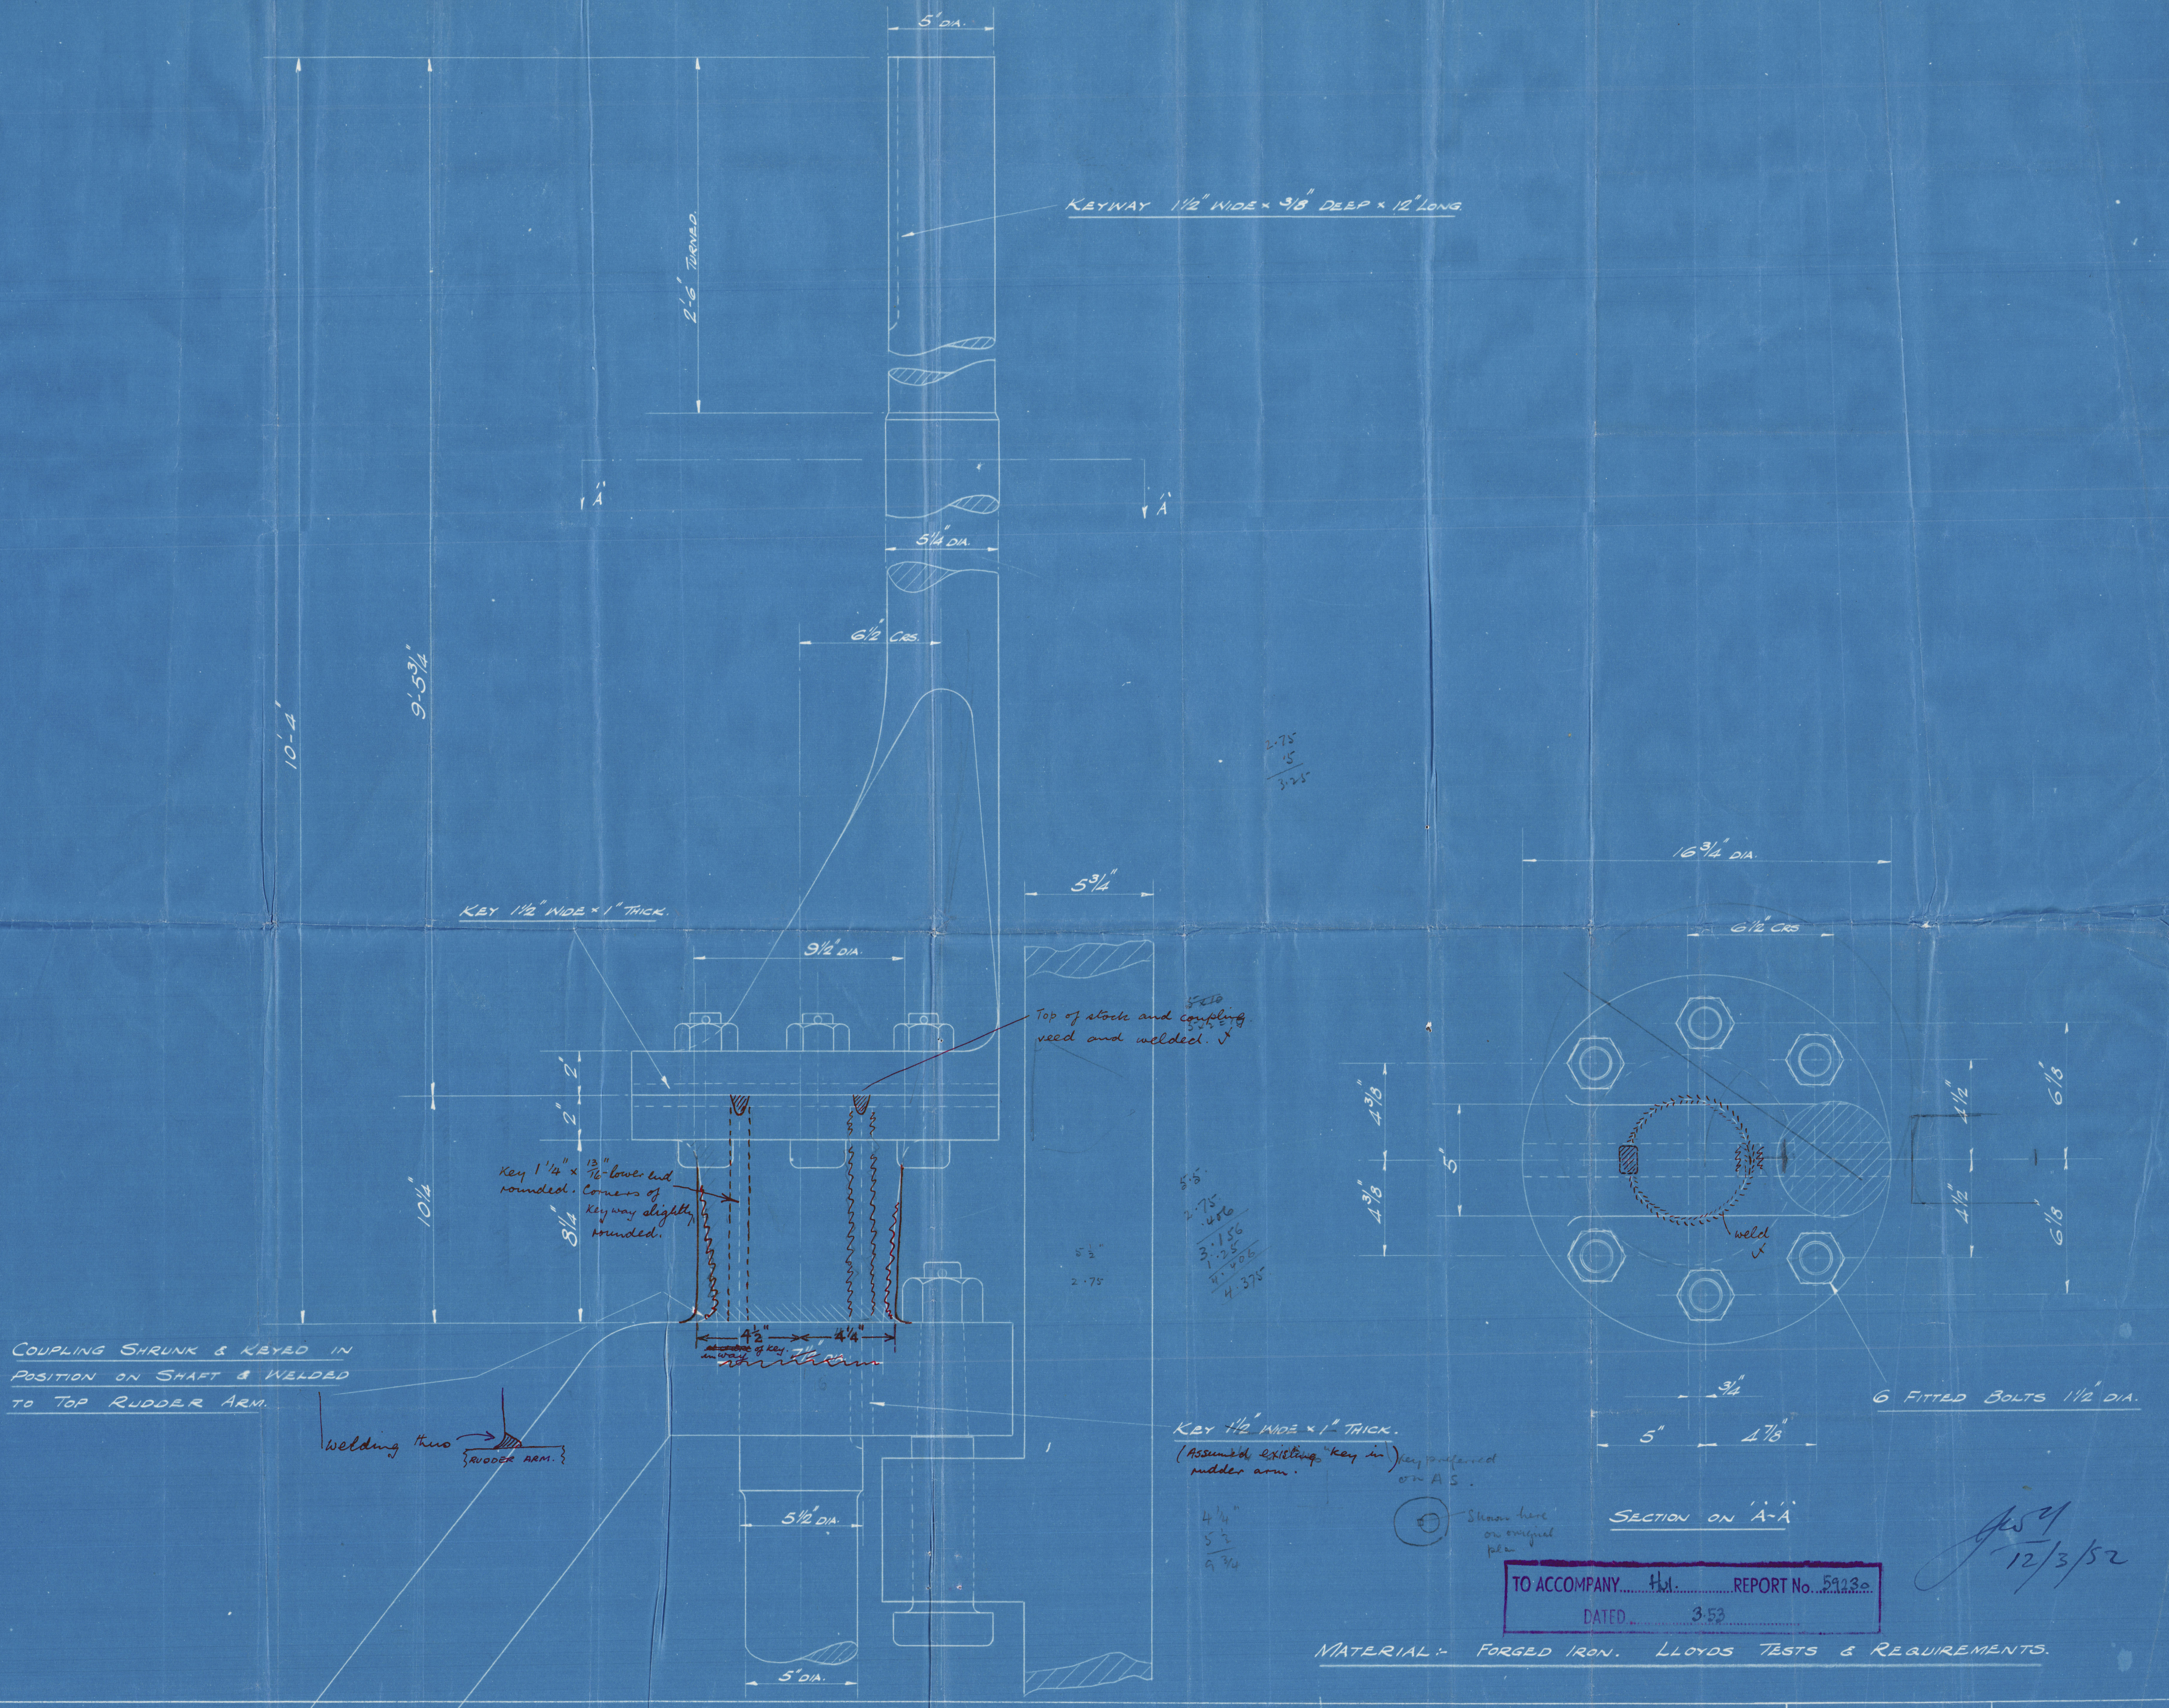

FELLOWS & COMPANY LTD
SOUTHTOWN DRY DOCKS.
GREAT YARMOUTH.

NEW RUDDER HEAD FOR M.V. "SODALITY."

DATE: 6 MARCH 1952 SCALE: 3/4 ONE FOOT.
DRAWN BY: *[Signature]* CHECKED BY: *[Signature]*
DRAWING No. *3432/52*

DL

SODALITY

003712-003719-0005



© 2021

Lloyd's Register
Foundation

Messrs. Crabtree (1931) Ltd.

Proposed Rudder main Piece & Coupling

for the motor ship "Sodality".

Office

003712 - 003719 - 0005



© 2021

Lloyd's Register
Foundation