


FOR
M.V. "CALUMET."

SECTION AT D.D.
LOOKING AFT.

METHOD OF FITTING TUBE FOR LIFTING BOLTS


SECTION AT A.A.

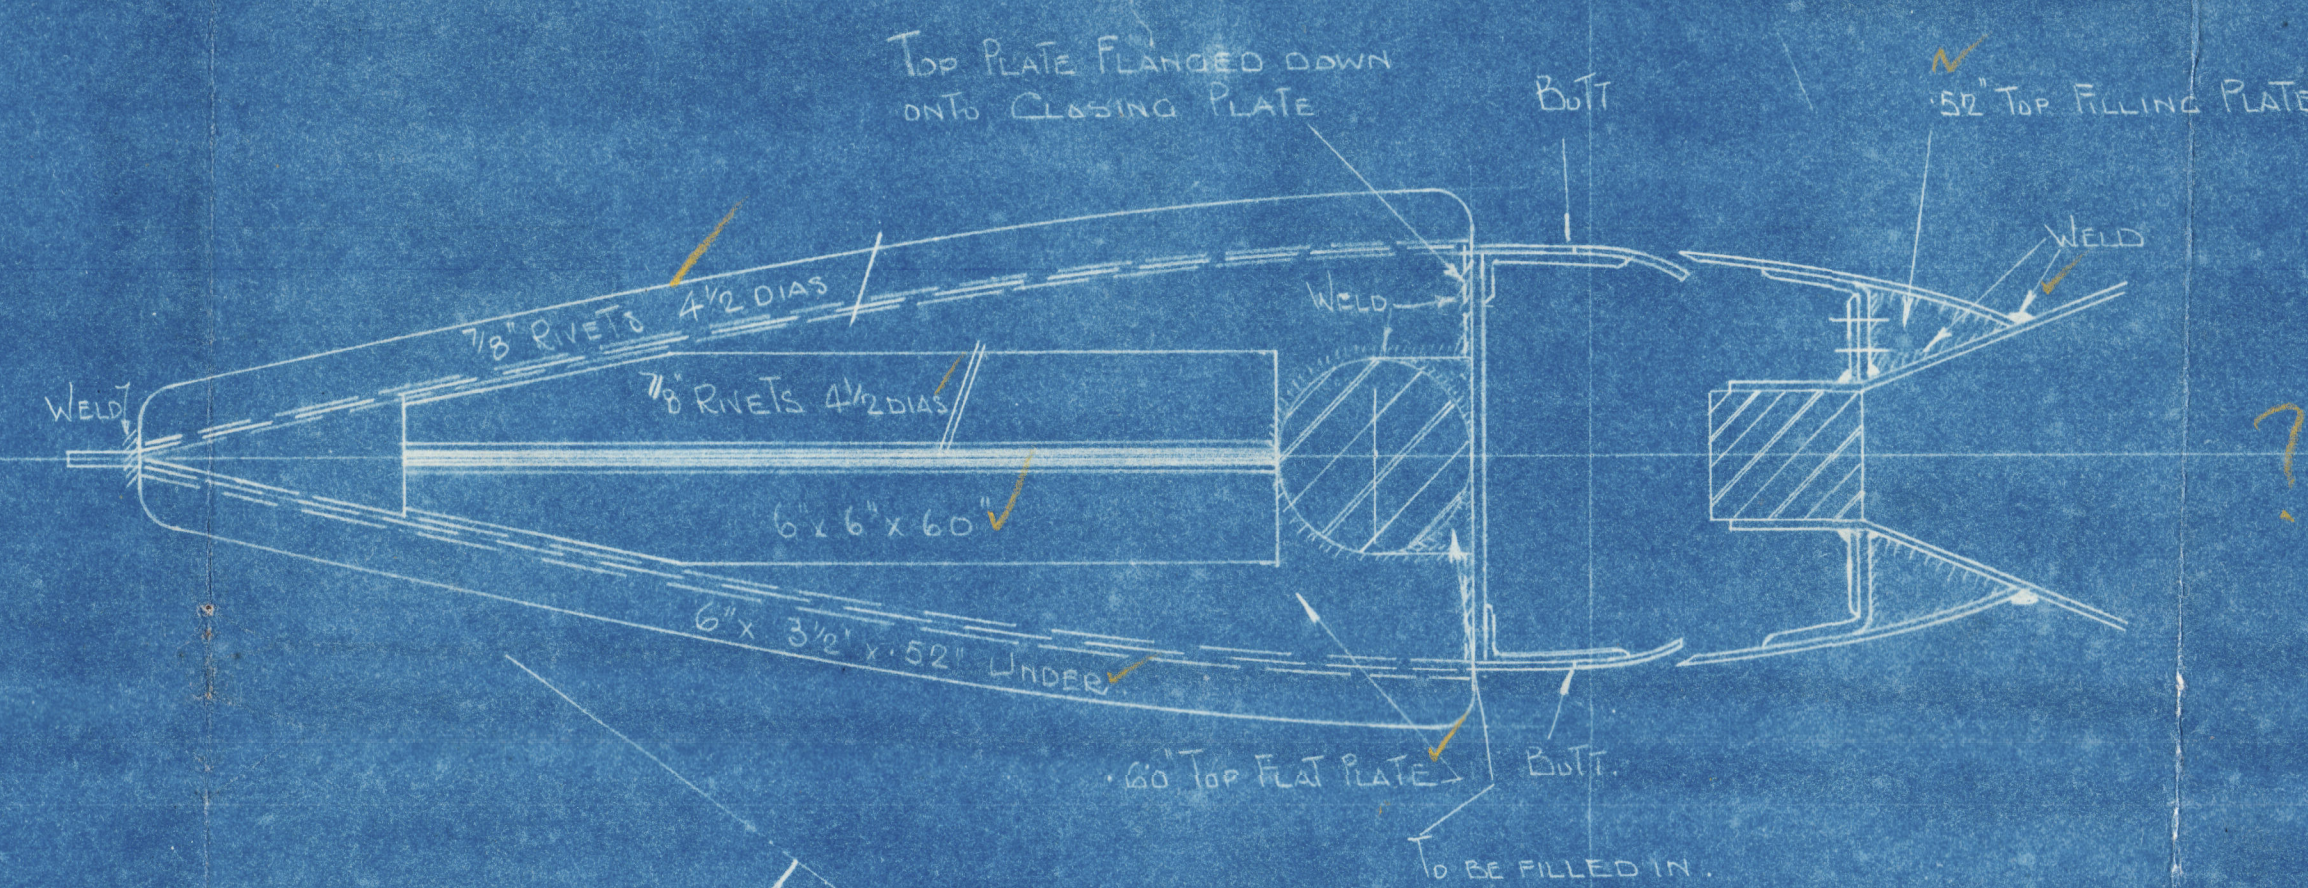

SECTION AT B.B.

SECTION AT C.C.

OUTLINE OF RUDDER OUTSIDE OF PLATE

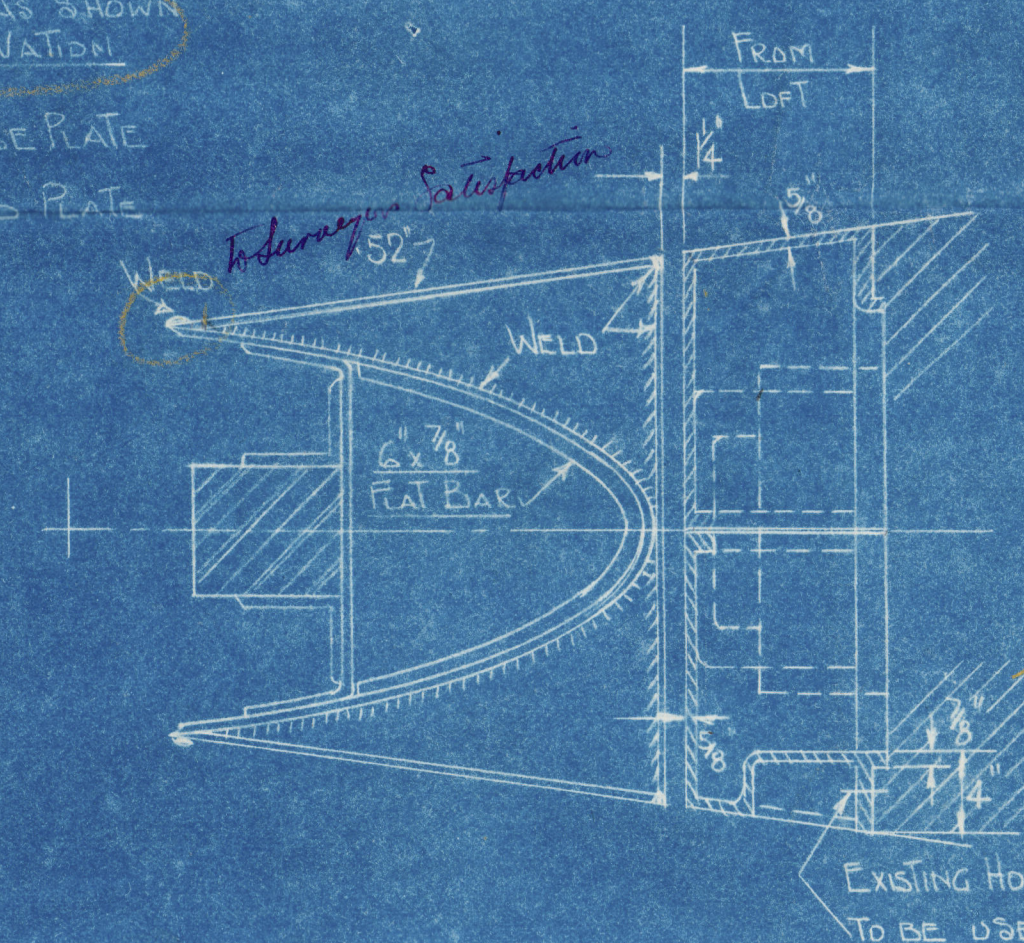

DETAIL OF CONES IN WAY OF PROPELLER BOSS

SCALE:- 1" = 1 FOOT



		DATE
DRAWN BY	J.B.	14.6.3
TRACED BY		
CHECKED BY		
APPROVED BY		

M.272

BOXING

WEERTZ RUDDER

FOR "CALUMET"

S. S. "Calumet"

LIVERPOOL

Report No. 104070.



© 2021

Lloyd's Register
Foundation

003712-003719-0136