


Ober

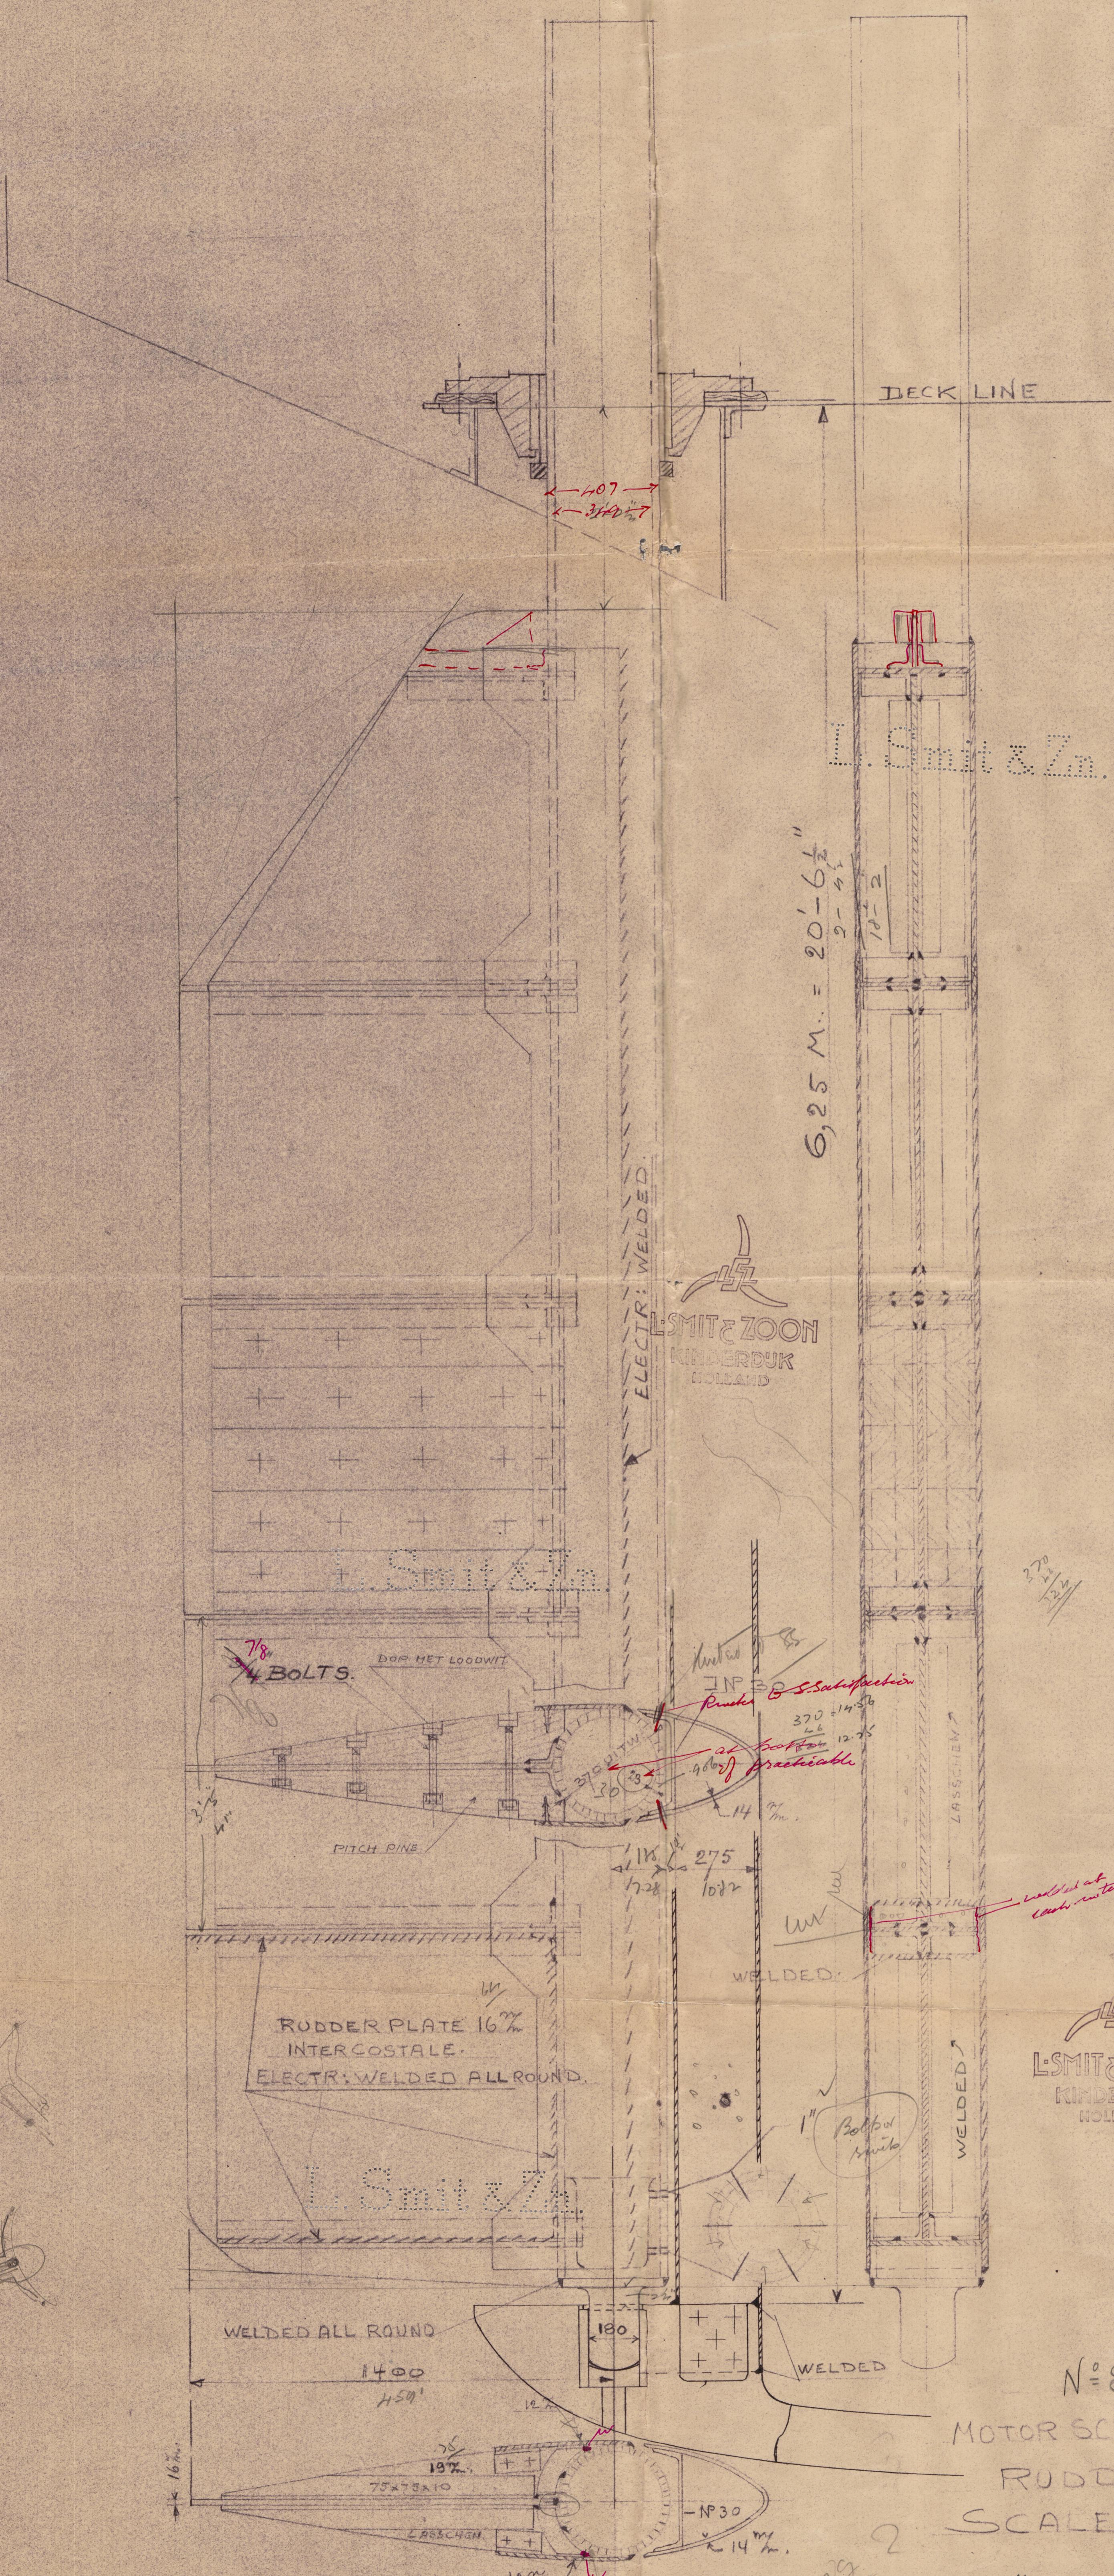

Rudder

For Stock

See letter 16/1/33

GEN. BOX NO 1218

'ZWARTE ZEE'



© 2021

Lloyd's Register  
Foundation

003712-003719-6273