

PLAN NO 12.
SHIP NO 337.
STERNPOST & RUDDER.
SCALES AS INDICATED.

NOTE:—
RUDDER STOCK ARM—BENT, RIGID, IN HOT STEEL.
ARM SHOWN IN VIEW TO STOCK.
COUPLING BOLTS & PINTLES OF RIGID STEEL.
STERN FRAME—MILD IN HOT STEEL RIGID.



DETAIL OF GUDGEONS A, B, C, & D.


SCALE 1/2" = 1 FOOT.

DETAIL OF STOPPER ARM.

SCALE 3/4" = 1 FOOT.

DETAIL OF GUDGEON E.


SCALE 3/4" = 1 FOOT.

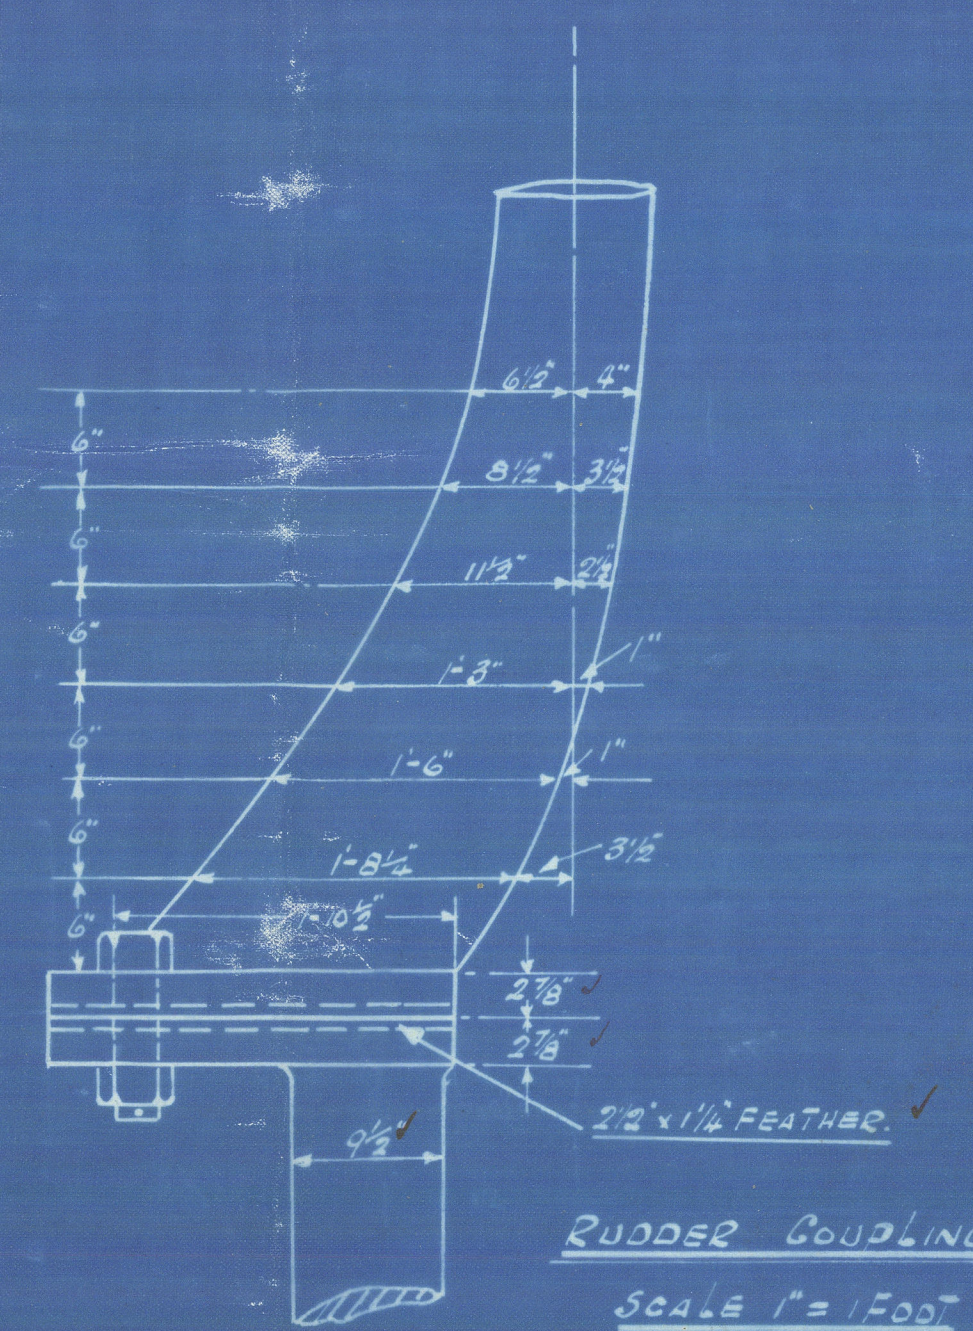


RUDDER COUPLING
SCALE 1" = 1 FOOT.

6-2 1/2" STED BOLTS
HEADS & NUTS HEXAGONAL.


AREA OF RUDDER = 116.7
C.G. AFT OF PINTLES = 3.33
SEA SPEED NOT EXCEEDING 10 KNOTS
DIA OF RUDDER HEAD = 9 1/2"
RUDDER & STOCK TO ALLOW SURVIV.

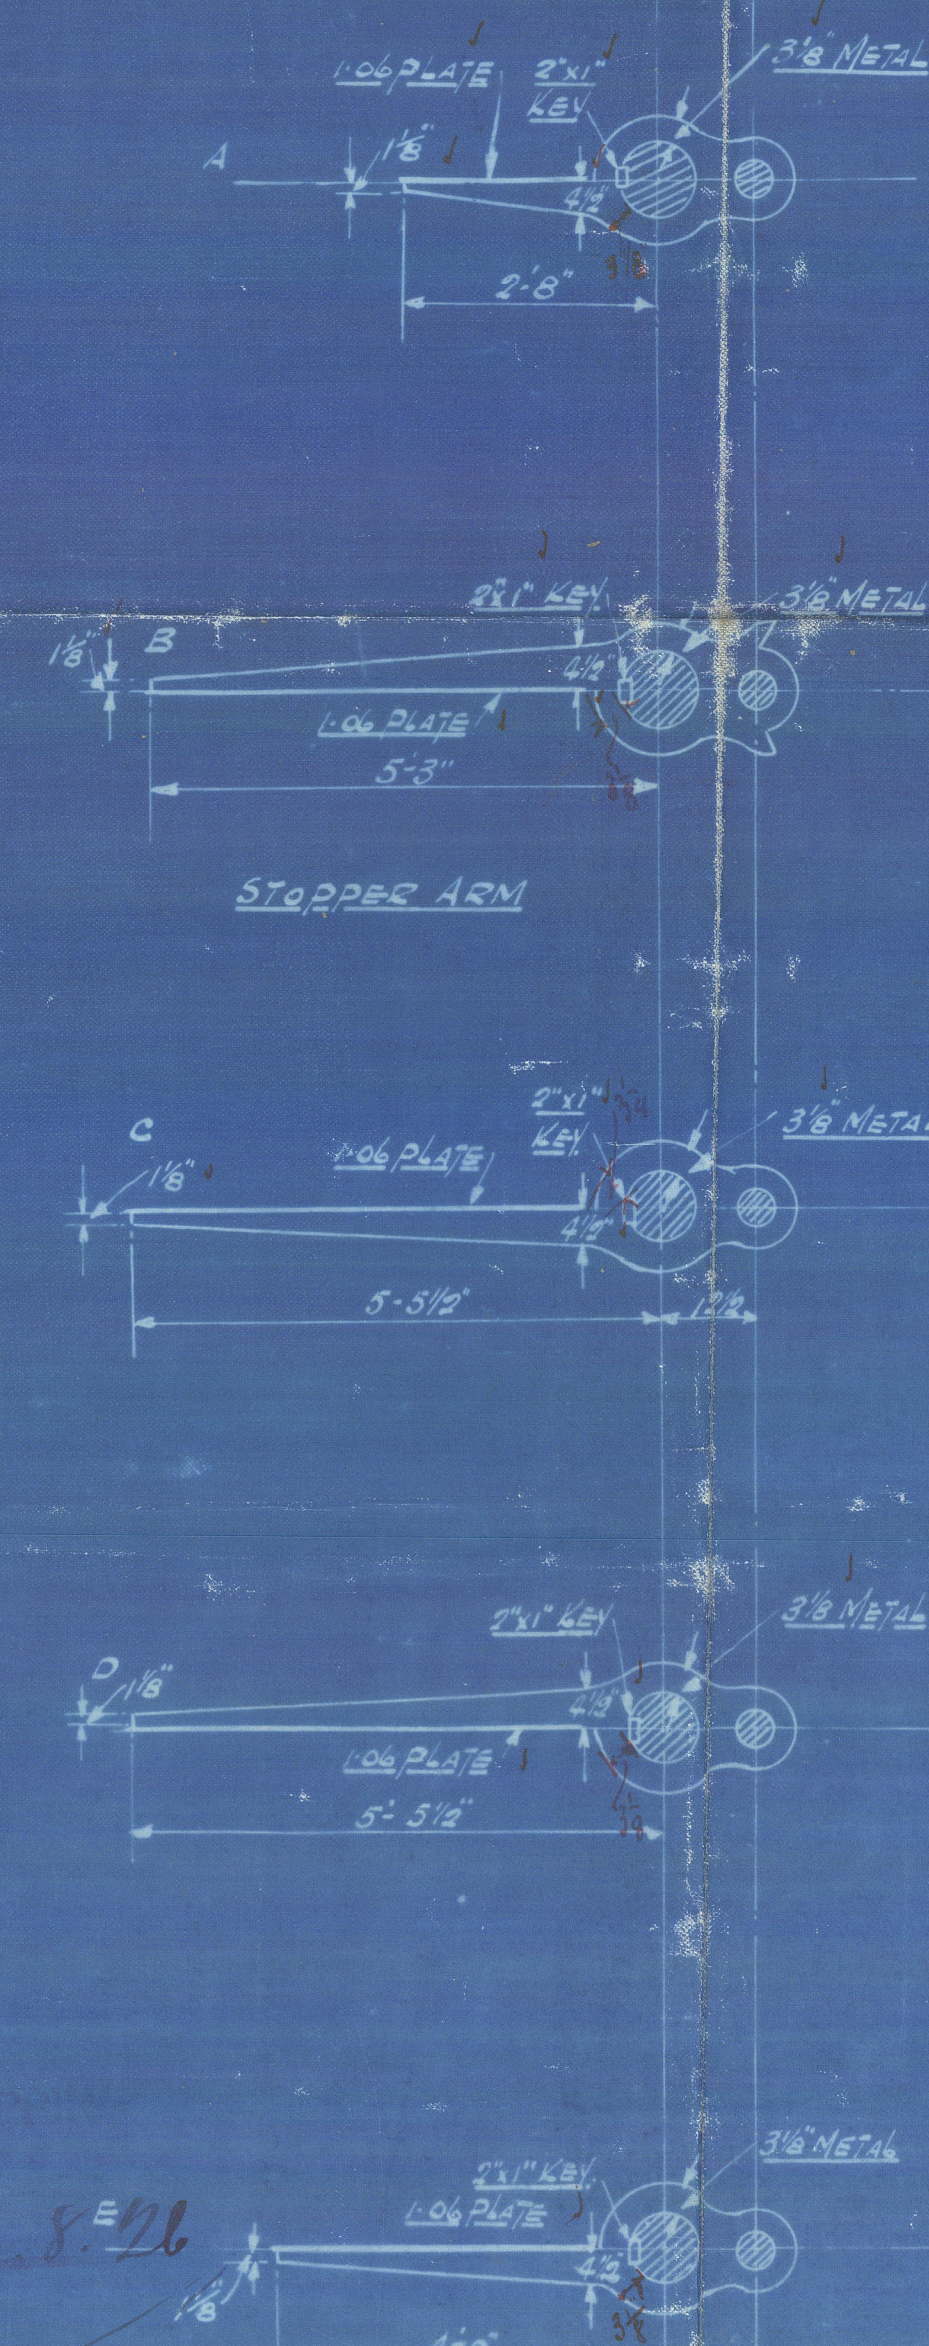

STOPPER ARM

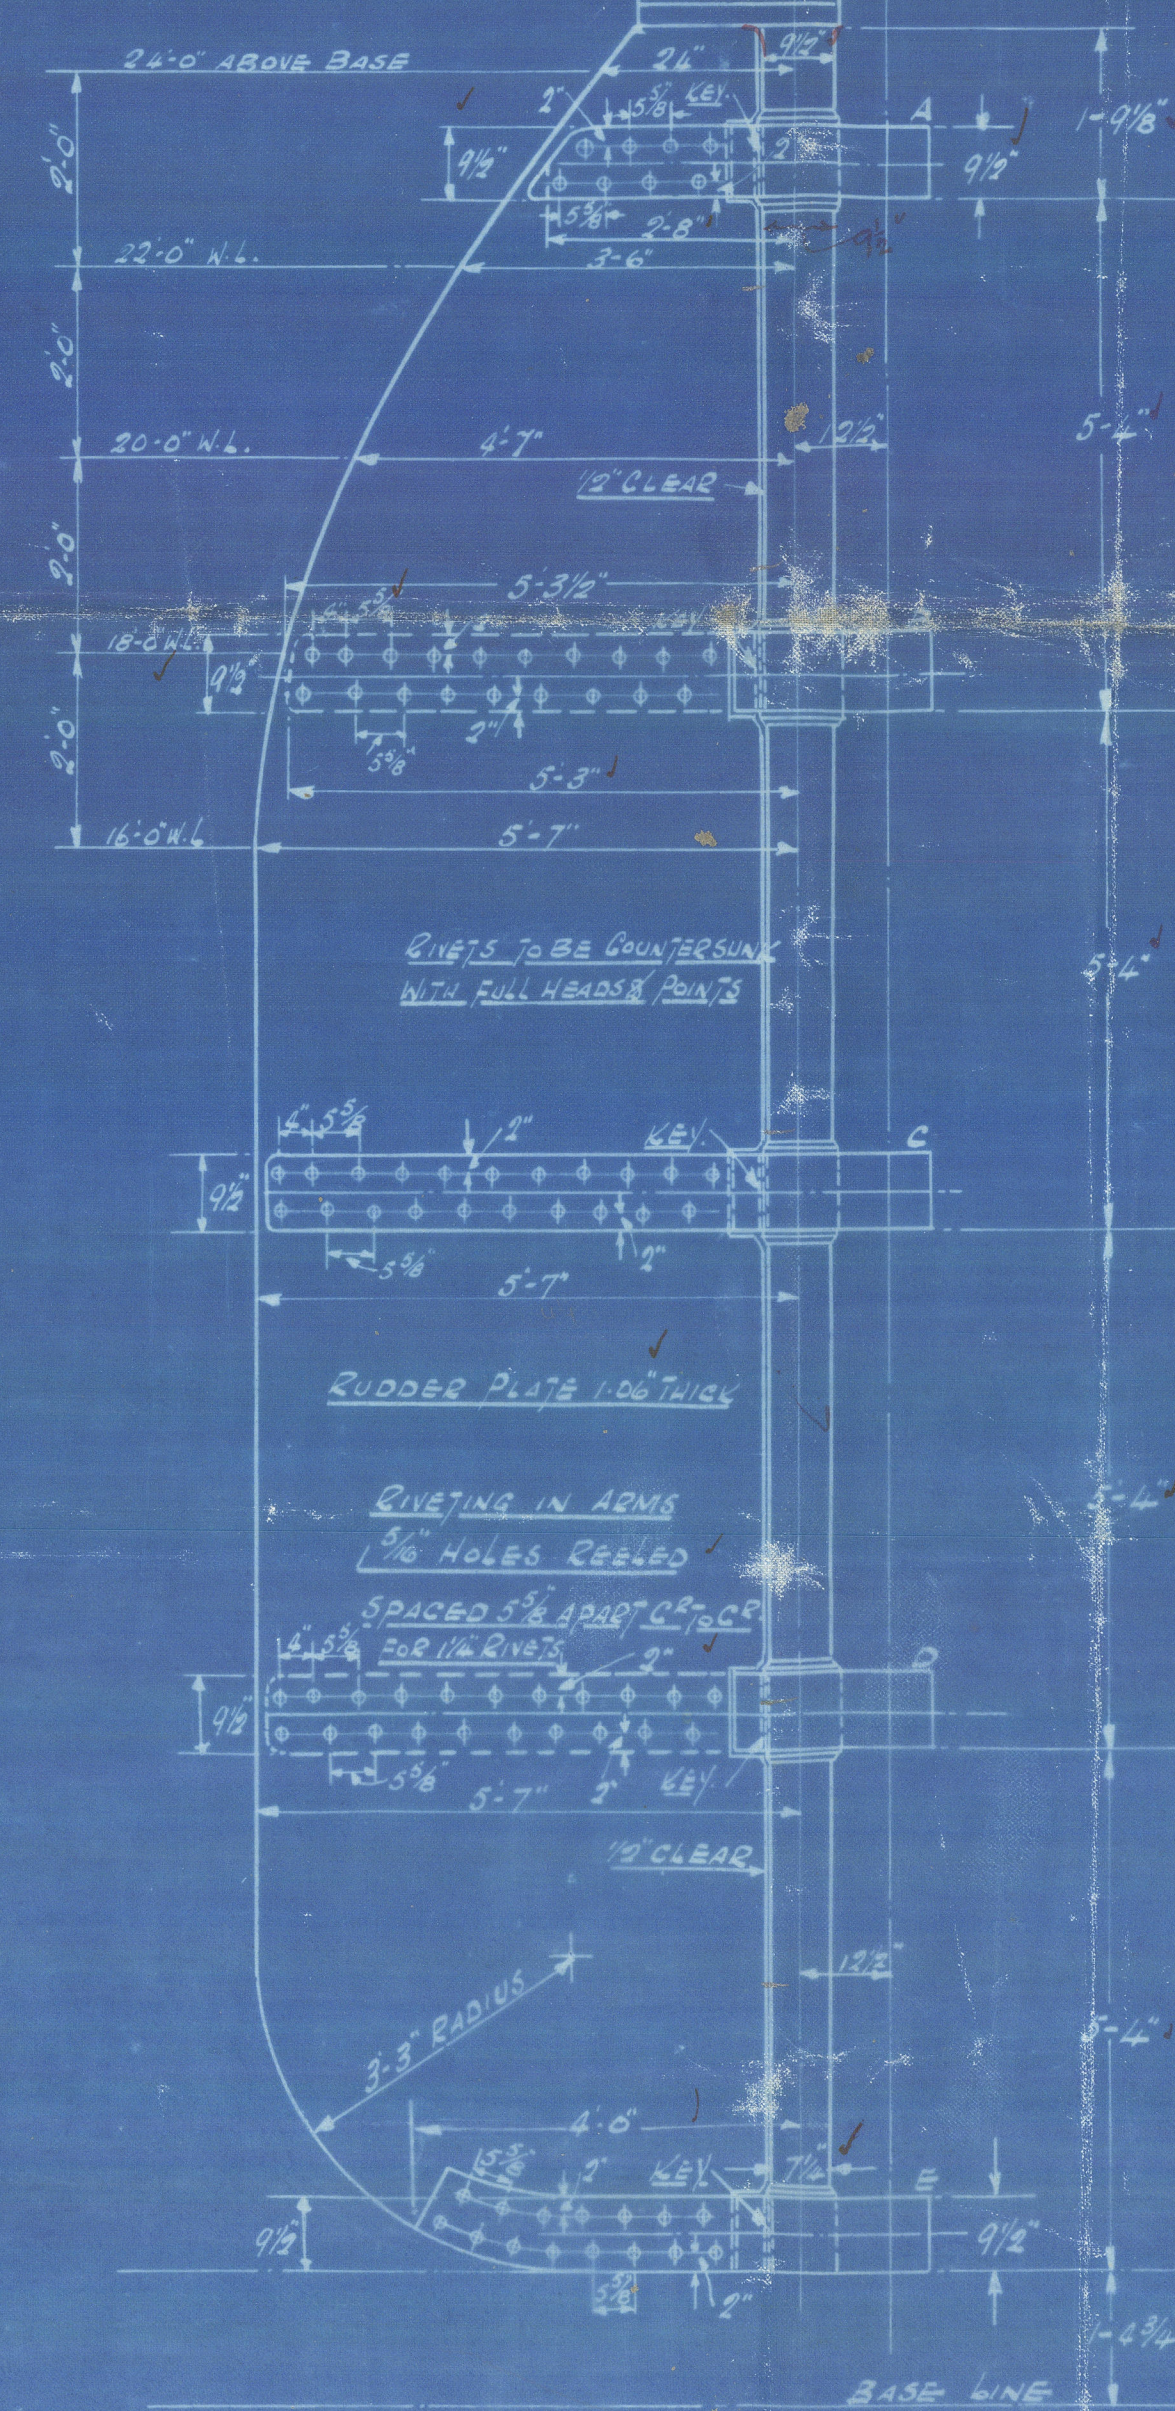

SCALE 1/2" = 1 FOOT.

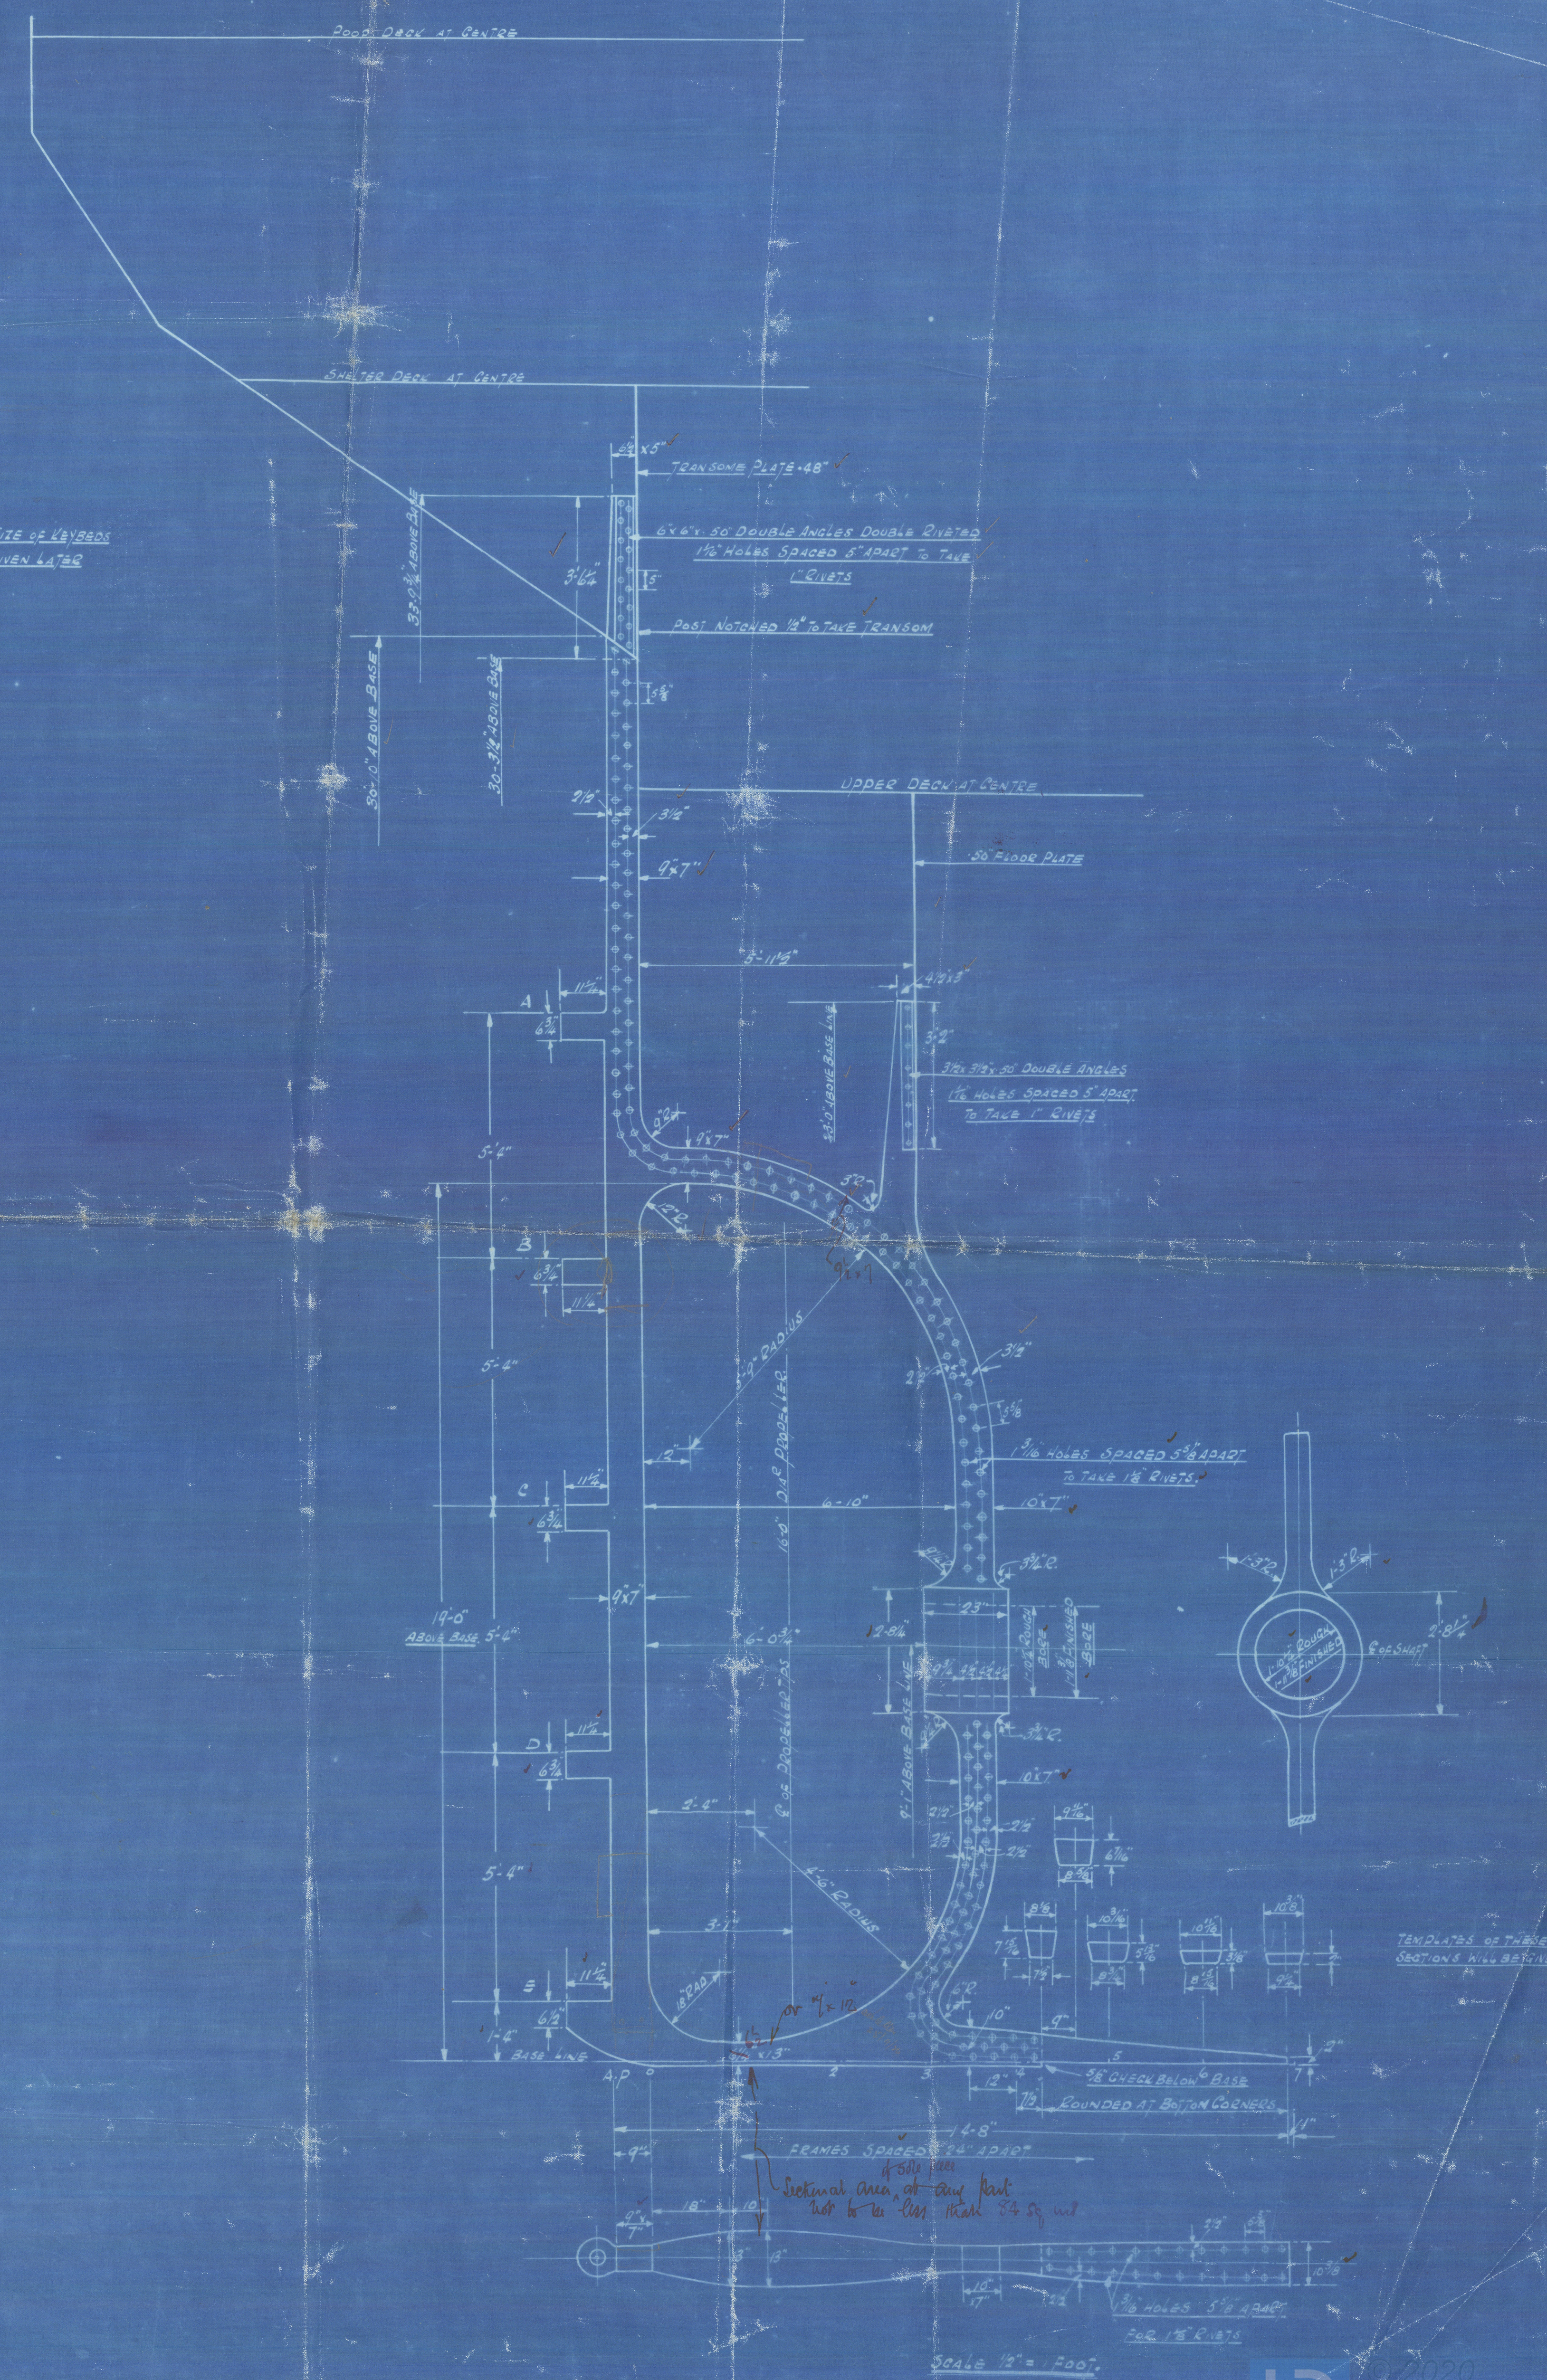

SCALE 1/2" = 1 FOOT.

Arrossan No 337.

Stern Post & Rudder.

Deido
GLASGOW REPORT No. ~~47682~~



© 2020

Lloyd's Register
Foundation

005720-003726-0161