



TOP LOCKING PINTLE.

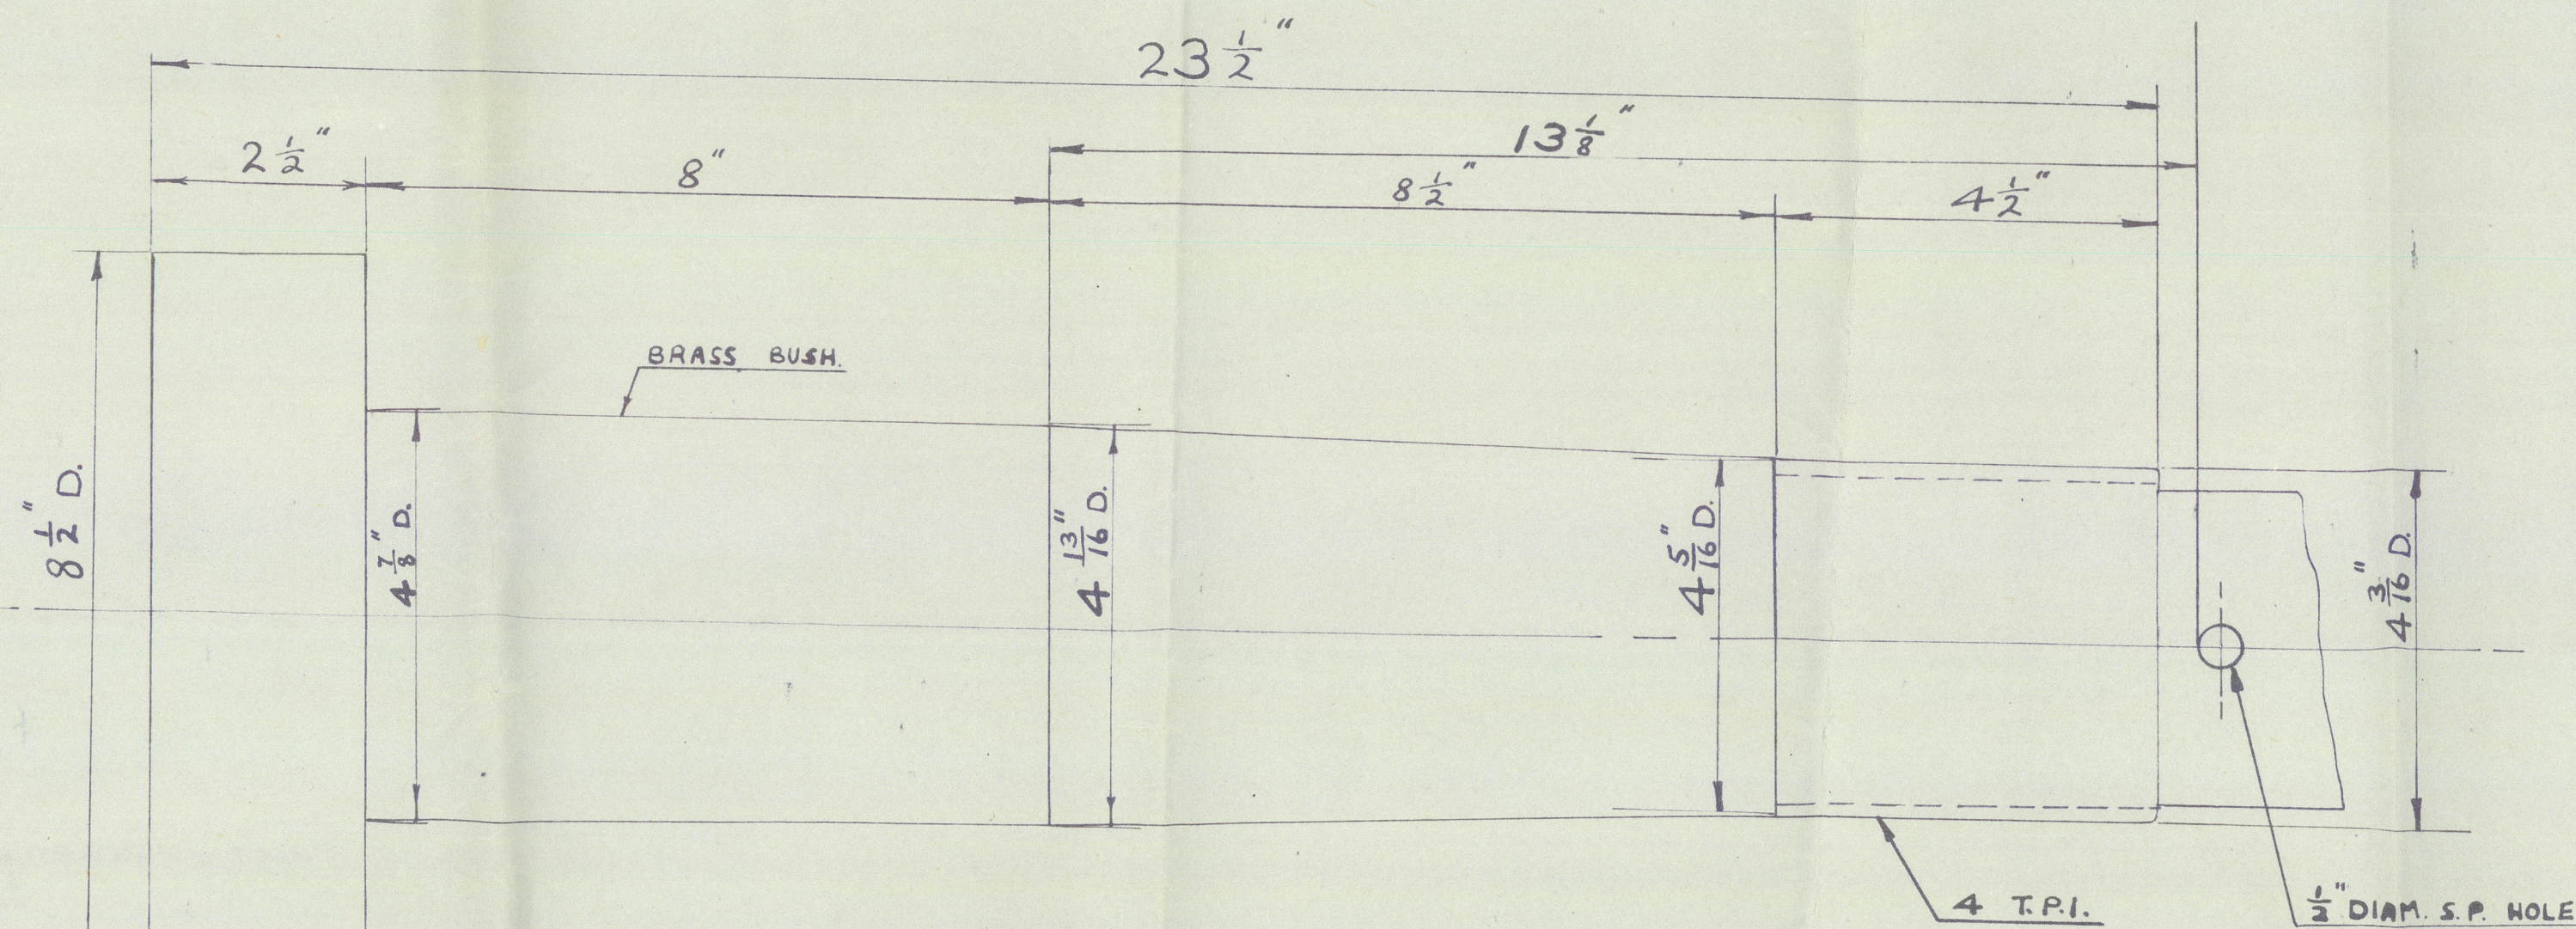


BUSH SIZES.
O.D. P.S. $6\frac{5}{16} + \frac{.50}{1,000}$
F.A. $6\frac{5}{16}$
LENGTH 6" WITH $\frac{1}{2}$ " THICK FLANGE; FLANGE O.D. $6\frac{3}{4}$

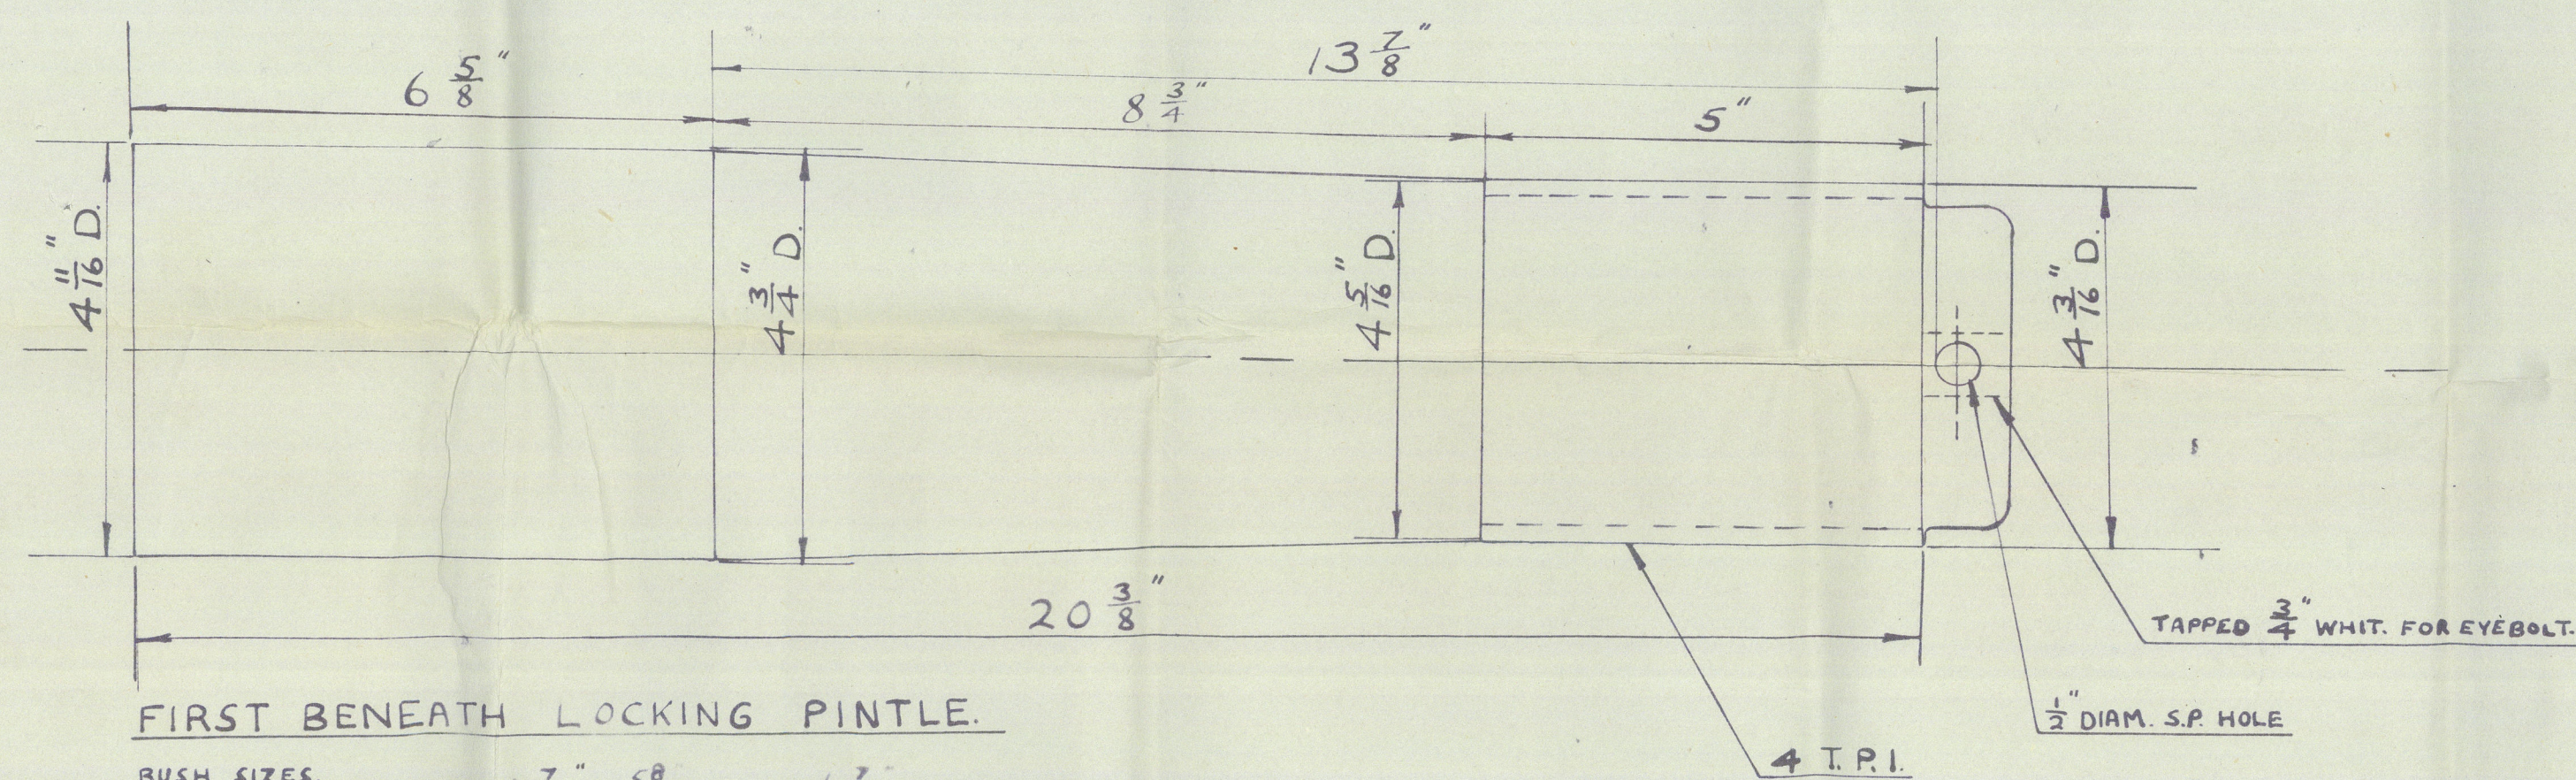

FIRST BENEATH LOCKING PINTLE.

BUSH SIZES.
O.D. P.S. $6\frac{7}{8} + \frac{.50}{1,000}$; F.A. $6\frac{7}{8}$
LENGTH 6" WITH $\frac{1}{2}$ " THICK FLANGE; FLANGE O.D. $6\frac{3}{4}$

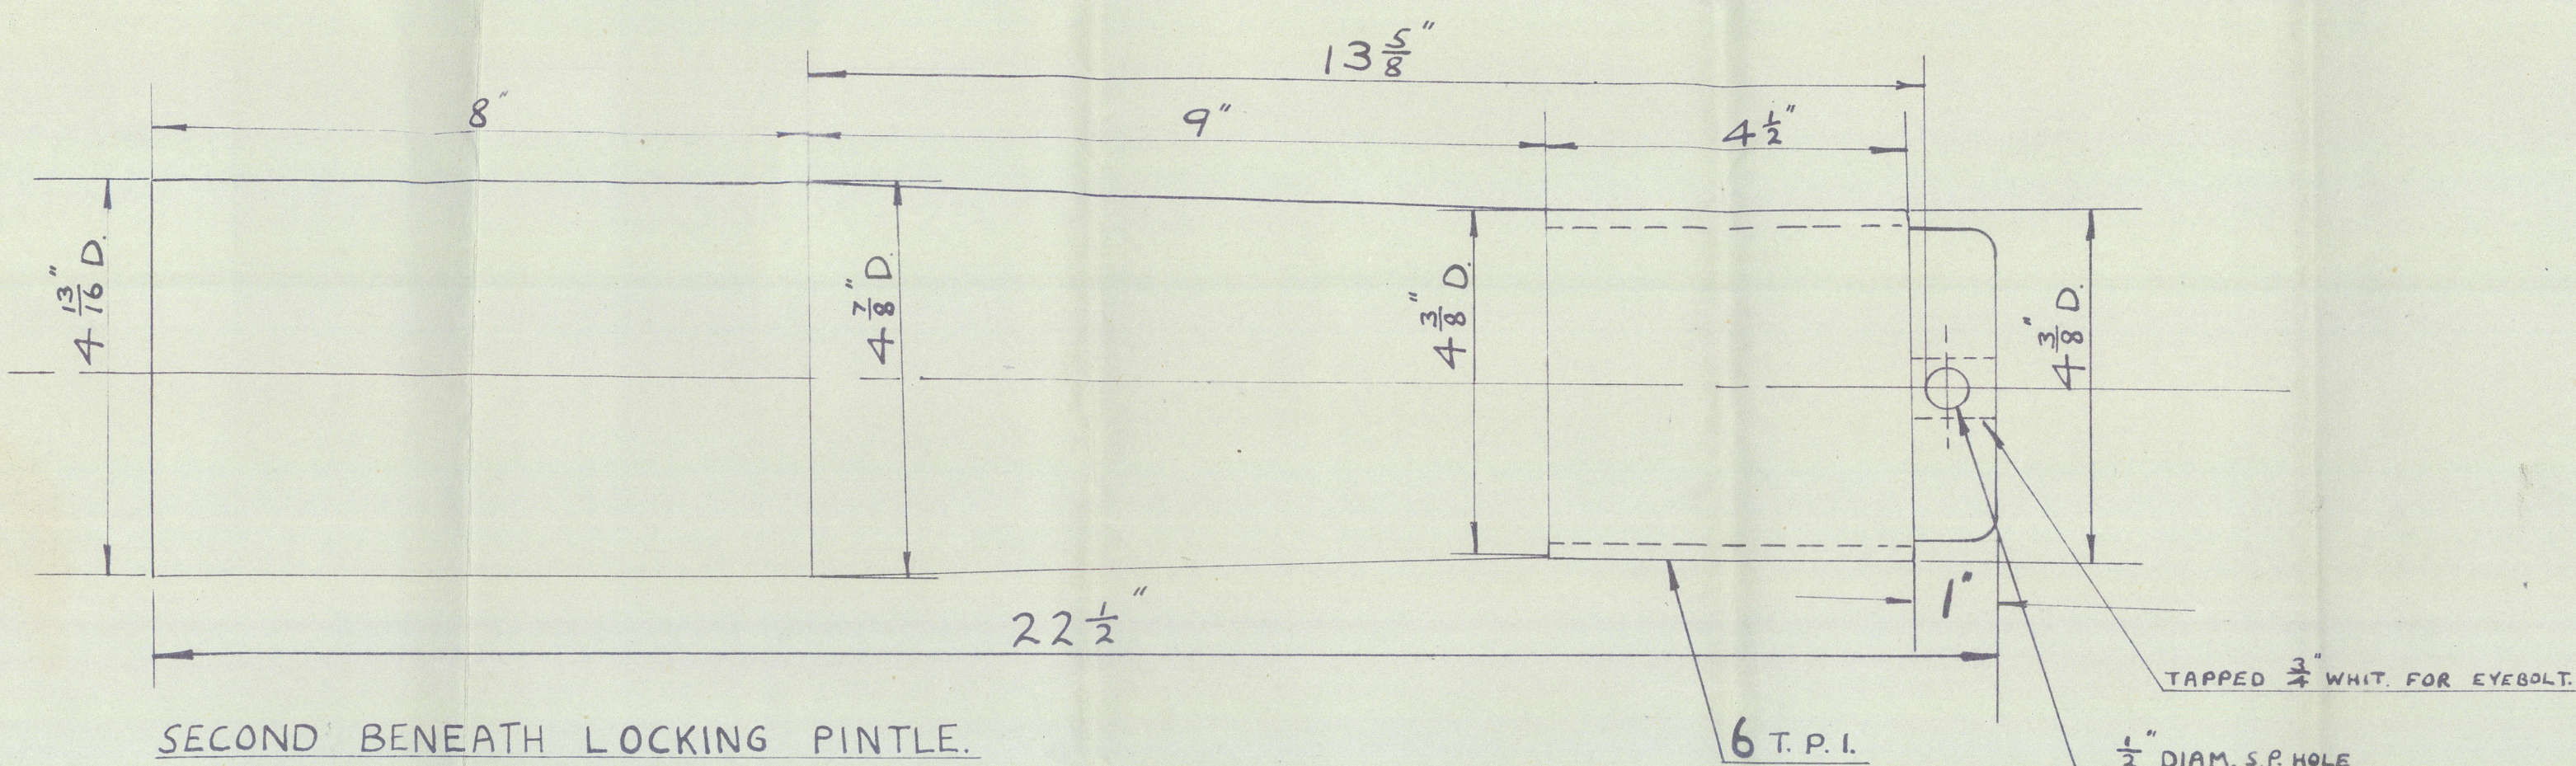


SECOND BENEATH LOCKING PINTLE.

BUSH SIZES.
O.D. P.S. $6\frac{3}{16} + \frac{.42}{1,000}$; F.A. $6\frac{3}{16}$
LENGTH $5\frac{1}{2}$ " WITH $\frac{1}{2}$ " THICK FLANGE; FLANGE O.D. $6\frac{1}{2}$


THIRD BENEATH LOCKING PINTLE.

BUSH SIZES.
O.D. P.S. $6\frac{1}{8}$; F.A. $6\frac{1}{8}$ D.
LENGTH $5\frac{1}{2}$ " WITH $\frac{1}{2}$ " THICK FLANGE; FLANGE O.D. $6\frac{1}{2}$

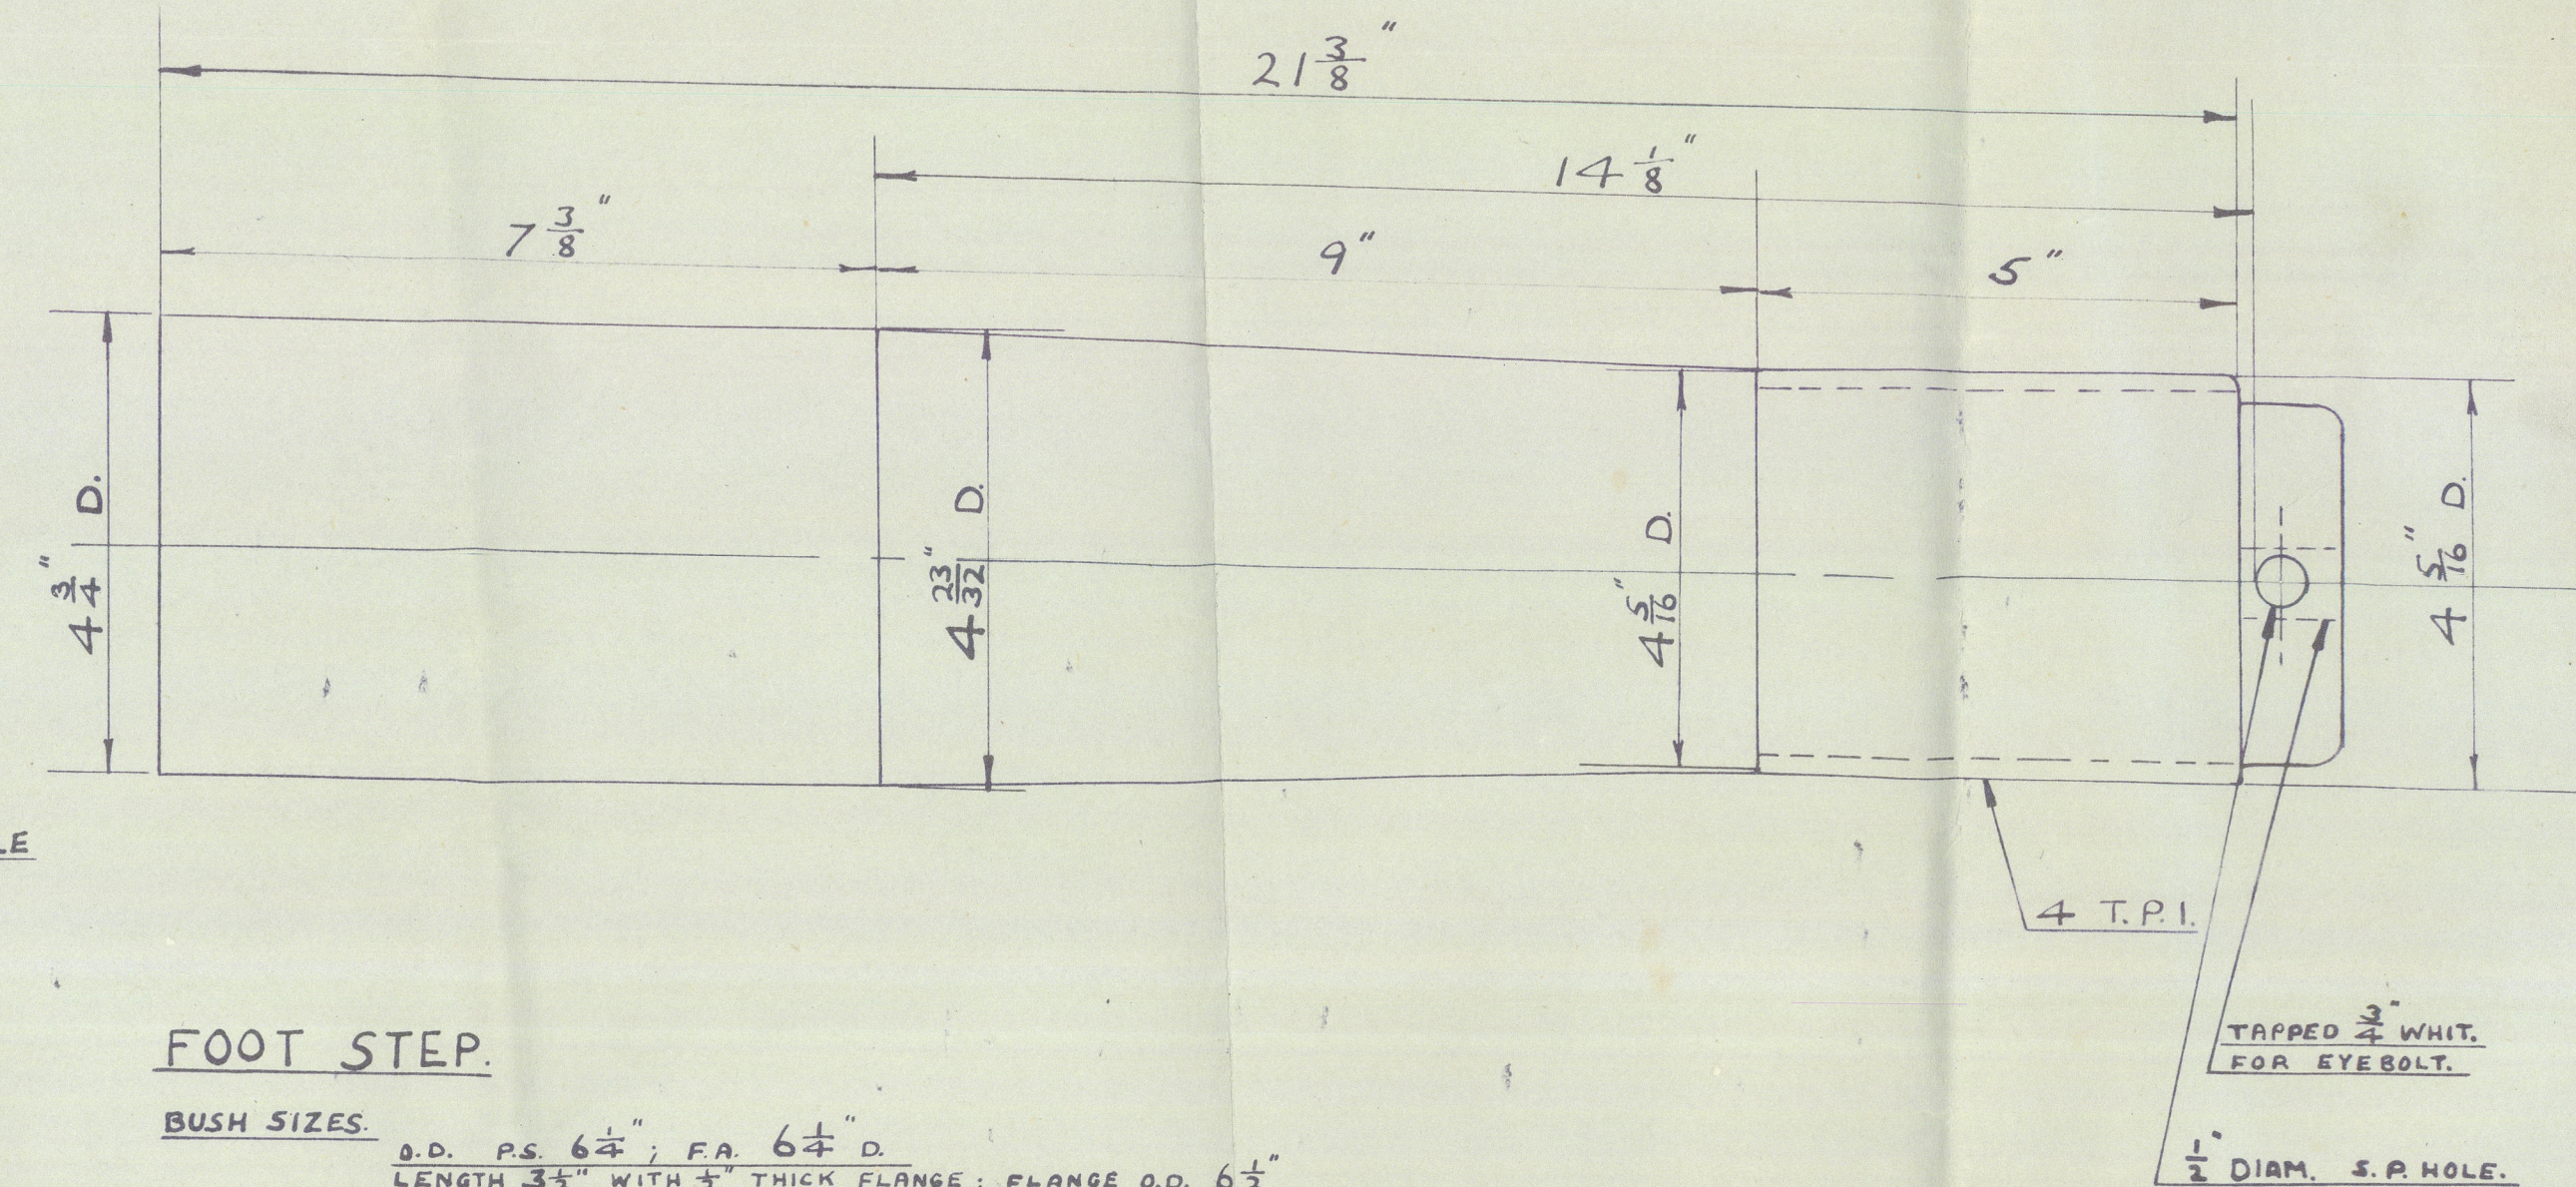

FOOT STEP.

BUSH SIZES.
O.D. P.S. $6\frac{1}{4}$; F.A. $6\frac{1}{4}$ D.
LENGTH $3\frac{1}{2}$ " WITH $\frac{1}{2}$ " THICK FLANGE; FLANGE O.D. $6\frac{1}{2}$

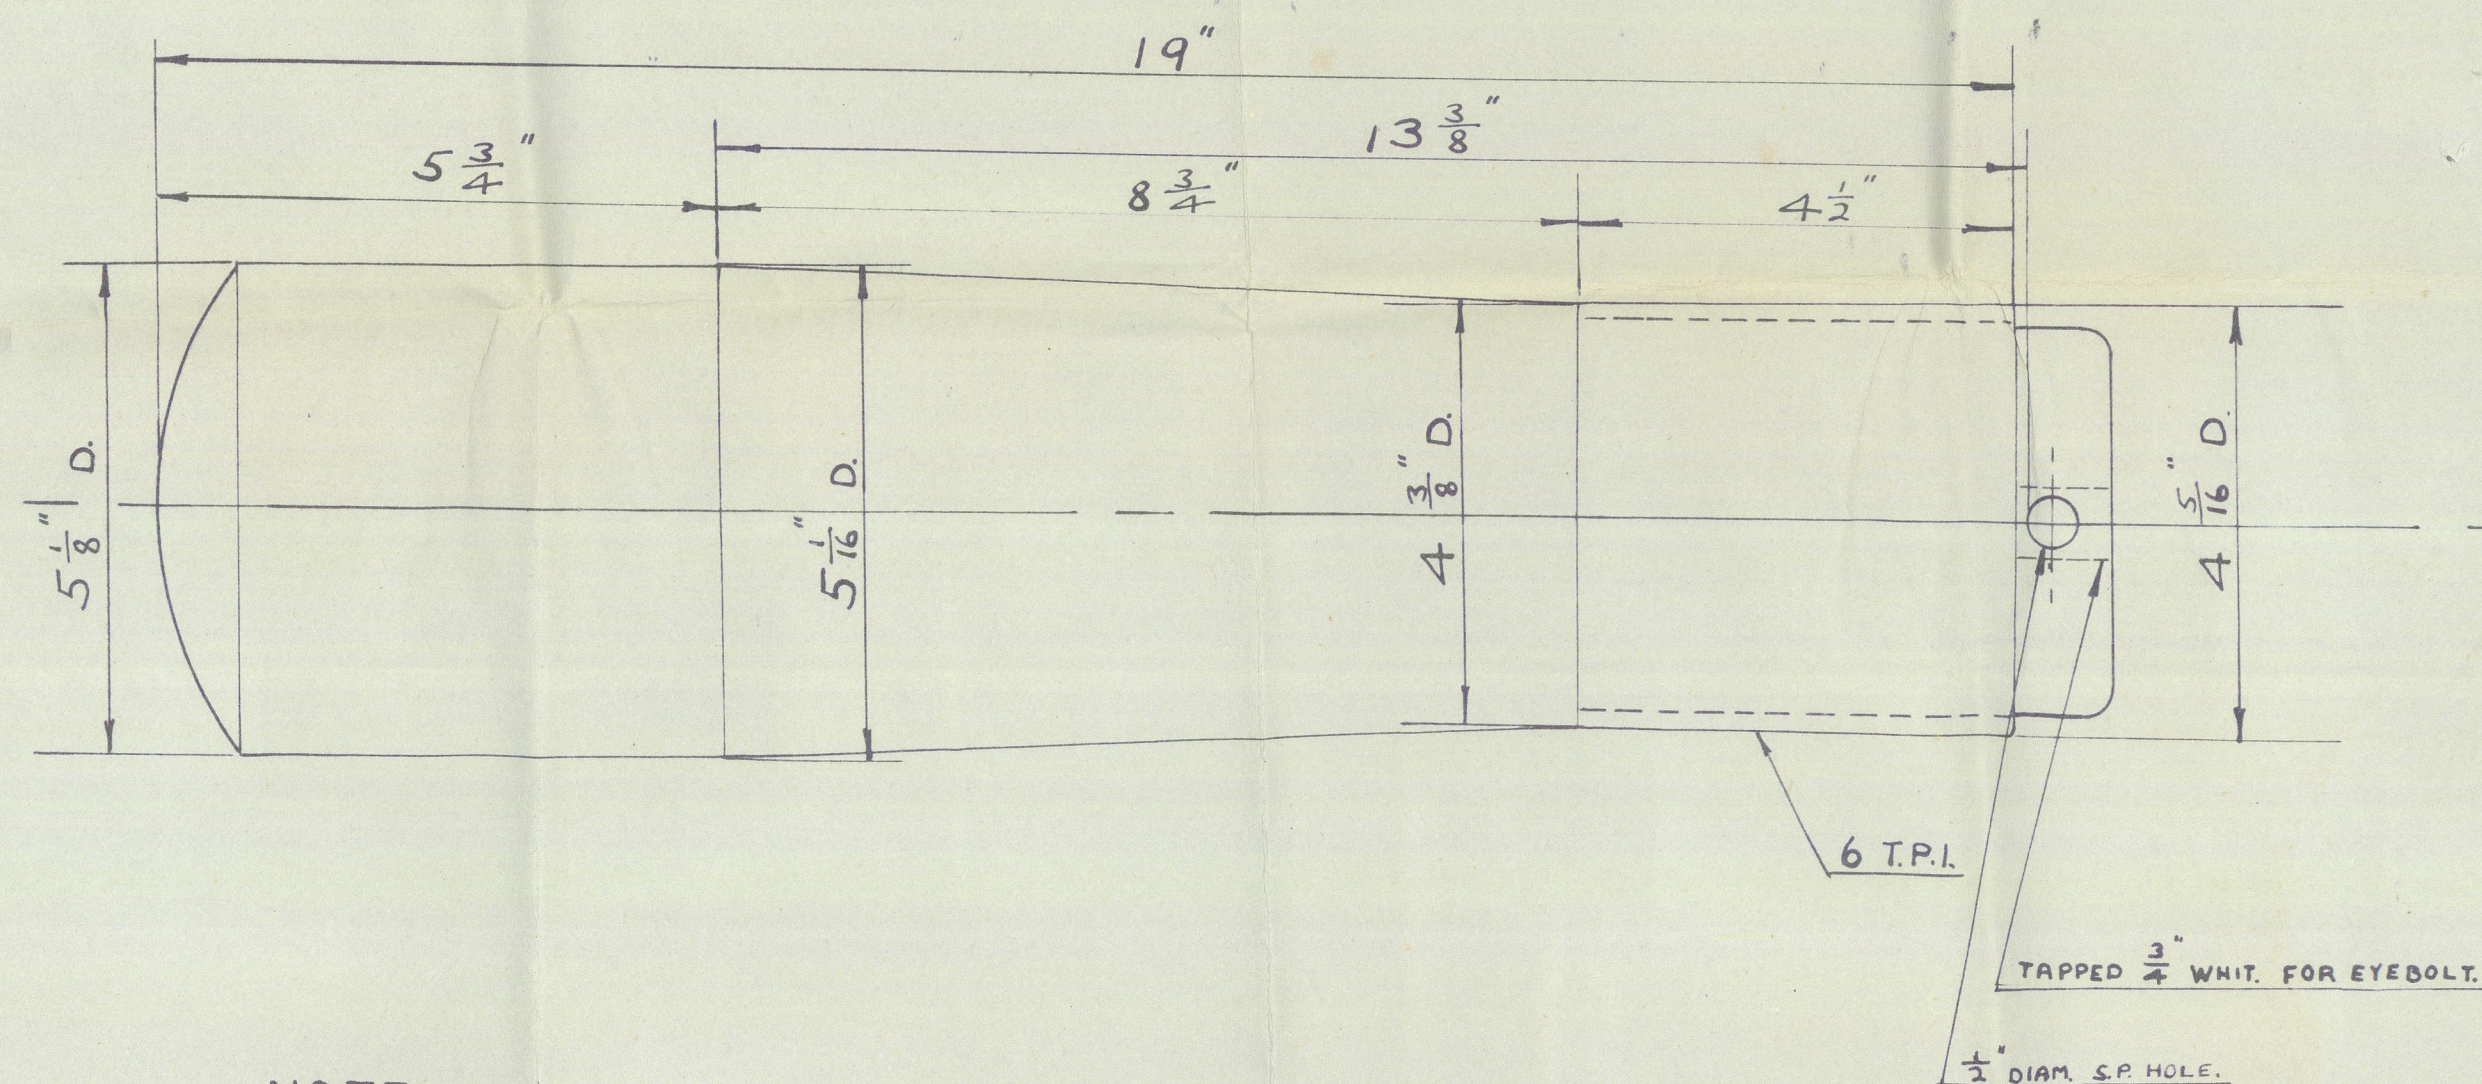

NOTE:-

ALL PINTLES MACHINED IN
WAY OF BUSHES AND REFITTED.
THE ABOVE ARE THE FINAL
SIZES AS FITTED WHEN VESSEL
WAS IN EASTERN ALBERT DRY DOCK
MARCH 1952. ALL BUSHES RENEWED
 $\frac{1}{16}$ " CLEAR IN BORE, AND OUTSIDE
DIAMETER AS GIVEN.

J. RUSSELL & CO. BUTCHERS RD.	
DRAWN BY H. R. G. G.	SHIP M.V. "DEIDO"
BY H. R. G. G.	TITLE:- RUDDER PINTLES
DATE:-	2. 4. 52.
SCALE:- 6" = 1'	DRAWING NUMBER
2155.	

DEIDO

attached to
Lon. Rpt. no. 124586

ladder hntles

003720-003726-0189



© 2020

Lloyd's Register
Foundation