

Mac

ST FYLDEA NEW FORE END FRAMING


FRAMES SPACED 16" FROM N° 68
 TO STEM

RIVETING

FRAMES TO SHELL ABOVE D'S RAKE 3/4" RIV. SPACED 5 1/4" C/S ✓
 " " " D'S RAKE & BELOW 3/4" " " 4 1/8" " ✓
 FRAMES TO FLOORS 3/4" " " 4 1/8" " ✓

ALL NEW FRAMES TO BE JOGGLED

the beam
what work
 FORECASTLE DECK BEAMS 4x3x40. KNEES 12x40
 EXISTING ANGLE RUNNERS UNDER FORE DECK TO BE
 EXTENDED TO FRAME 82

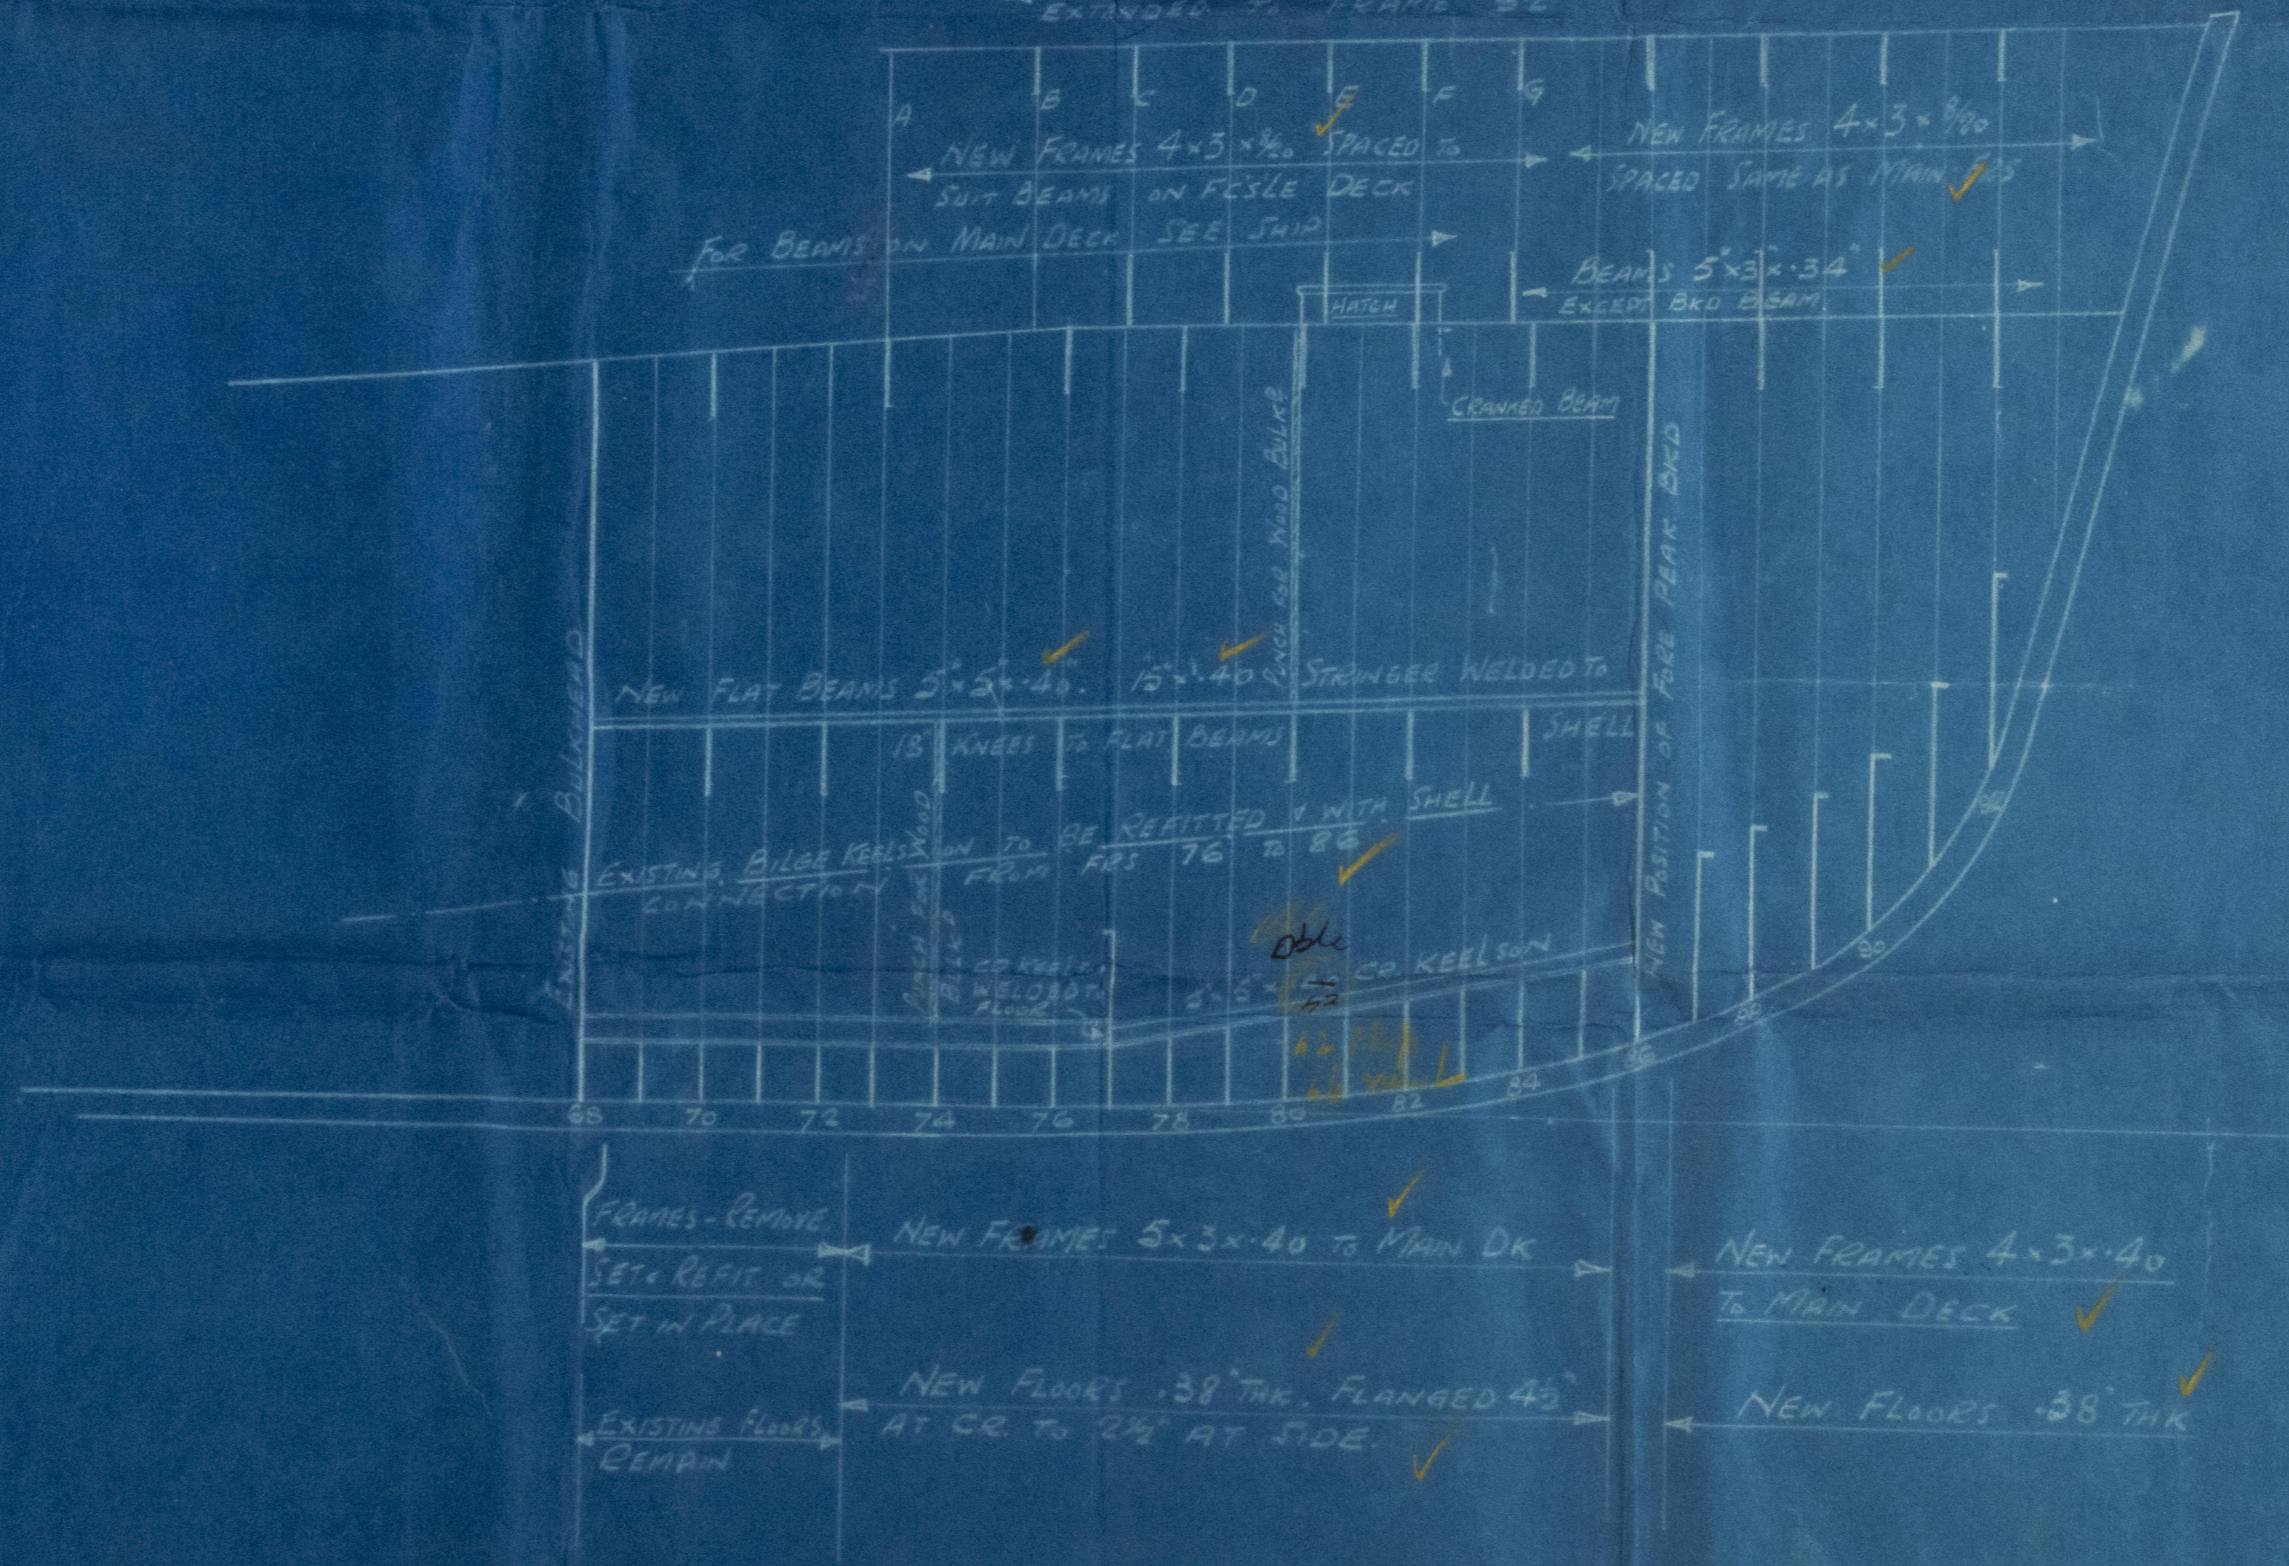

NOTE - ALL FRAMES CUT & BRACKETED AT MAIN DK.



Lloyd's Register
 Foundation

S/ FYL DEA

new fore end framing

Indb. rep. No. 15753.



© 2021

Lloyd's Register
Foundation

003742 - 003749 - 0062