

5/7 "FYLDEA"

ALTERATIONS TO MAIN & FORECASTLE  
DECKS IN WAY OF LENGTHENED FORE END.



SCALE 1/4" = 1'-0"

FRAMES (FORWARD OF N°68) SPACED 16". ✓

NEW NUMERALS.

$$L \times D = 150 \times 14.25 = 2137.5$$

$$L \times (B+D) = 150 \times (24.79 + 14.25) = 5856$$

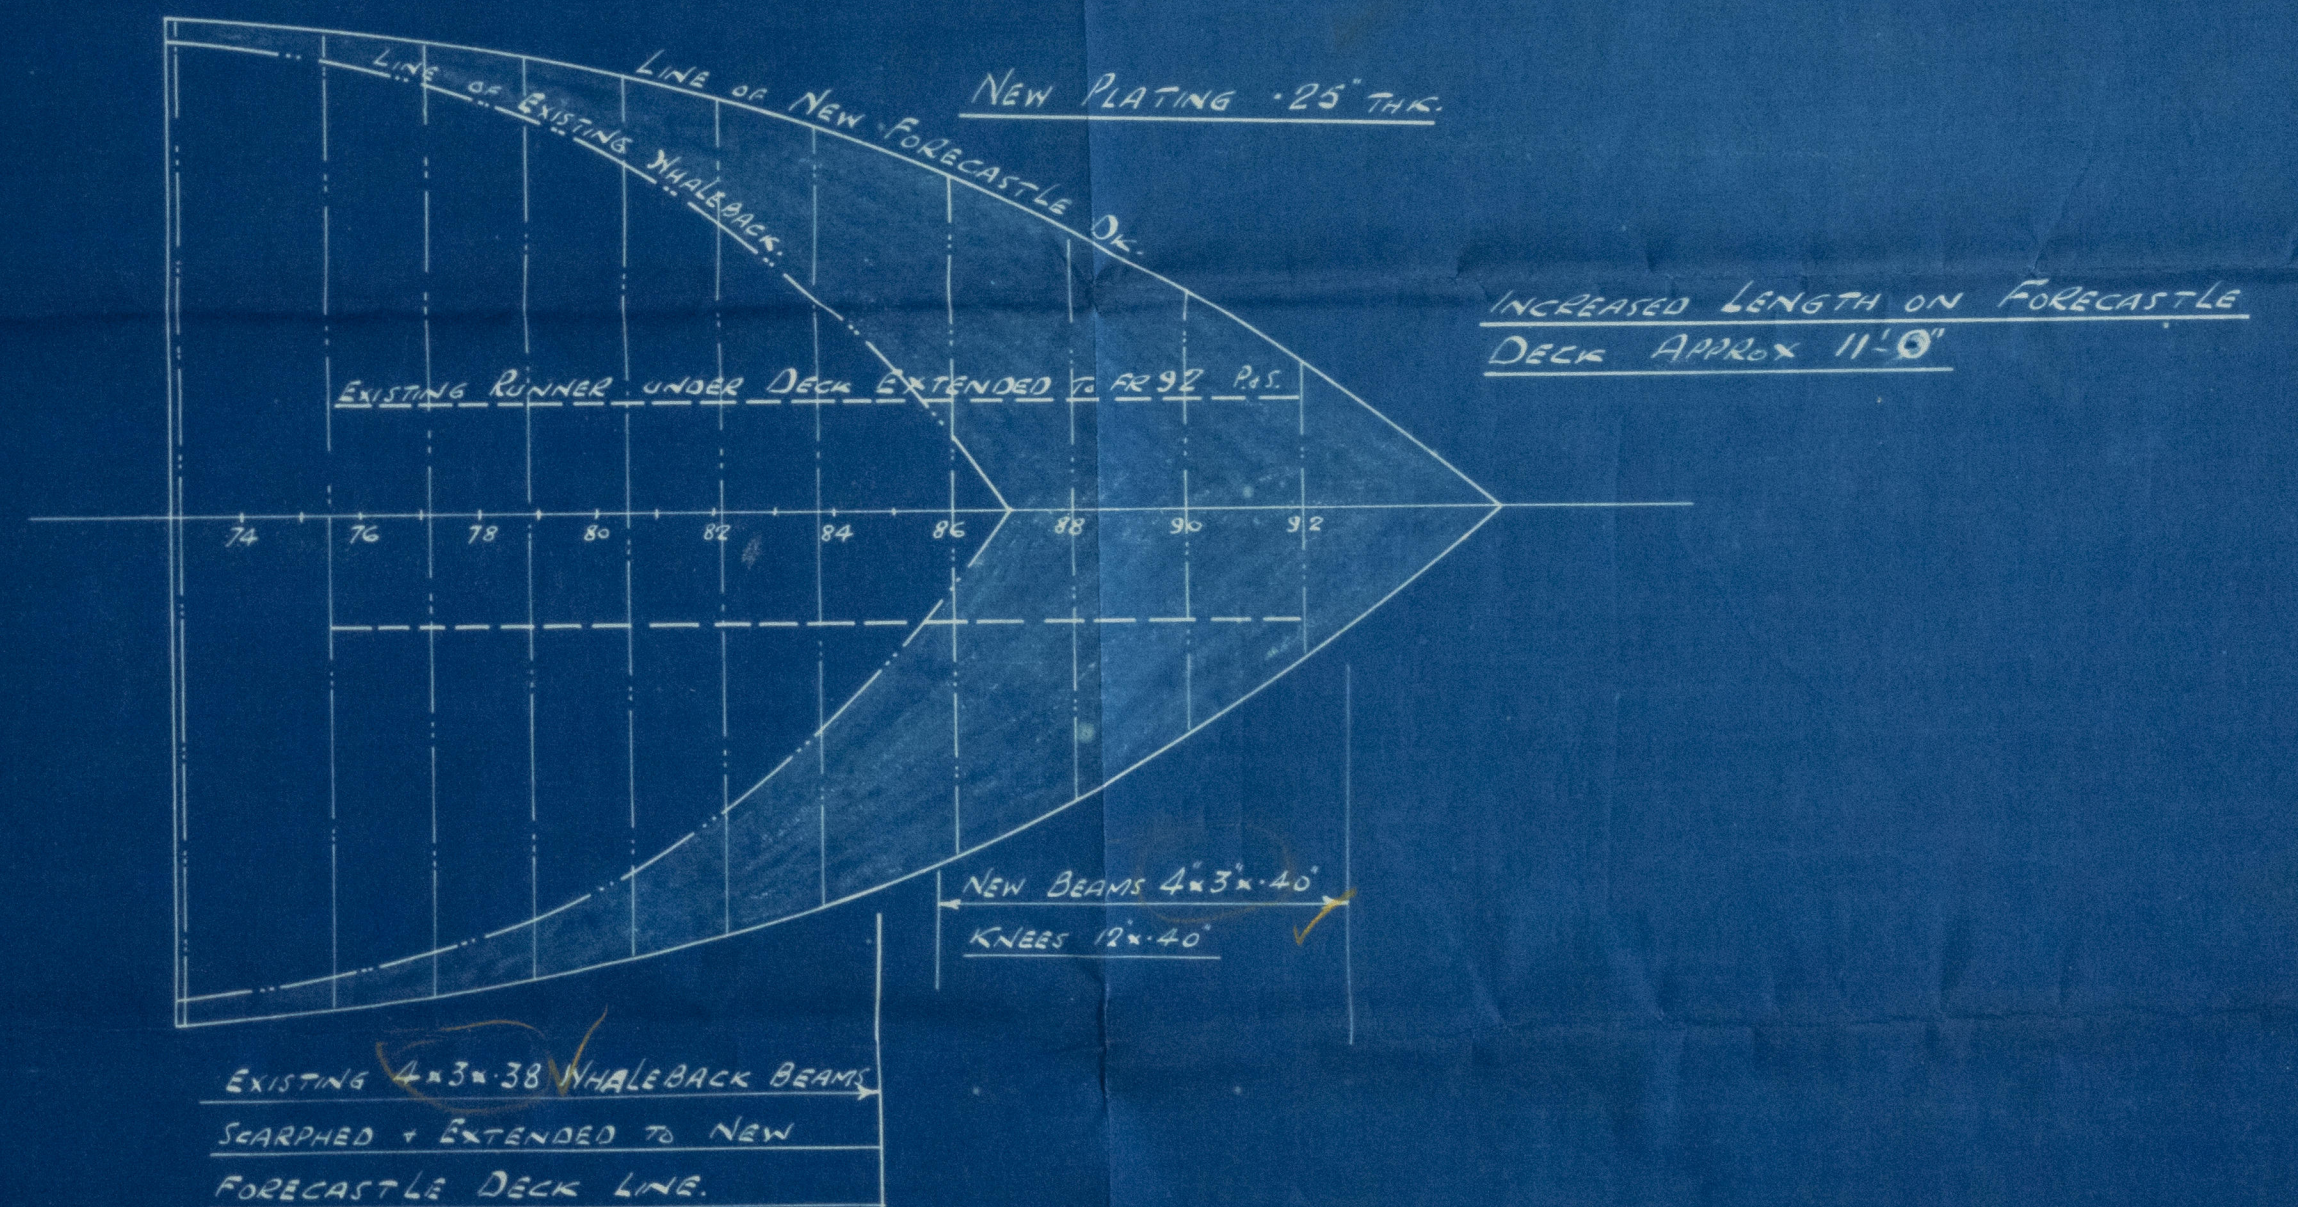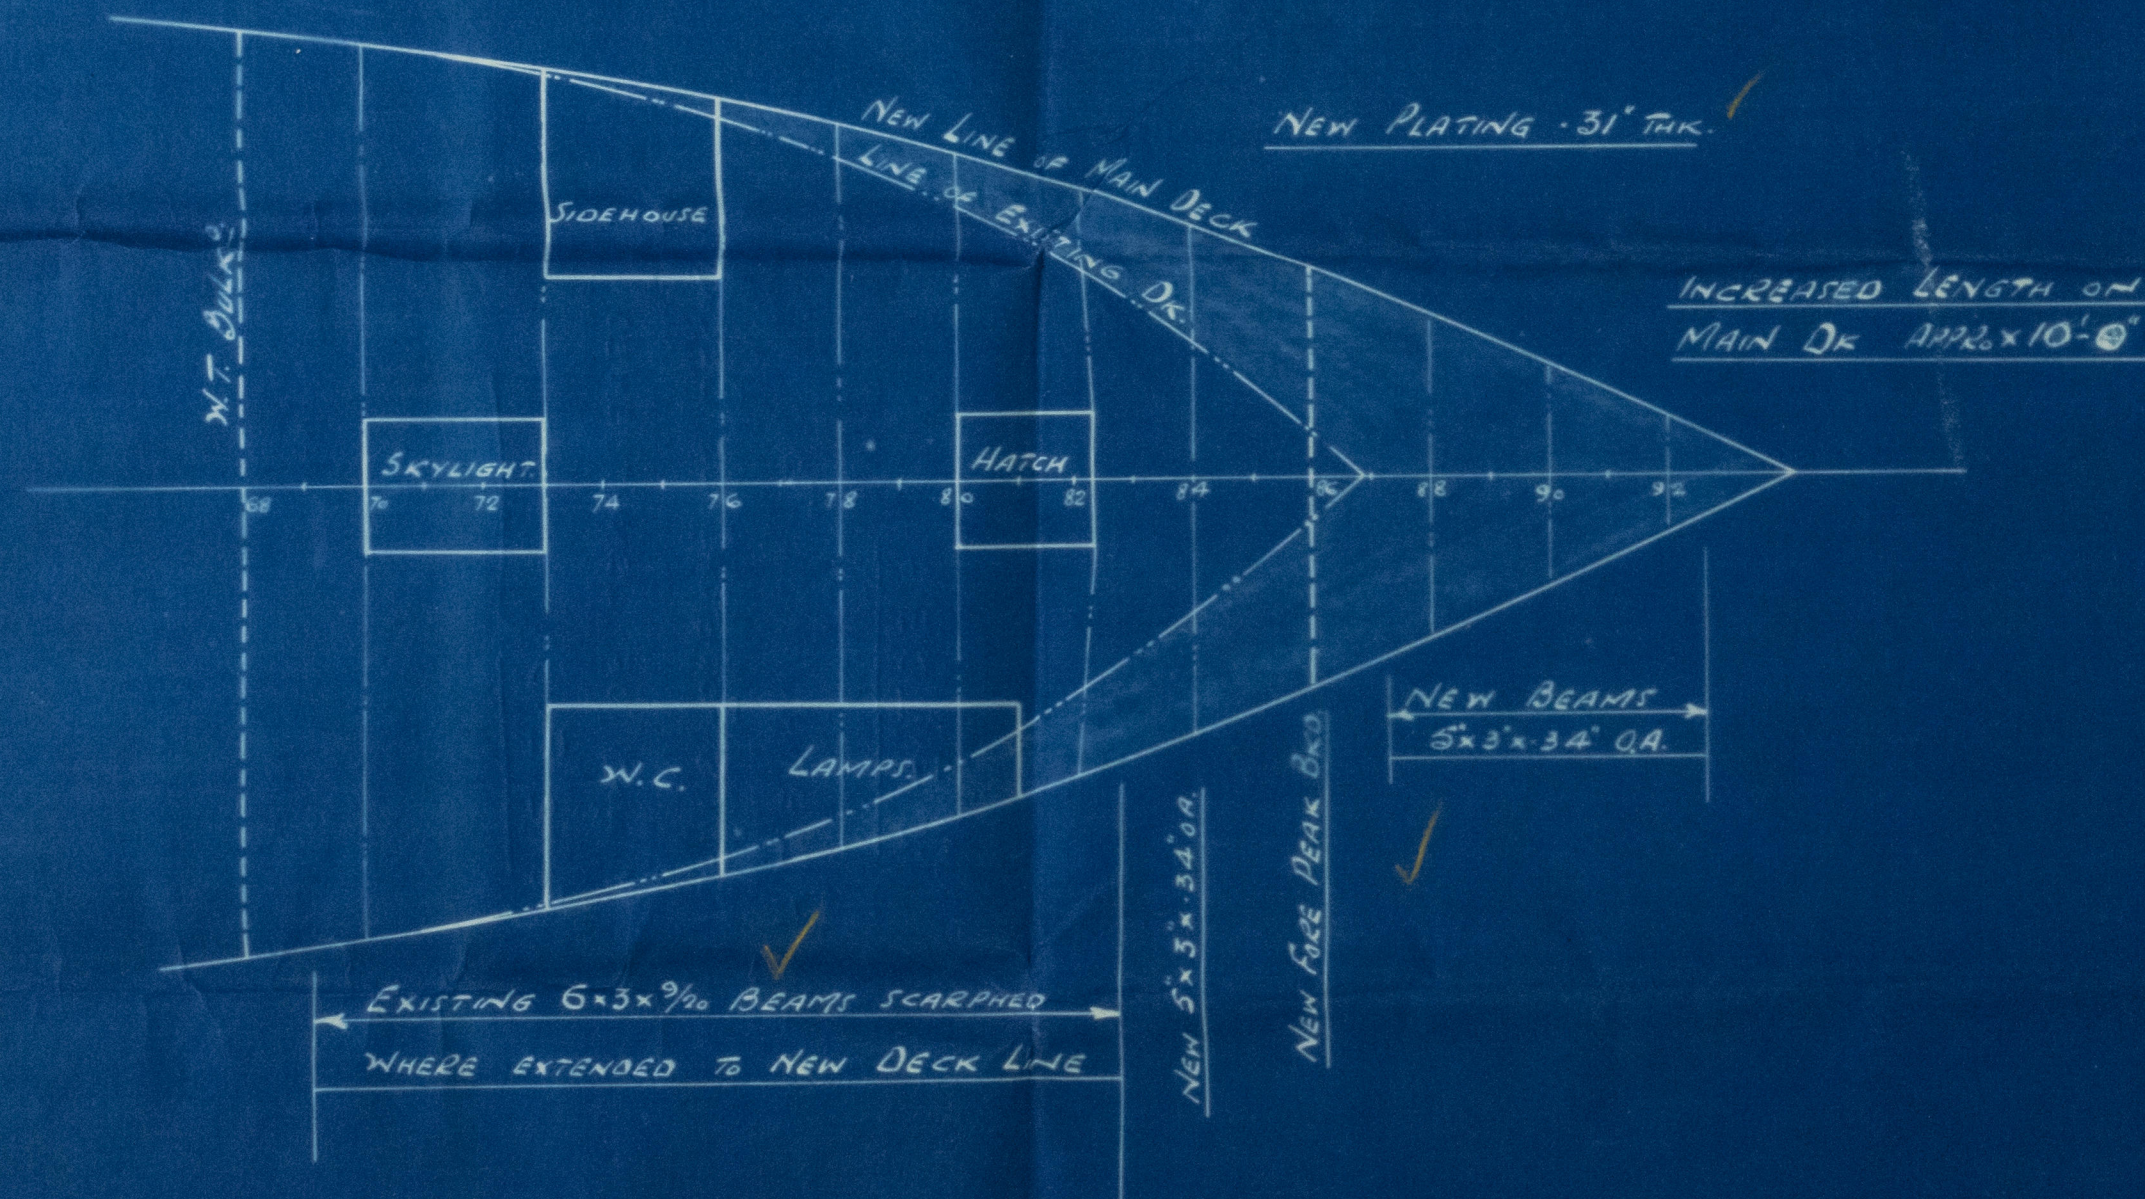

*2d Beam 4' x 3' x 40'*



003742-003743-0033

S/S FYLDEA

ALTERATIONS TO  
MAIN & FORECASTLE DECKS  
IN WAY OF LENGTHENED  
FORE END

Made repl.

No. 75753



© 2021

Lloyd's Register  
Foundation

003742-003749-0063