


MAIN MAST FITTED FOR CARRYING SIGNAL LAMPS & TRYSAIL ONLY

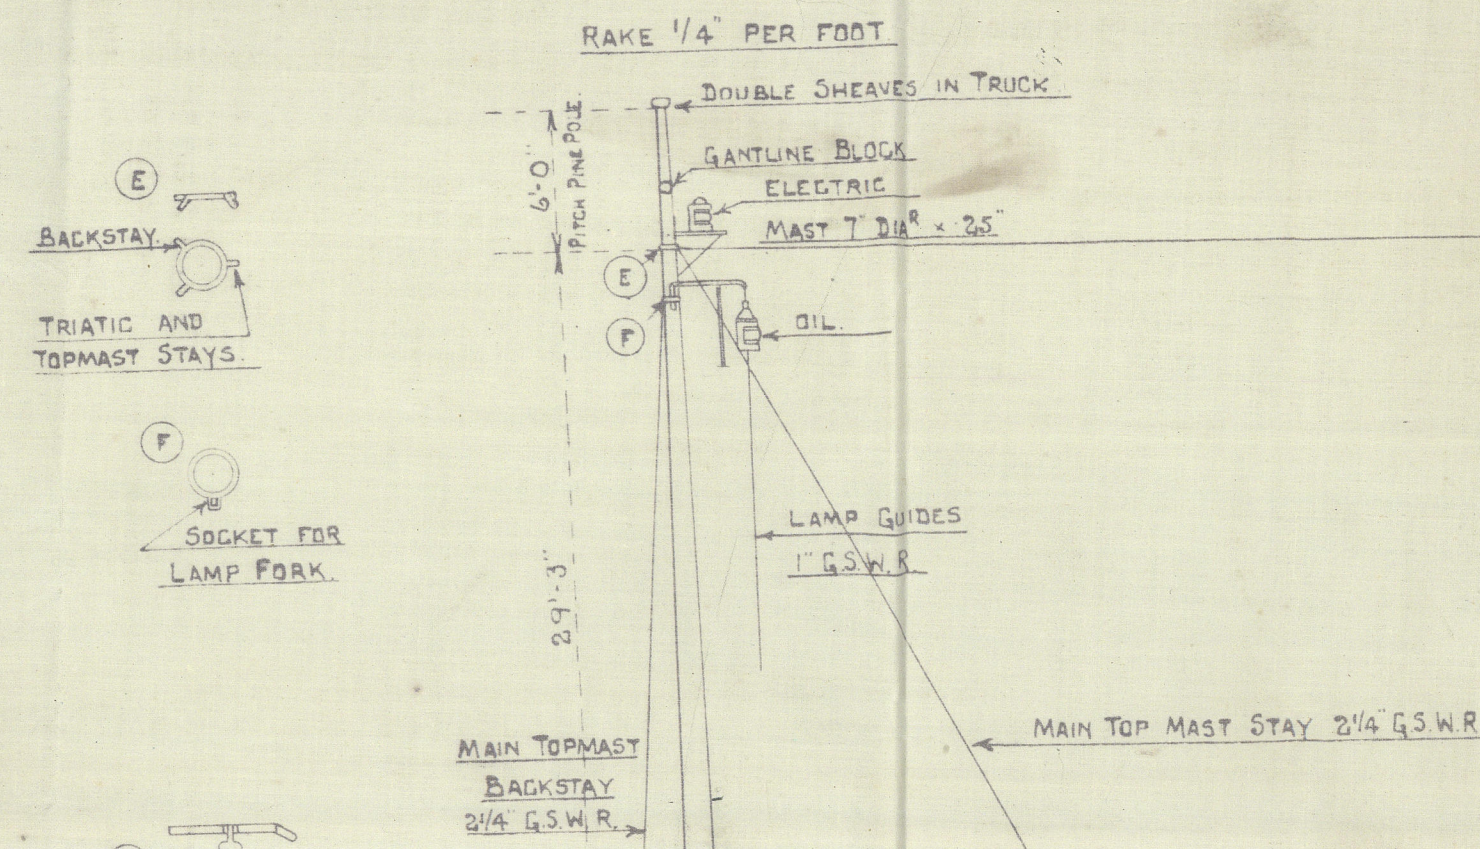


NOS 370 + 371

RIGGING PLAN

SCALE 1/8" = 1 FOOT







These masts are approved and fit a sail only, as it is not possible to guarantee that the loads indicated be taken by the demicks will not be exceeded at any time.

RAKE 1/4" PER FOOT

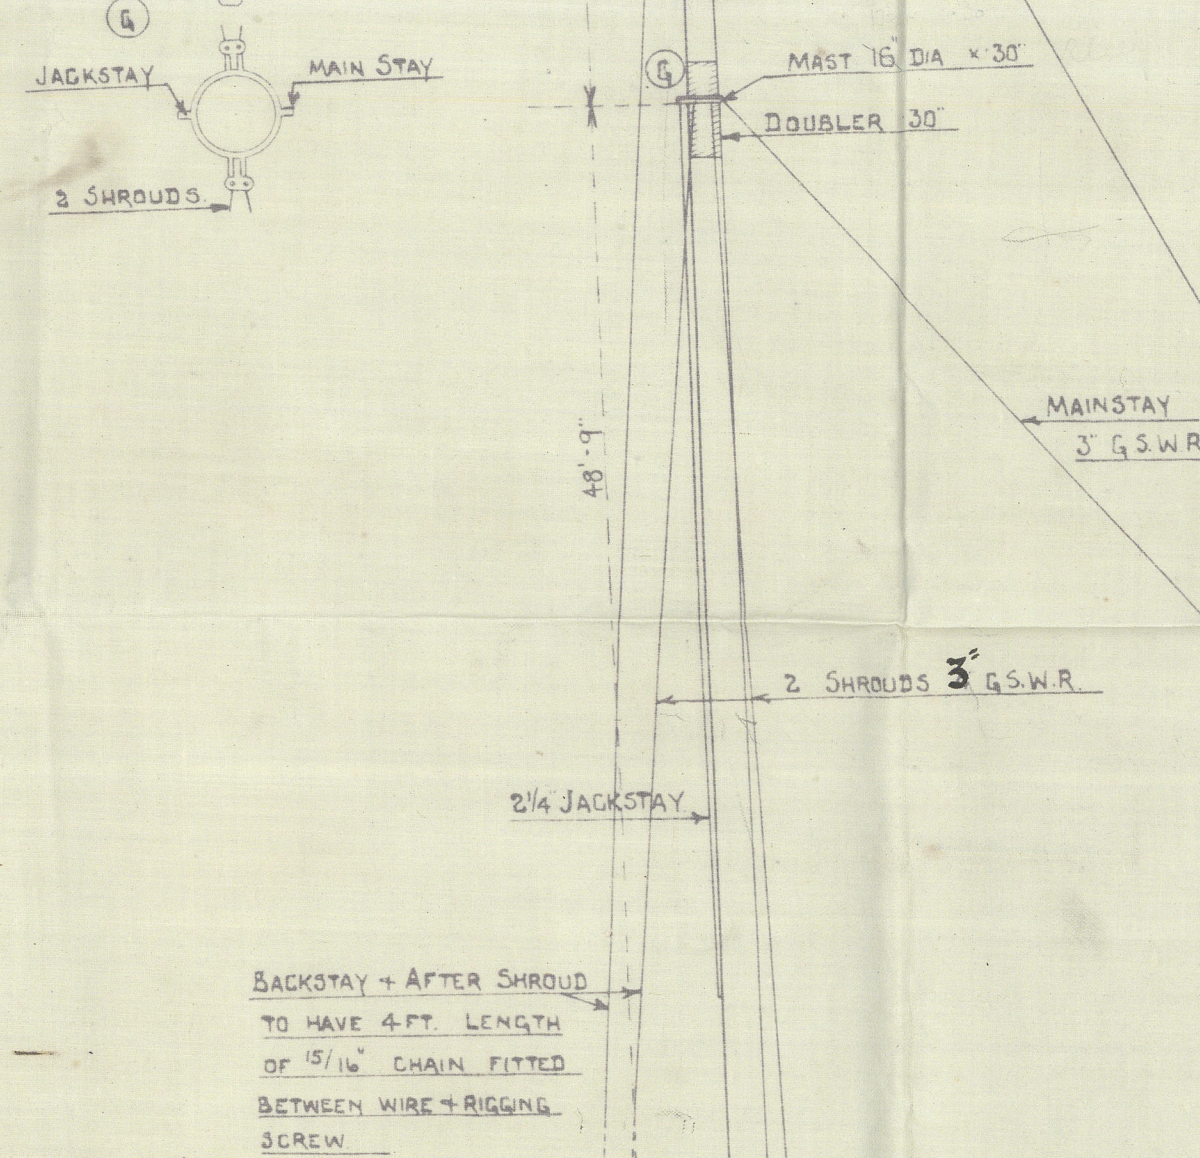

PUNNEL GUYS 2 1/2" G.S.W.R.

THREE STIFFENERS 3 1/2" x 3" x 35" ANGLE TO BE FITTED IN FOREMAST FROM HEEL TO WELL ABOVE FORE STAY BAND & TAPERED OFF GRADUALLY

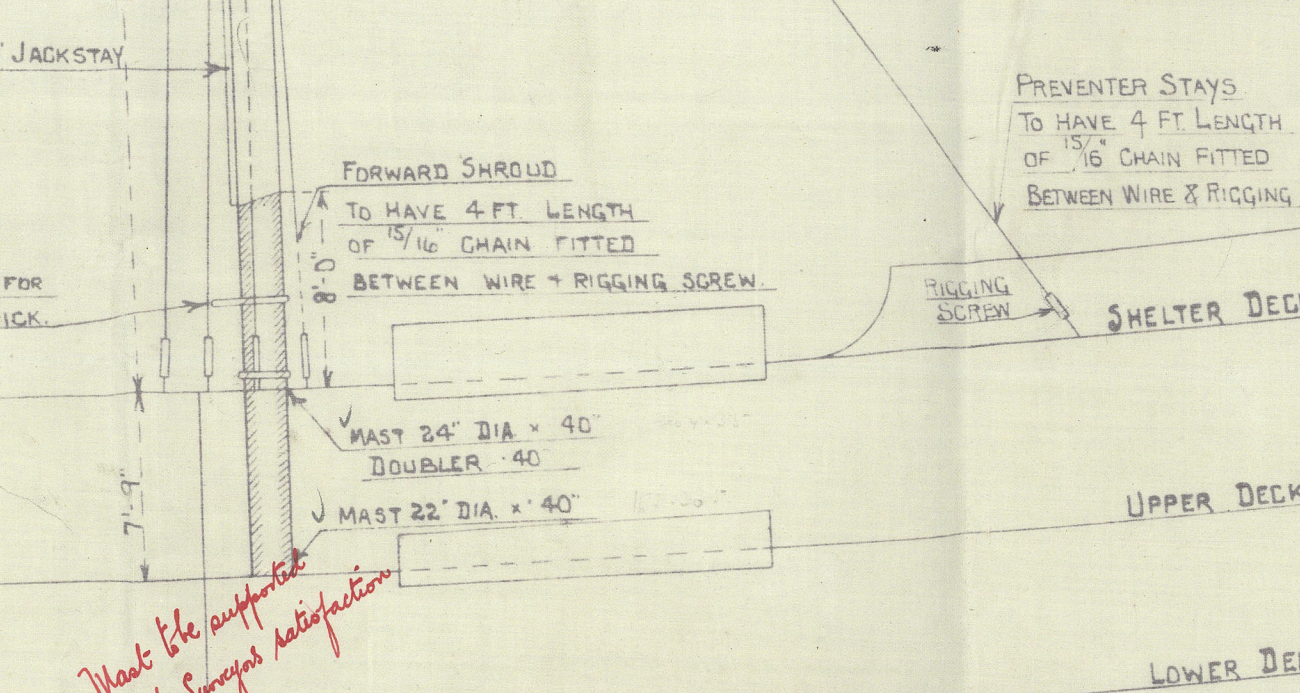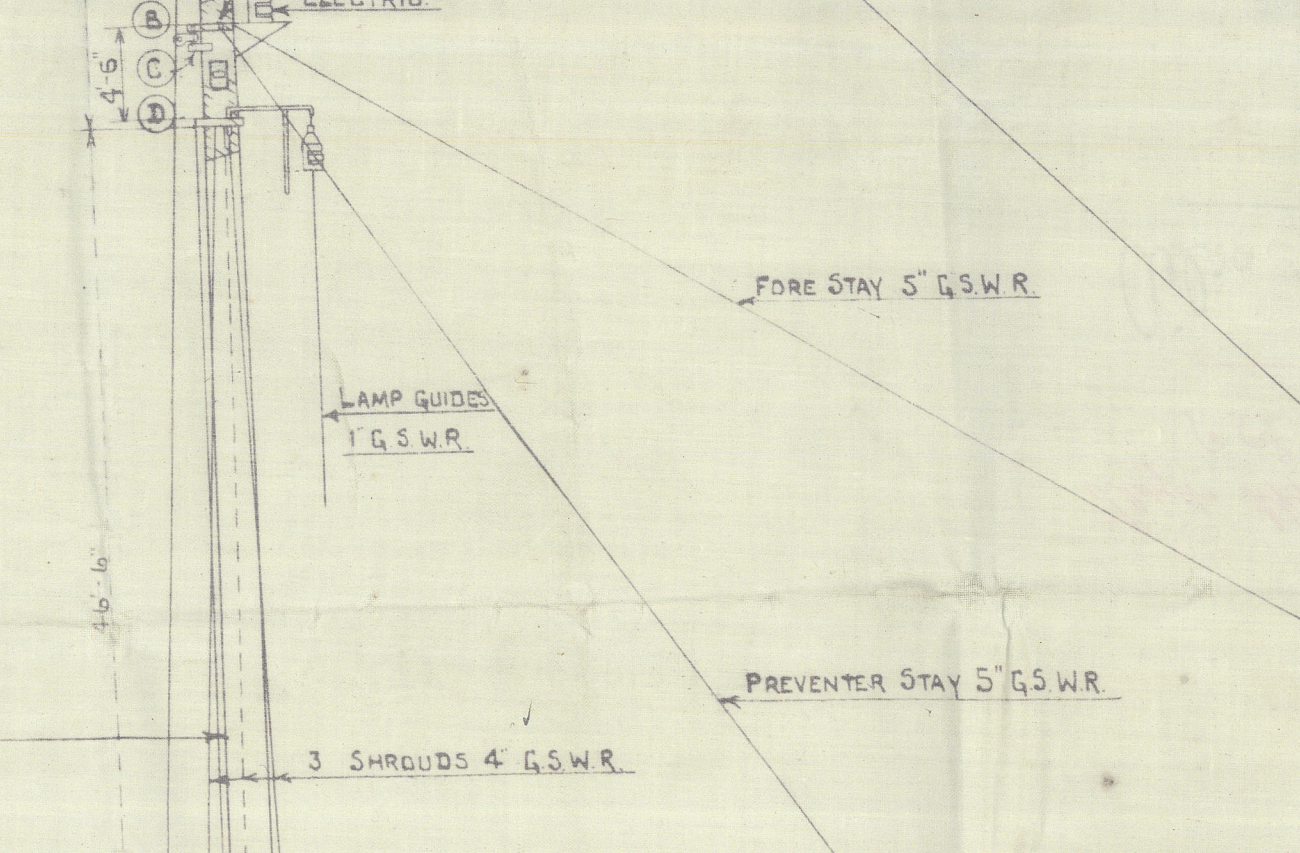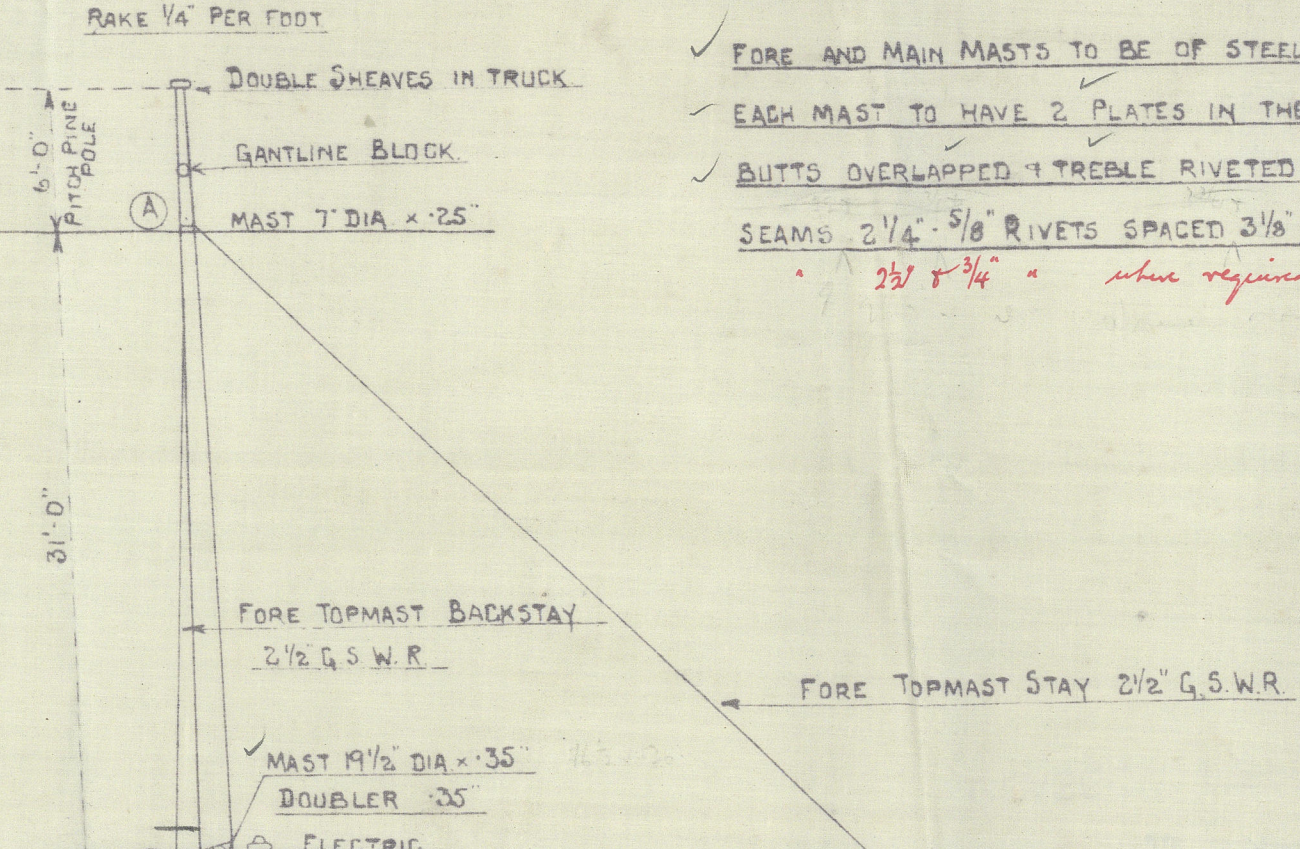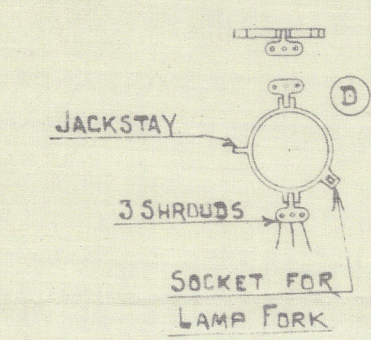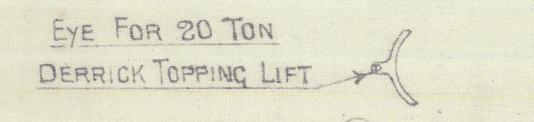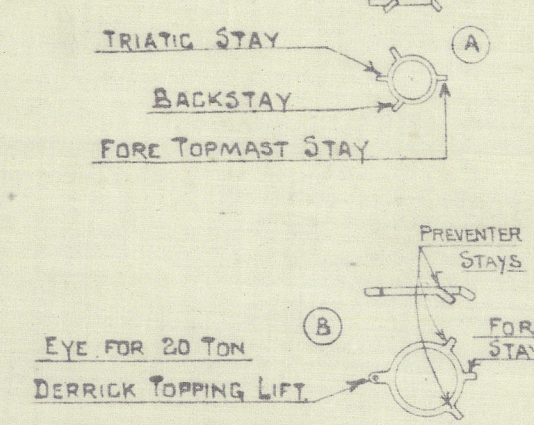

- FORE AND MAIN MASTS TO BE OF STEEL WITH WOOD POLES
- EACH MAST TO HAVE 2 PLATES IN THE CIRCLE SEAMS SINGLE RIVETED
- BUTTS OVERLAPPED & TREBLE RIVETED ABOVE DECK DOUBLE BELOW DECK
- SEAMS 2 1/4" - 5/8" RIVETS SPACED 3 1/8" OR TO CR - 5/8" RIVETS IN BUTTS
- 2 1/2" x 1/4" where required by Rules

FORE TOPMAST STAY 2 1/2" G.S.W.R.

FORE STAY 5" G.S.W.R.

PREVENTER STAY 5" G.S.W.R.



MAST 24" DIA x 40" DOUBLER 40"

MAST 22" DIA x 40"

GOOSENECK FOR 20 TON DERRICK


SHelter DECK

UPPER DECK

LOWER DECK

APPROVED
LLOYD'S REGISTER OF SHIPPING

Y. M. Jones
DATE 21. 8. 19

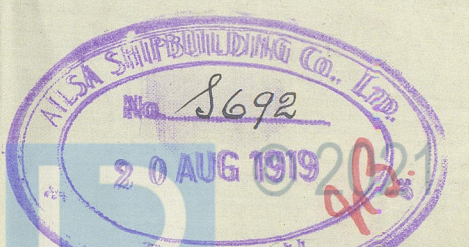

Lloyd's Register Foundation

003742-003749-0157

Lloyds Approved Rigging Plan
S.S. No. 370-1

Ailsa. Co. No. 370-1.

S.S. "Haleyon."

GLASGOW REPORT No. 40409



© 2021

Lloyd's Register
Foundation

003742-003749-0157