

SHIP NOS. 650 & 51.  
MIDSHIP SECTION.

PRINCIPAL DIM<sup>NS</sup> 175'-0" B.P. x 30'-0" MLD x 16'-0" D. MLD.

CLASS. 100 A.I. STEAM TRAWLER.

SCALE  $\frac{1}{2}$ " = 1 FOOT.

COOK WELTON & GEMMELL. LTD

SHIPBUILDERS


BEVERLEY

## EQUIPMENT

1	STOCKLESS ANCHOR	13 CWTs	✓
1	"	12 CWTs	✓
1	RODGERS ANCHOR	4½ CWTs (EX STOCK)	✓
150 FATHOMS	1½" STUD LINK CABLE		
60 FATHOMS	6" HAWSER		✓
60	"	6" WARP	✓

LLOYDS NUMERALS

D ..... 16.00 ✓  
B + D ..... 46.00 ✓  
L x D ..... 2800.00 ✓  
L x (B + D) ..... 8050.00 ✓  
"a" ..... 14.41 ✓  
L/D = 10.94      L/B = 5.85 ✓

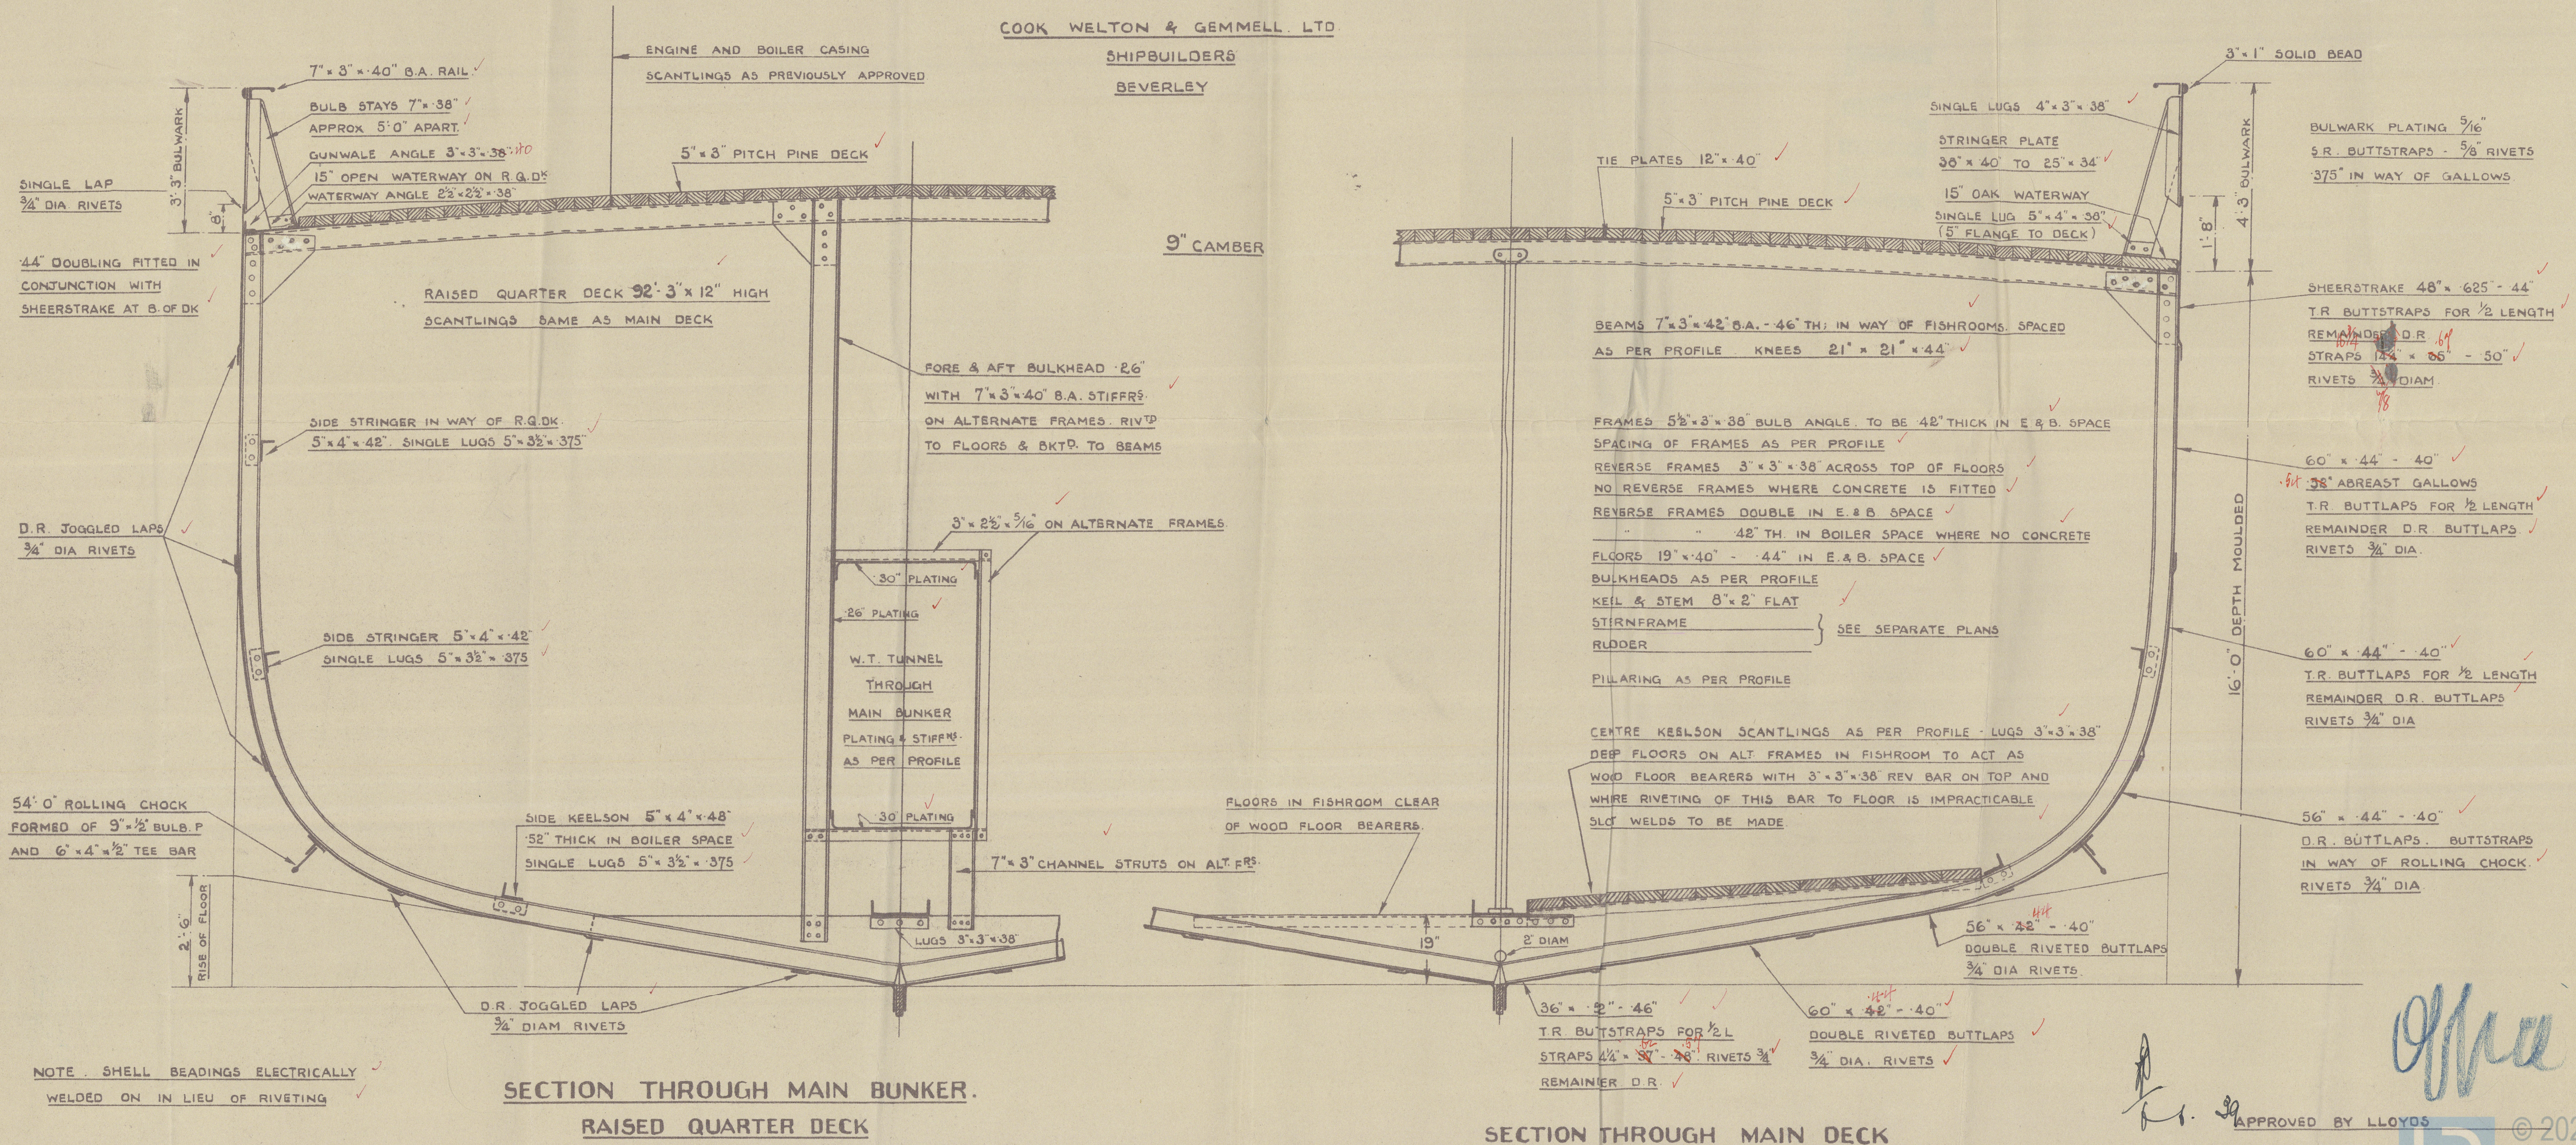

APPROVED BY LLOYDS

© 202

Lloyd's Register  
Foundation

003742-003749.022




RETAIN

HULL

Book, W. Nelson & Gemmell, Ltd  
Beverly

Yard No. 650-651

Modship Section

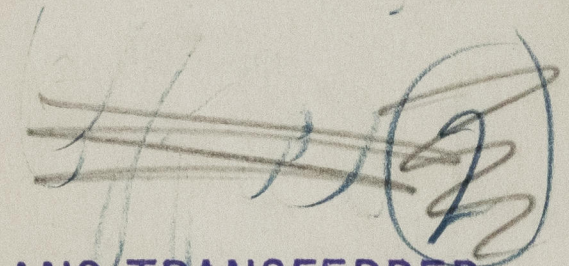

PLANS TRANSFERRED  
TO SISTER VESSEL

~~Mod. 43855~~ 650 "Lady Lilian"  
~~" 45088~~ 651 "Lady Madeleine"  
& N.N. "KINGSTON" DIAMOND  
DUP. PLAN BOX

No. 23

003742-003749-0221



© 2021

Lloyd's Register  
Foundation