

# STERNFRAME NOS 650-51.


HOLES PITCHED 4" & 2 1/4" FROM INNER EDGE OF POST  
HOLES DRILLED FOR 1" DIA. RIVETS 5 DIAS APART.

SCALE 3/4" = 1 FOOT.


MATERIAL TO BE FORGED SCRAP STEEL.

*Approved for rudder head  
by 7 1/2"*

NOTE:- "HYDROGAP"  
RUDDER FITTED

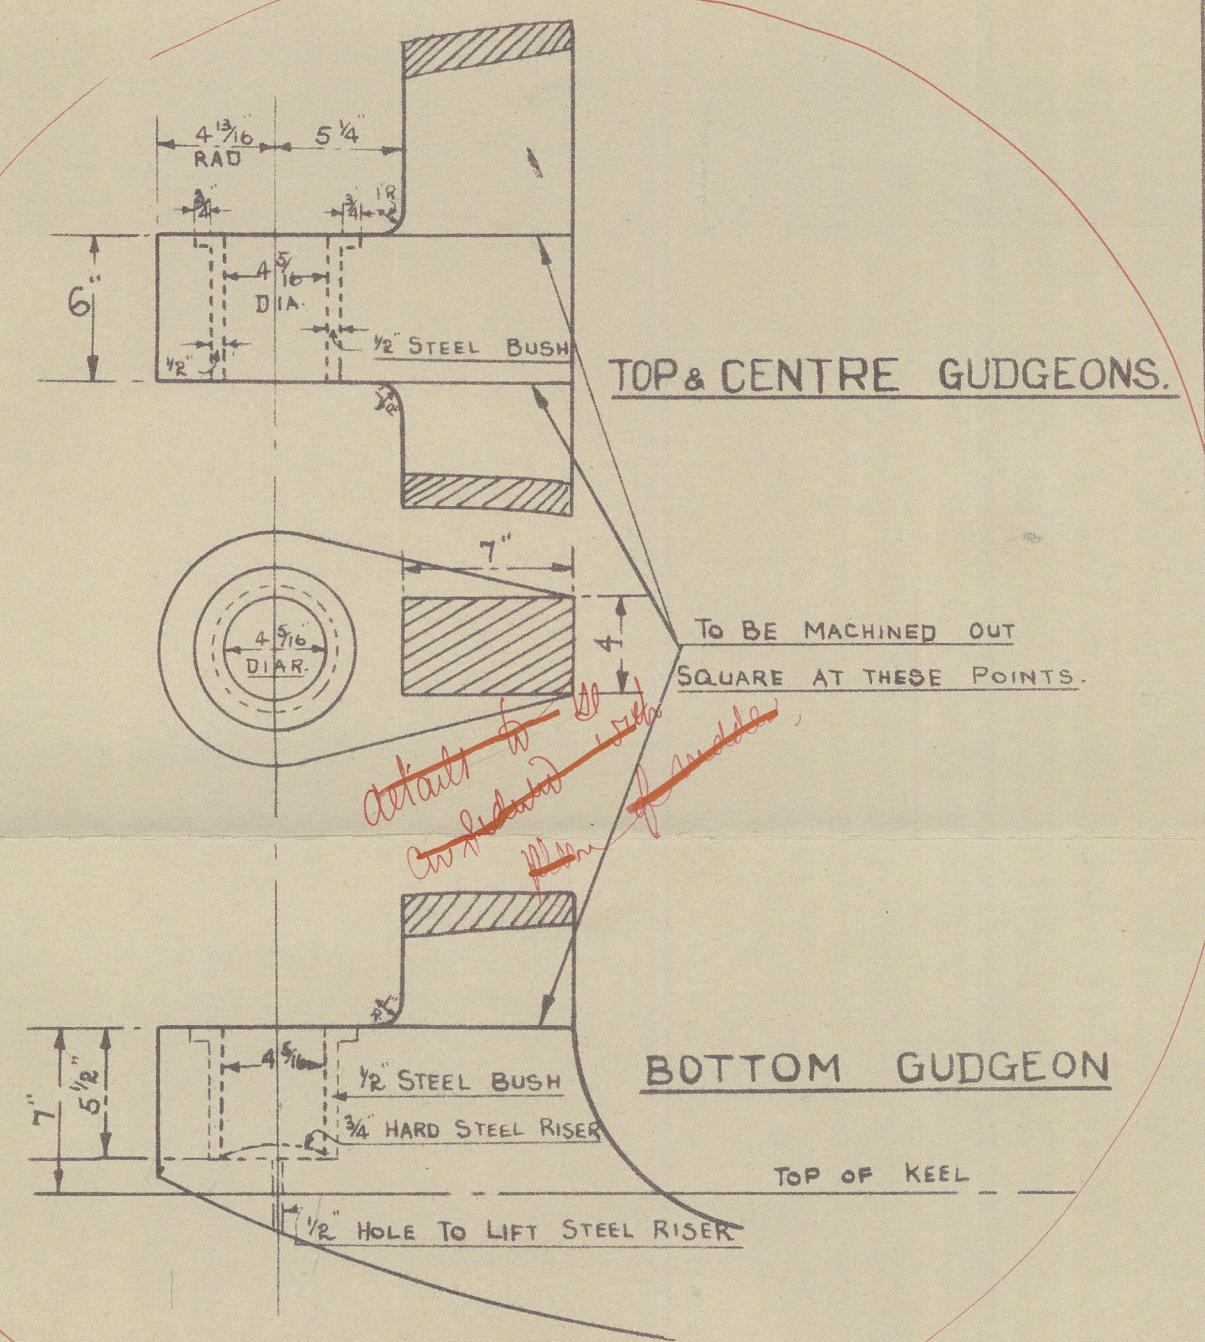

DETAIL OF GUDGEONS  
SCALE 1 1/2" = 1 FOOT.

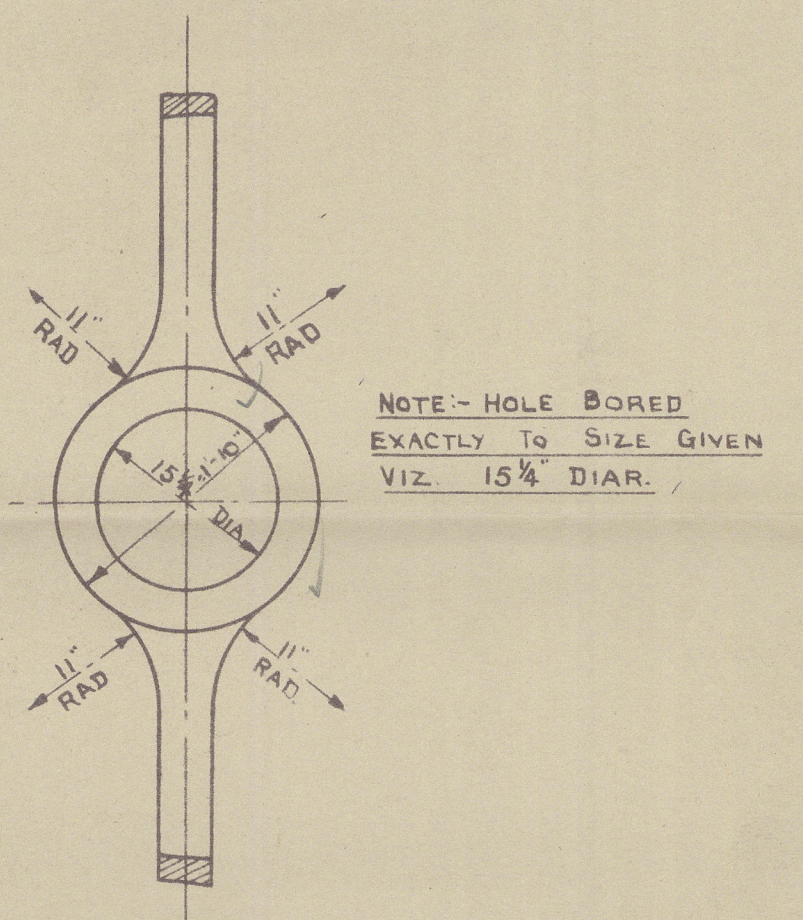

*Office*

COOK WELTON & GEMMELL LTD.  
SHIPBUILDERS  
BEVERLEY.

APPROVED By Lloyd's



HULL

Book, Nelson & Gemmel Ltd.,

Beverley

Yard No. 650 - 651

Sternframe

4

PLANS TRANSFERRED  
TO SISTER VESSEL

\* Kingston Diamond \* Apr

~~14th 43635~~  
" ~~46038~~

650 "Lady Lilian"

651 "Lady Madeleine"

~~DUP. PLAN BOX~~

~~No. 23~~



© 2021

Lloyd's Register  
Foundation

003742-003749-0223