


5-11-51.

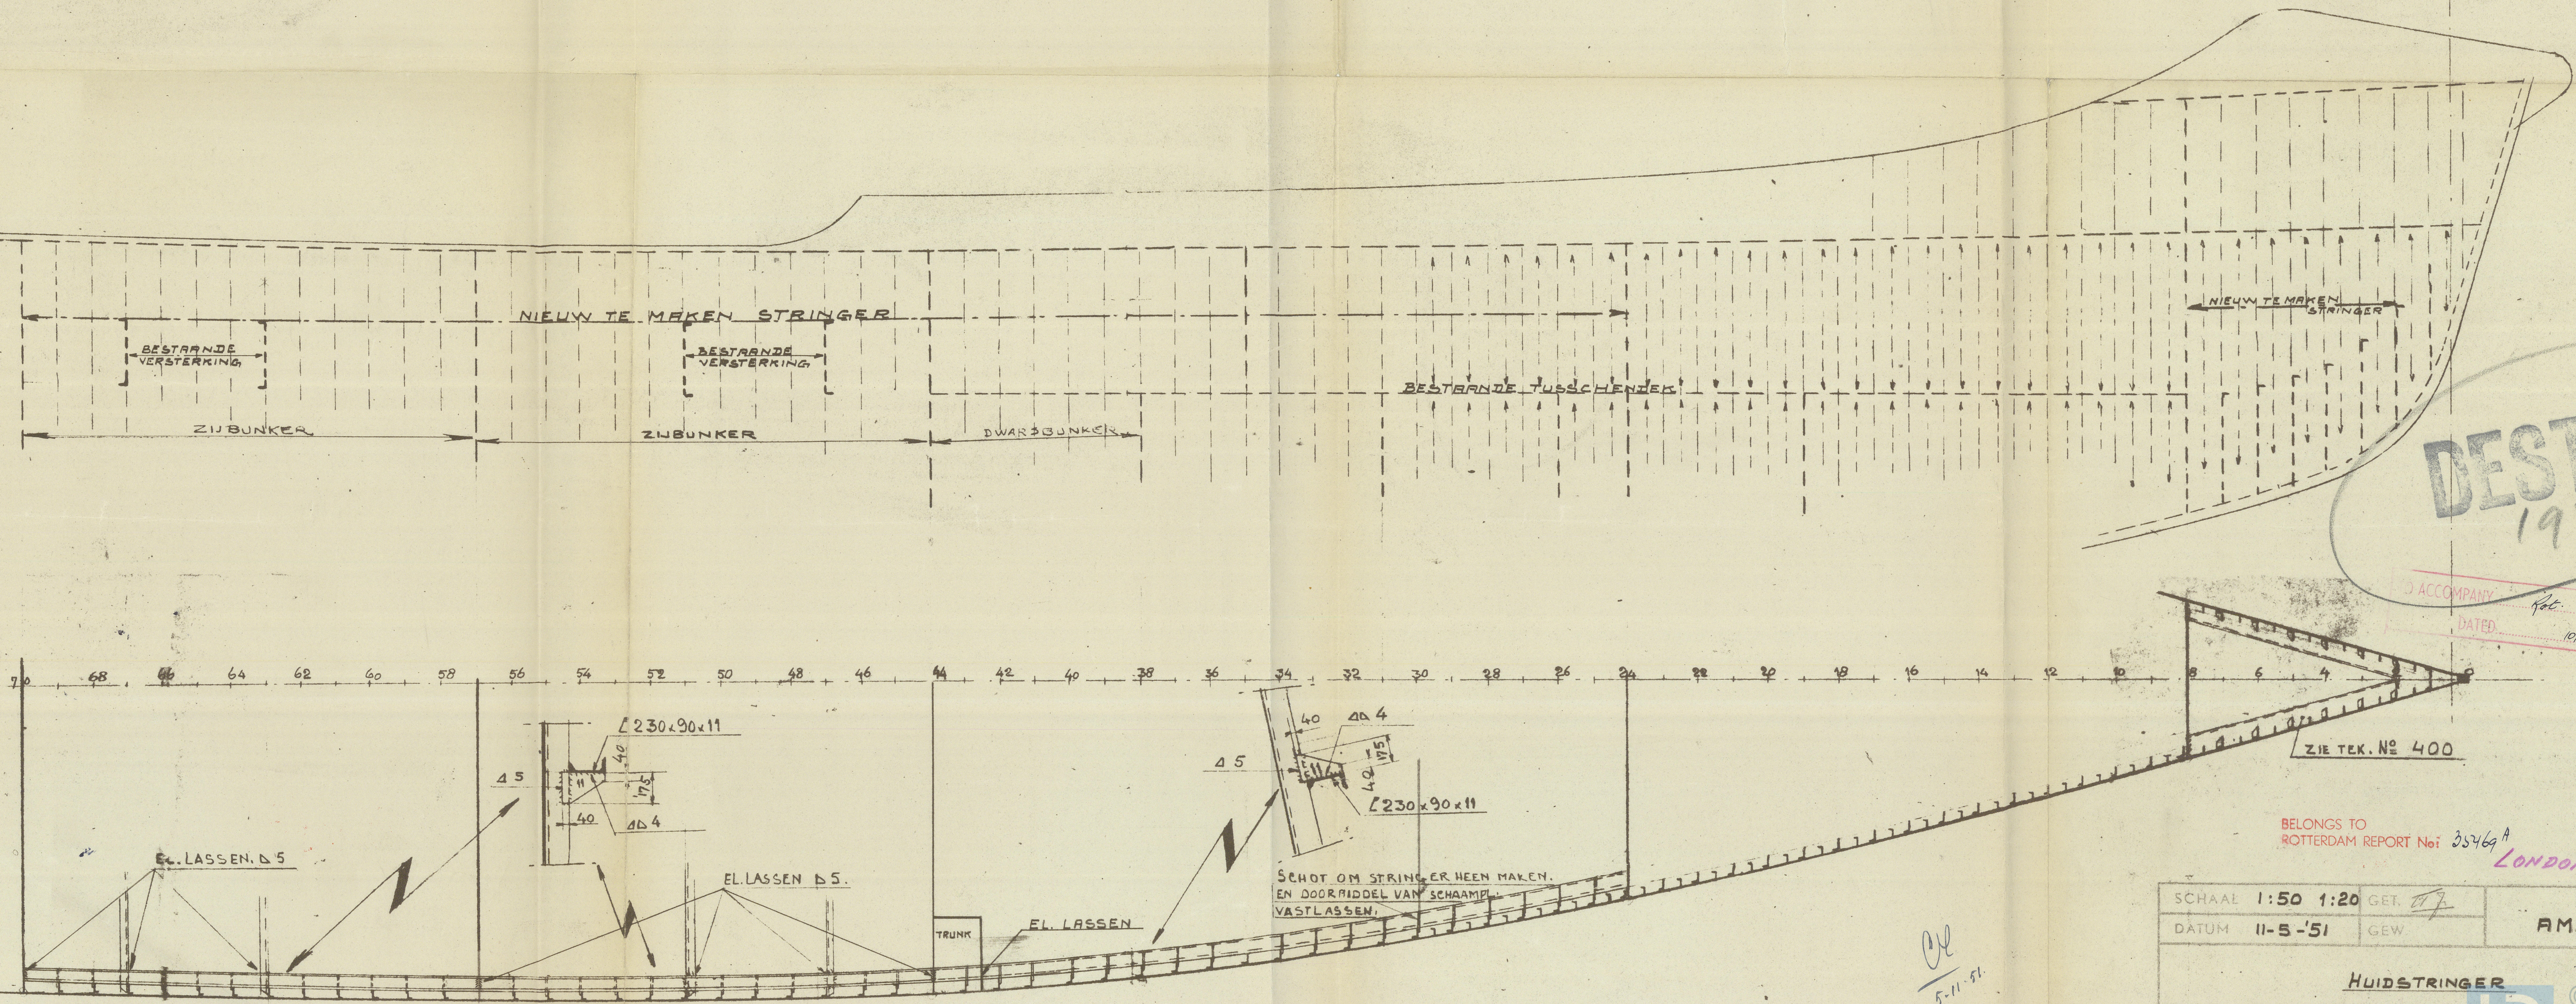

DESTROY
1976

TO ACCOMPANY
DATED
REPORT No. 25th 47.
10.52.

ZIE TEK. N° 400

BELONGS TO
ROTTERDAM REPORT No: 35469 A

LONDON COPY.

SCHAALE 1:50 1:20	GET. 17	AM. 1-16
DATUM 11-5-'51	GEW.	
HUIDSTRINGER		
WERF DE HOOG N.V. ROTTERDAM		
ORDER	TEEK	BLAT
		407

© 2021
Lloyd's Register
Foundation

003742-003749-0283