




O.W.S. WEATHER OBSERVER (EX "MARGUERITE")

GENERAL ARRANGEMENT. (AS FITTED)
UPPER & LOWER DECKS & HOLD.

3 SHEETS — SHEET 3.
SCALE: $\frac{1}{4}$ " = 1 FOOT.

SHEERNESS
C C 26364
7-8-1947

ABBREVIATIONS.
S.M. COASTHOOD.
S.R. STEAM RADIATOR.
S.P. ELECTRIC PUMP.
S.T. TOWER.
S.B. BUNKER.
S.C. TOWER CABINET.
S.W. WARDROBE.
S.B. BUREAU.
S.D. DRESSING DESK.
S.F. FIRE EXTINGUISHER.
S.T. TELEPHONE.
S.H. HULL AREA.
S.W. WASH BASIN.

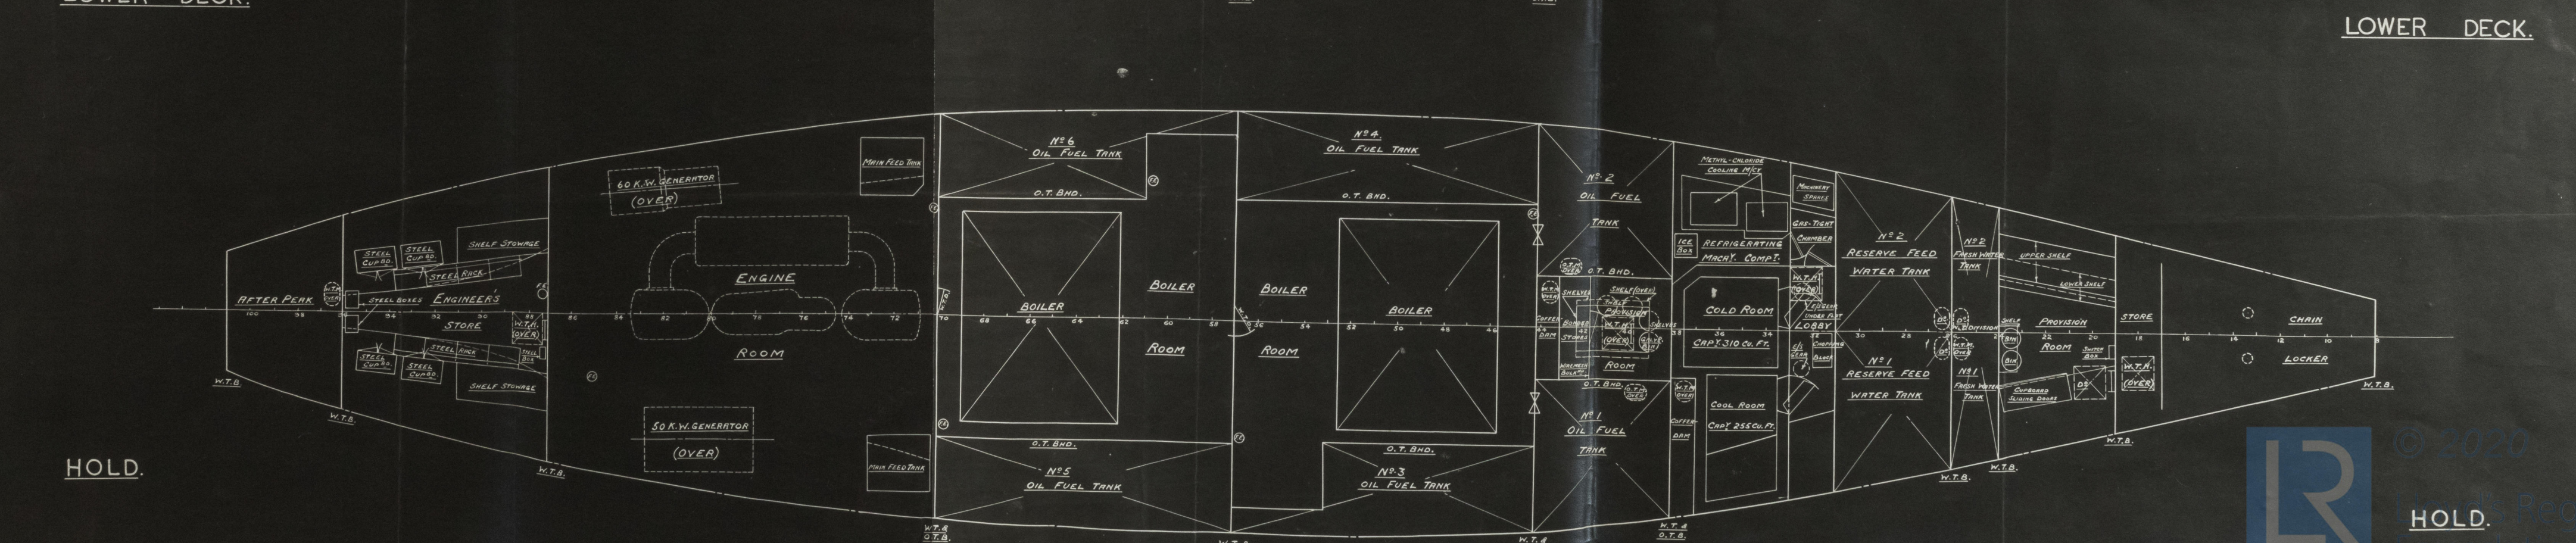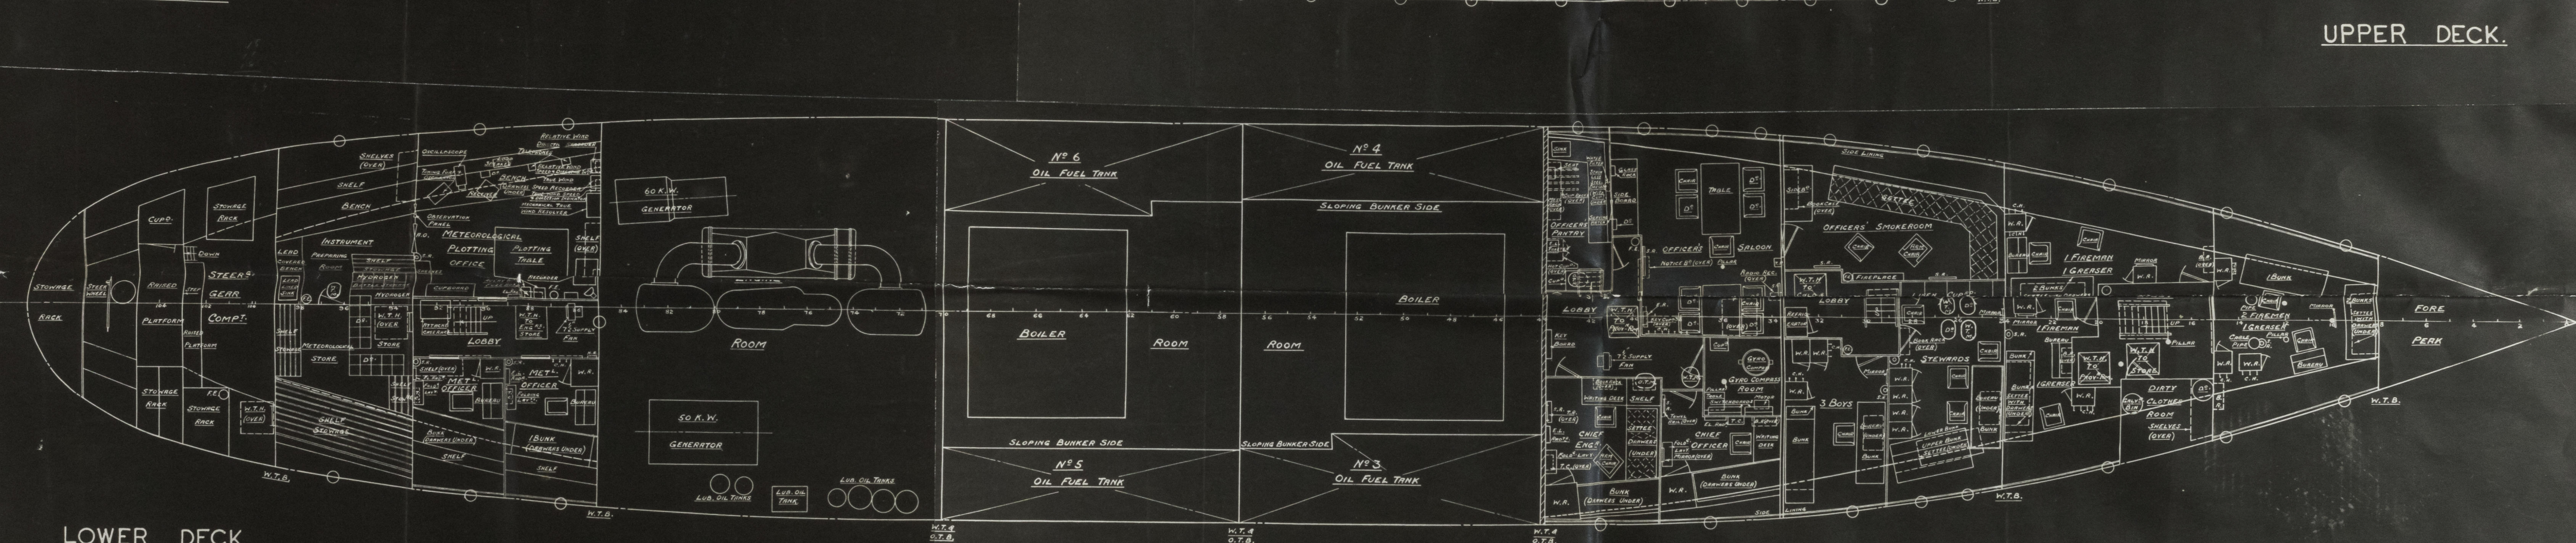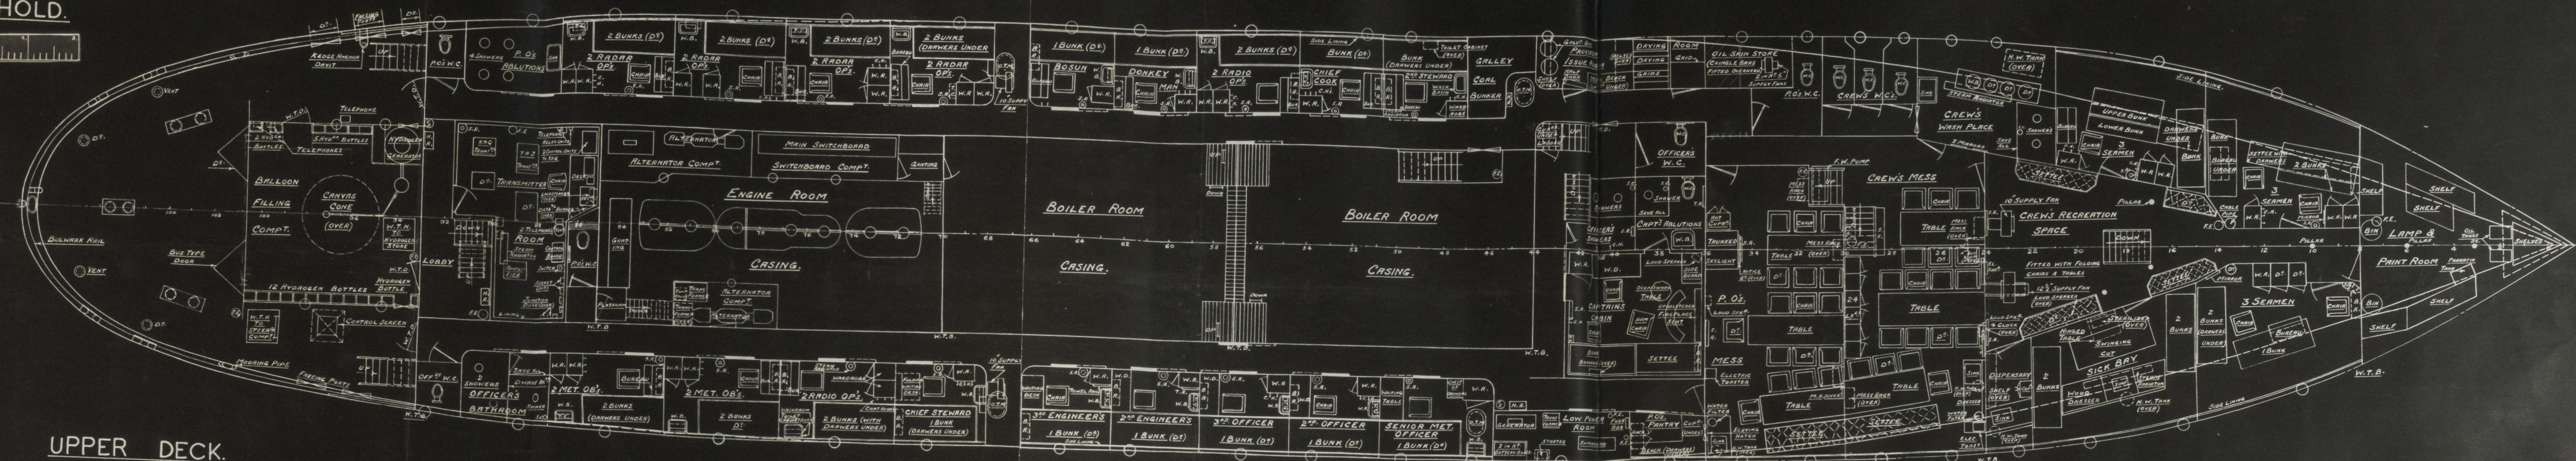

"Weather Observer"

General Arrangement (Upper & Lower decks & hold)
as fitted.

TO ACCOMPANY *Gannack* REPORT No. *24987*
DATED *October 1952*

003750-003762-0132

RETAIN



© 2020

Lloyd's Register
Foundation