


Lloyd's Register of Shipping.
SURVEYS FOR FREEBOARD.
(CONDITIONS OF ASSIGNMENT.)

117 OCT 1952

Ship's Name 'WEATHER OBSERVER' Port of Survey GLASGOW
Official Number ✓ Surveyor's Signature R. Lyle
Nationality and Port of Registry BRITISH Date of Survey DURING SPECIAL SURVEY

Disposition and dimensions of superstructures, trunks, deckhouses and machinery casings to be inserted in the diagrams and tabular statement:—

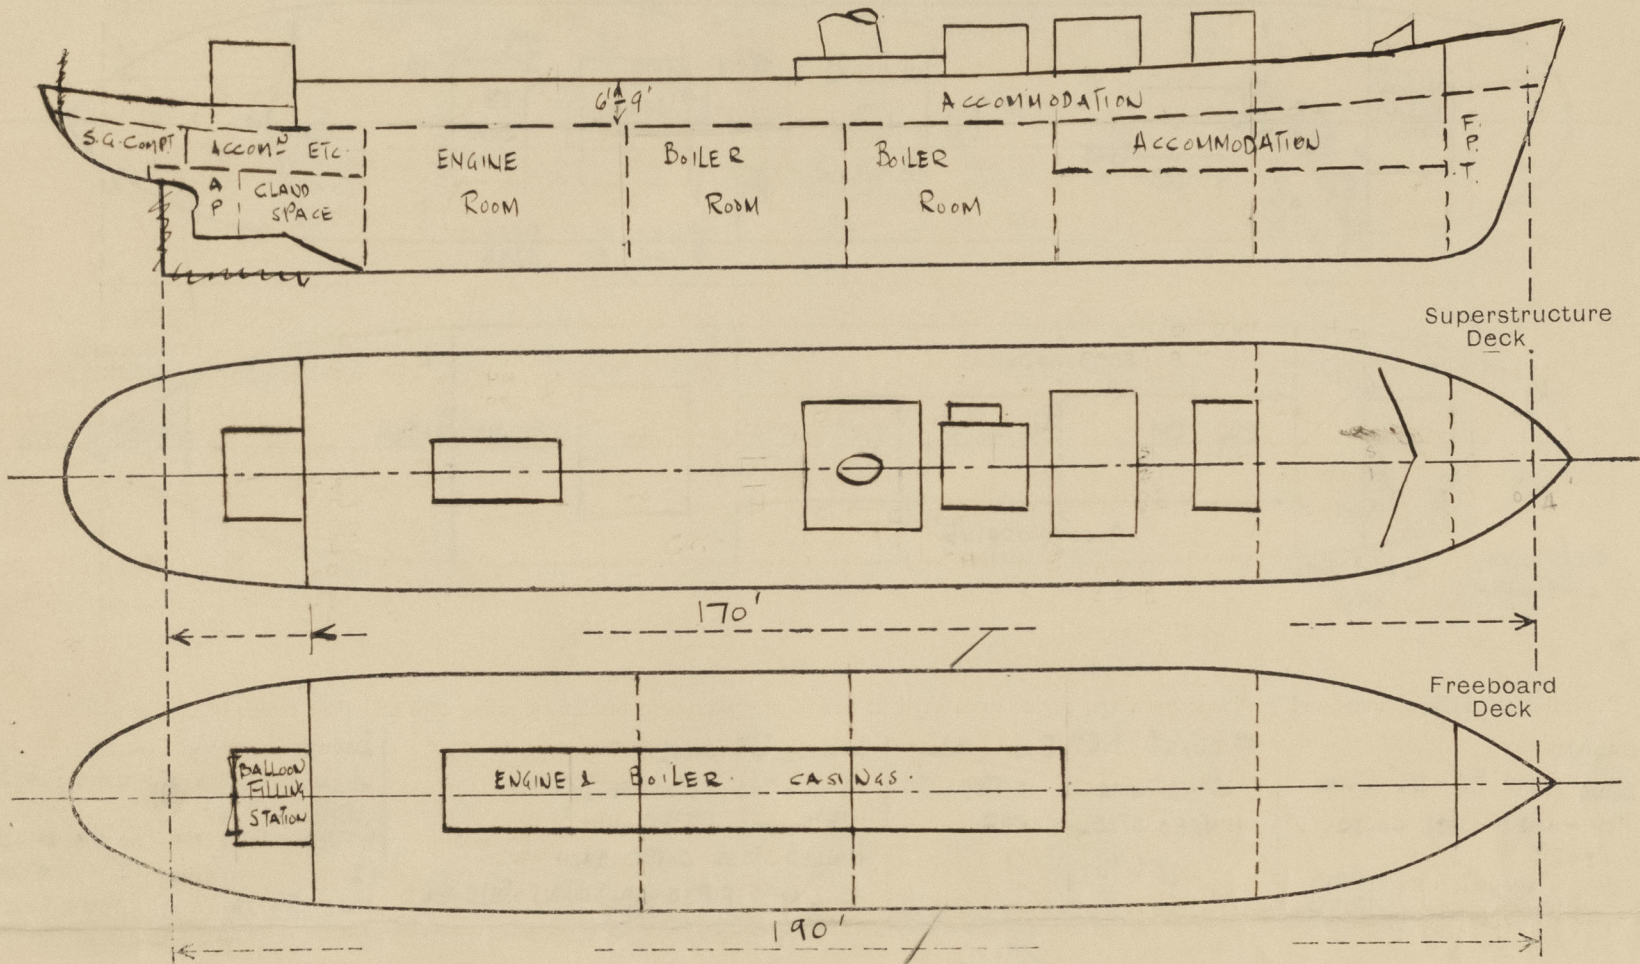

Particulars of Superstructures, Trunks, Casings, Deckhouses.

	Coaming	Plating	Stiffeners	Spacing	End Attachments of Stiffeners	Size of Openings	Height of Sills	Height of Casings
Poop Bulkhead								
Raised Quarter Deck Bulkhead ...								
Bridge, After Bulkhead								
Bridge, Forward Bulkhead								
COMBINED BRIDGE & Forecastle Bulkhead	25	25	3 x 3 x 25	24" 34"	SWIPED	2 @ 4'-3" x 2'-3" 1 @ 4'-6" x 2'-3"	21" 18"	6'-9"
Trunk, Aft								
Trunk, Forward								
Exposed Machinery Casings on Freeboard or Raised Quarter Decks ...	25	25	3 x 2 1/2 x 32	30"	BRACKETED AT TOP SIDES ONLY	✓	✓	3'-8"
Exposed Machinery Casings on Superstructure Decks								
Machinery Casings within Superstructures not fitted with Class I Closing Appliances								
Deckhouses on Flush Deck Ships ...								

Particulars of Closing Appliances (state if capable of being manipulated from both sides).

Poop Bulkhead	
Raised Quarter Deck Bulkhead ...	
Bridge, After Bulkhead	
Bridge, Forward Bulkhead	
COMBINED BRIDGE & Forecastle Bulkhead	HINGED STEEL W.T. DOORS SECURED BY 8 CLIPS, MANIPULATED BOTH SIDES.
Exposed Machinery Casings on Freeboard or Raised Quarter Decks ...	
Exposed Machinery Casings on Superstructure Decks	
Machinery Casings within Superstructures not fitted with Class I Closing Appliances	
Deckhouses on Flush Deck Ships ...	

PARTICULARS OF PROTECTION TO OPENINGS, ETC.

HATCHWAYS ON FREEBOARD AND SUPERSTRUCTURE DECKS.									
				UPPER DECK		FORECASTLE DECK			
Description of Hatchway				SG. COMP. HATCH	To ENGRS STORE	To FWD BOILER RM	To AFT BOILER RM		
Dimensions of Hatchway				30" x 30"	30" x 30"	18" x 16"	43" x 41"		
COAMINGS	{	Height above Deck ...	24"	24"	21"	24"			
		Thickness { Sides25	.25	.25	.25			
		Ends ...							
		Stiffeners ...							
Brackets, Stays ...				✓	✓	✓	✓		
HATCH BEAMS	{	Number ...							
		Spacing ...							
		Scantling and Sketch ...							
		Bearing Surface ...							
FORE AND AFTERS	{	Number ...							
		Spacing ...							
		Unsupported Lengths ...							
		Scantling* and Sketch ...							
Bearing Surface ...									
HATCH COVERS	{	Material ...	HINGED STEEL WATERTIGHT COVERS						
		Thickness ...	SECURED BY						
		How fitted ...							
		Bearing Surface ...	7 TOGGLES	7 TOGGLES	1 CLIP	7 CLIPS			
Spacing of Cleats ...				✓	✓	✓	✓		
Number of Tarpaulins...									
*Are wood fore and afters steel shod at all bearing surfaces ?									
Are battens and wedges efficient and in good condition ?									
Are tarpaulins in good condition and in accordance with rule requirements ?									
Are lashings provided in accordance with rule requirements ?									

Particulars of any special features :—

