

Lloyd's Register of Shipping.

(Report on Vessel No. _____ Port _____)

No. 2450 SHIP FORGINGS ~~OR CASTINGS~~.

I have to report that the undermentioned Iron ~~or Steel~~ Forgings ~~or Castings~~, manufactured by *J. Harnishall & Co. Ltd* of *Bundaberg* for the Vessel No. *599*, being built by *Walter Russell & Co. Ltd* of *Aberdeen* have been inspected by me as set forth below and found to be, so far as can be seen, *Satisfactory*.


Mark on Forgings or Castings.

Lloyd's

No. *528, H.**28/9/16 J.H.M.**John H. MacKirdy.**Bundaberg. 4. 10. 16.*

	STERN FRAME.	RUDDER FRAME.	STEM.
Material* ...	<i>Wrought Iron</i>		
How made ...	<i>Forged</i>		
Dimensions ...	<i>6 3/4 x 6" x 5"</i>		
Progress on Inspection ...	<i>Forge to finish.</i>		
Date when Inspected	<i>9/6 to 28/7 - 6 visits.</i>		
CASTINGS.			
Tests on Standard Test Pieces.			
Tensile Test—			
Tons per square inch ...	<i>✓</i>		
Extension per cent. ...	<i>✓</i>		
Cold Bending Test—			
Angle before fracture ...	<i>✓</i>		
Drop Test—			
Height from ground ...	<i>✓</i>		
Hammering Test—			
If made according to Rules and found satisfactory ...	<i>✓</i>		

SKETCHES OF FRAMES SHOWING POSITION AND DESCRIPTION OF WELDS OF FORGINGS.

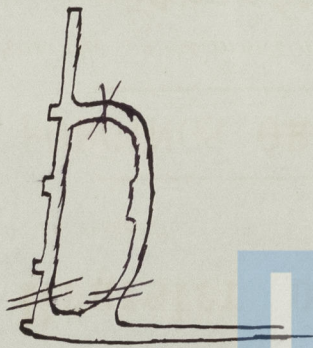

Fee (if any chargeable) £

To be paid at *✓*

* If of Iron, state whether scrap or puddled Iron. If of steel, state whether made on the Open Hearth process.

Gball Russell & Co. Ltd

No. 599.

Stern frame

S/s "Redhall"

Abn. I. & Rep. No. 11969.

© 2020

Lloyd's Register
Foundation

003763-003768-0018