

LLOYD'S REGISTER OF SHIPPING

UNITED WITH THE BRITISH CORPORATION REGISTER

ALTERATIONS TO CONDITIONS OF ASSIGNMENT OF LOADLINES

Ship's Name *S/S REDHALL*

Official No. *139800*

Port of Registry *ABERDEEN*


This ship has been under survey at *ABERDEEN*

on *13TH FEBRUARY 1956*. *195* and the following alterations to the conditions of

assignment of loadlines have now been effected/~~found~~:-

*Access to holds now arranged by ladders between No. 1-2 cargo
ladders and No. 3-4 cargo ladders.*

*Coamings 3'-6" x 2'-0" x 24" high 40 thick fitted with 3" steel
wood cores, 2 tarpaulins, rest angles cleats battens and
wedges in accordance with Rule Requirements.*

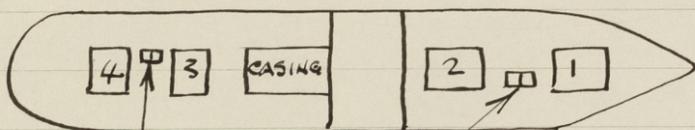

ADDITIONAL ACCESS
HATCHES.

MacLellan

7/11
11.4.56

A copy of this Report has been placed on board.

