

17 FEB 1956

LLOYD'S REGISTER OF SHIPPING


UNITED WITH THE BRITISH CORPORATION REGISTER

Report. 23935.


ALTERATIONS TO CONDITIONS OF ASSIGNMENT OF LOADLINES

Ship's Name 5/6. REDHALL.Official No. 139800Port of Registry ABERDEEN.This ship has been under survey at ABERDEEN.on 13TH FEB 1956.195 and the following alterations to the conditions ofassignment of loadlines have now been effected/~~found~~:-

Access to holds now arranged by means of ladders between
 Nos 1 & 2 Cargo ladders and Nos 3 & 4 Cargo ladders
 Ladders 3'-6" x 2'-0" x 24" high. 40 thick fitted with 3" thick
 wood covers. 2 tarpaulins, rest angles, cleats, battens and
 wedges in accordance with Rule Requirements.

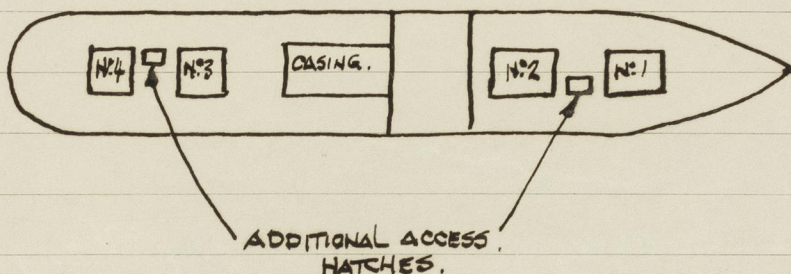

D. J. Macdonald.

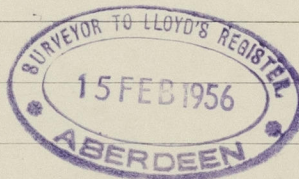

24
24.2.56.

A copy of this Report has been placed on board.



© 2020

Lloyd's Register
Foundation

003763-003768-0034