


18 SEP 1947

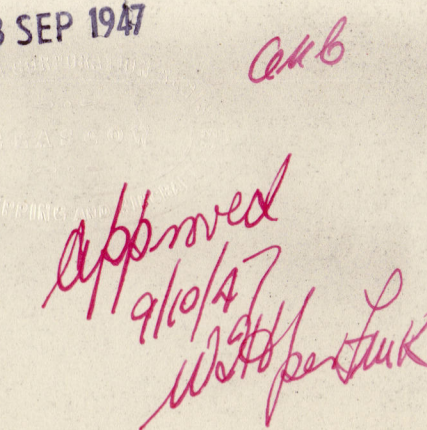


ex. L. C. T. 8. M/s Aitanga

Dimensions :

$$3 \times 1.5 \times .86 = 2.0$$

see cable part 16 p 47
regarding foot dish scattering
foot dish flating made .20, existing beams
retained. House ribs and ceiling
stiffness spaced 36" and house
rib flating made .25"

Hatch covers 2 1/2" Pine
protected at ends by
galvanised steel band

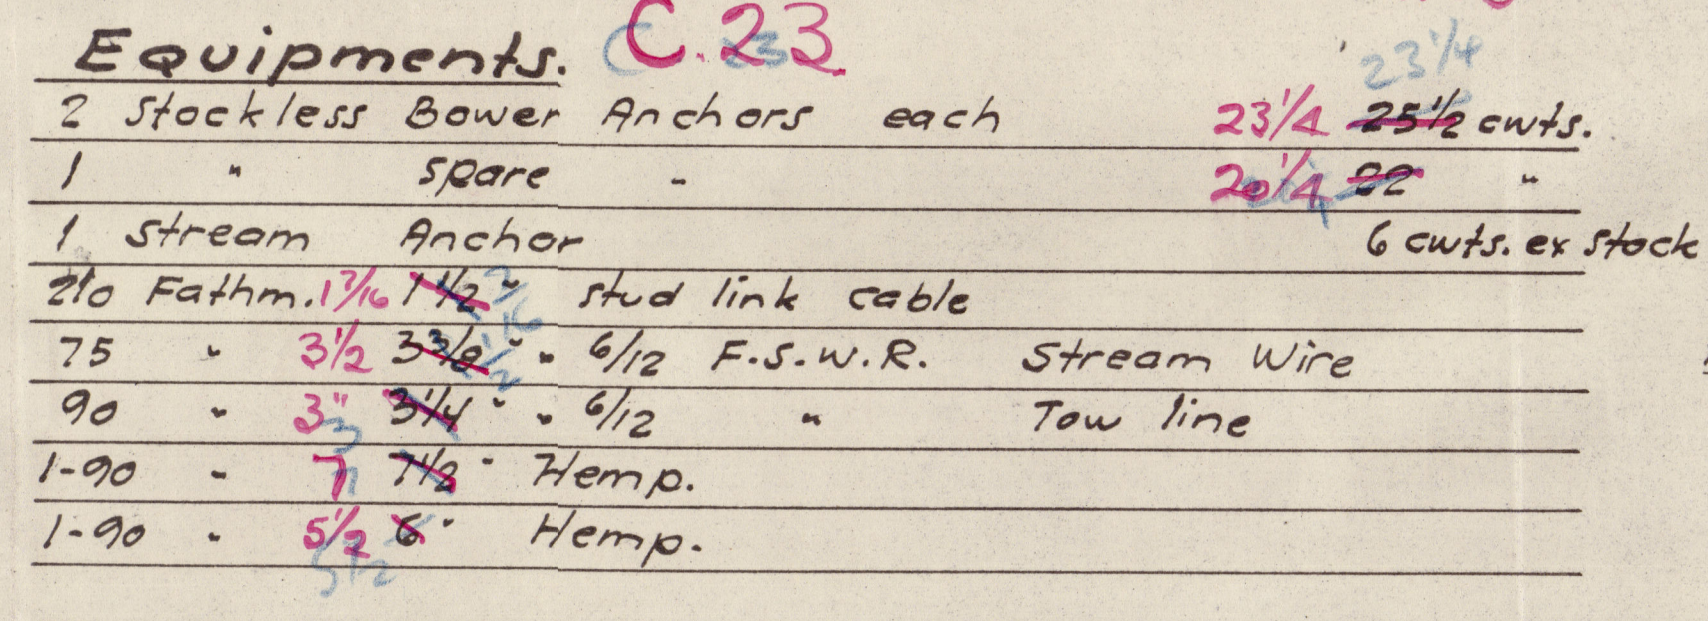

Engine Room

Midship Section I

KNUD E. HANSEN

Consulting naval architect
Rosenvængets Allé 22 - Copenhagen Ø.

C. 6442, Trin 1645, Telegr. Adr. DESIGN.

18 SEP 1971

KEN H778 E

A.E.H. 4779-3

003763-003768-0141

RECORDS DEPT
LONDON

TRANSFERRED TO
L. R. SYSTEM

3

Midship Section (Sheet 1)

L. E. Hansen.

S/m AITANGA L.C.T(8) 4026.

2.10.47.

N/A

'RIO ESCONDIDO'

+

1945

Borg

18 SEP 1947

S/m Aitanga or L.C.T(8) 4026.

T

Midship Section (Sheet 1)



© 2020

Lloyd's Register
Foundation