


AD 2361

20 JUL 1943

BUILDERS No 620. FAIRFIELD



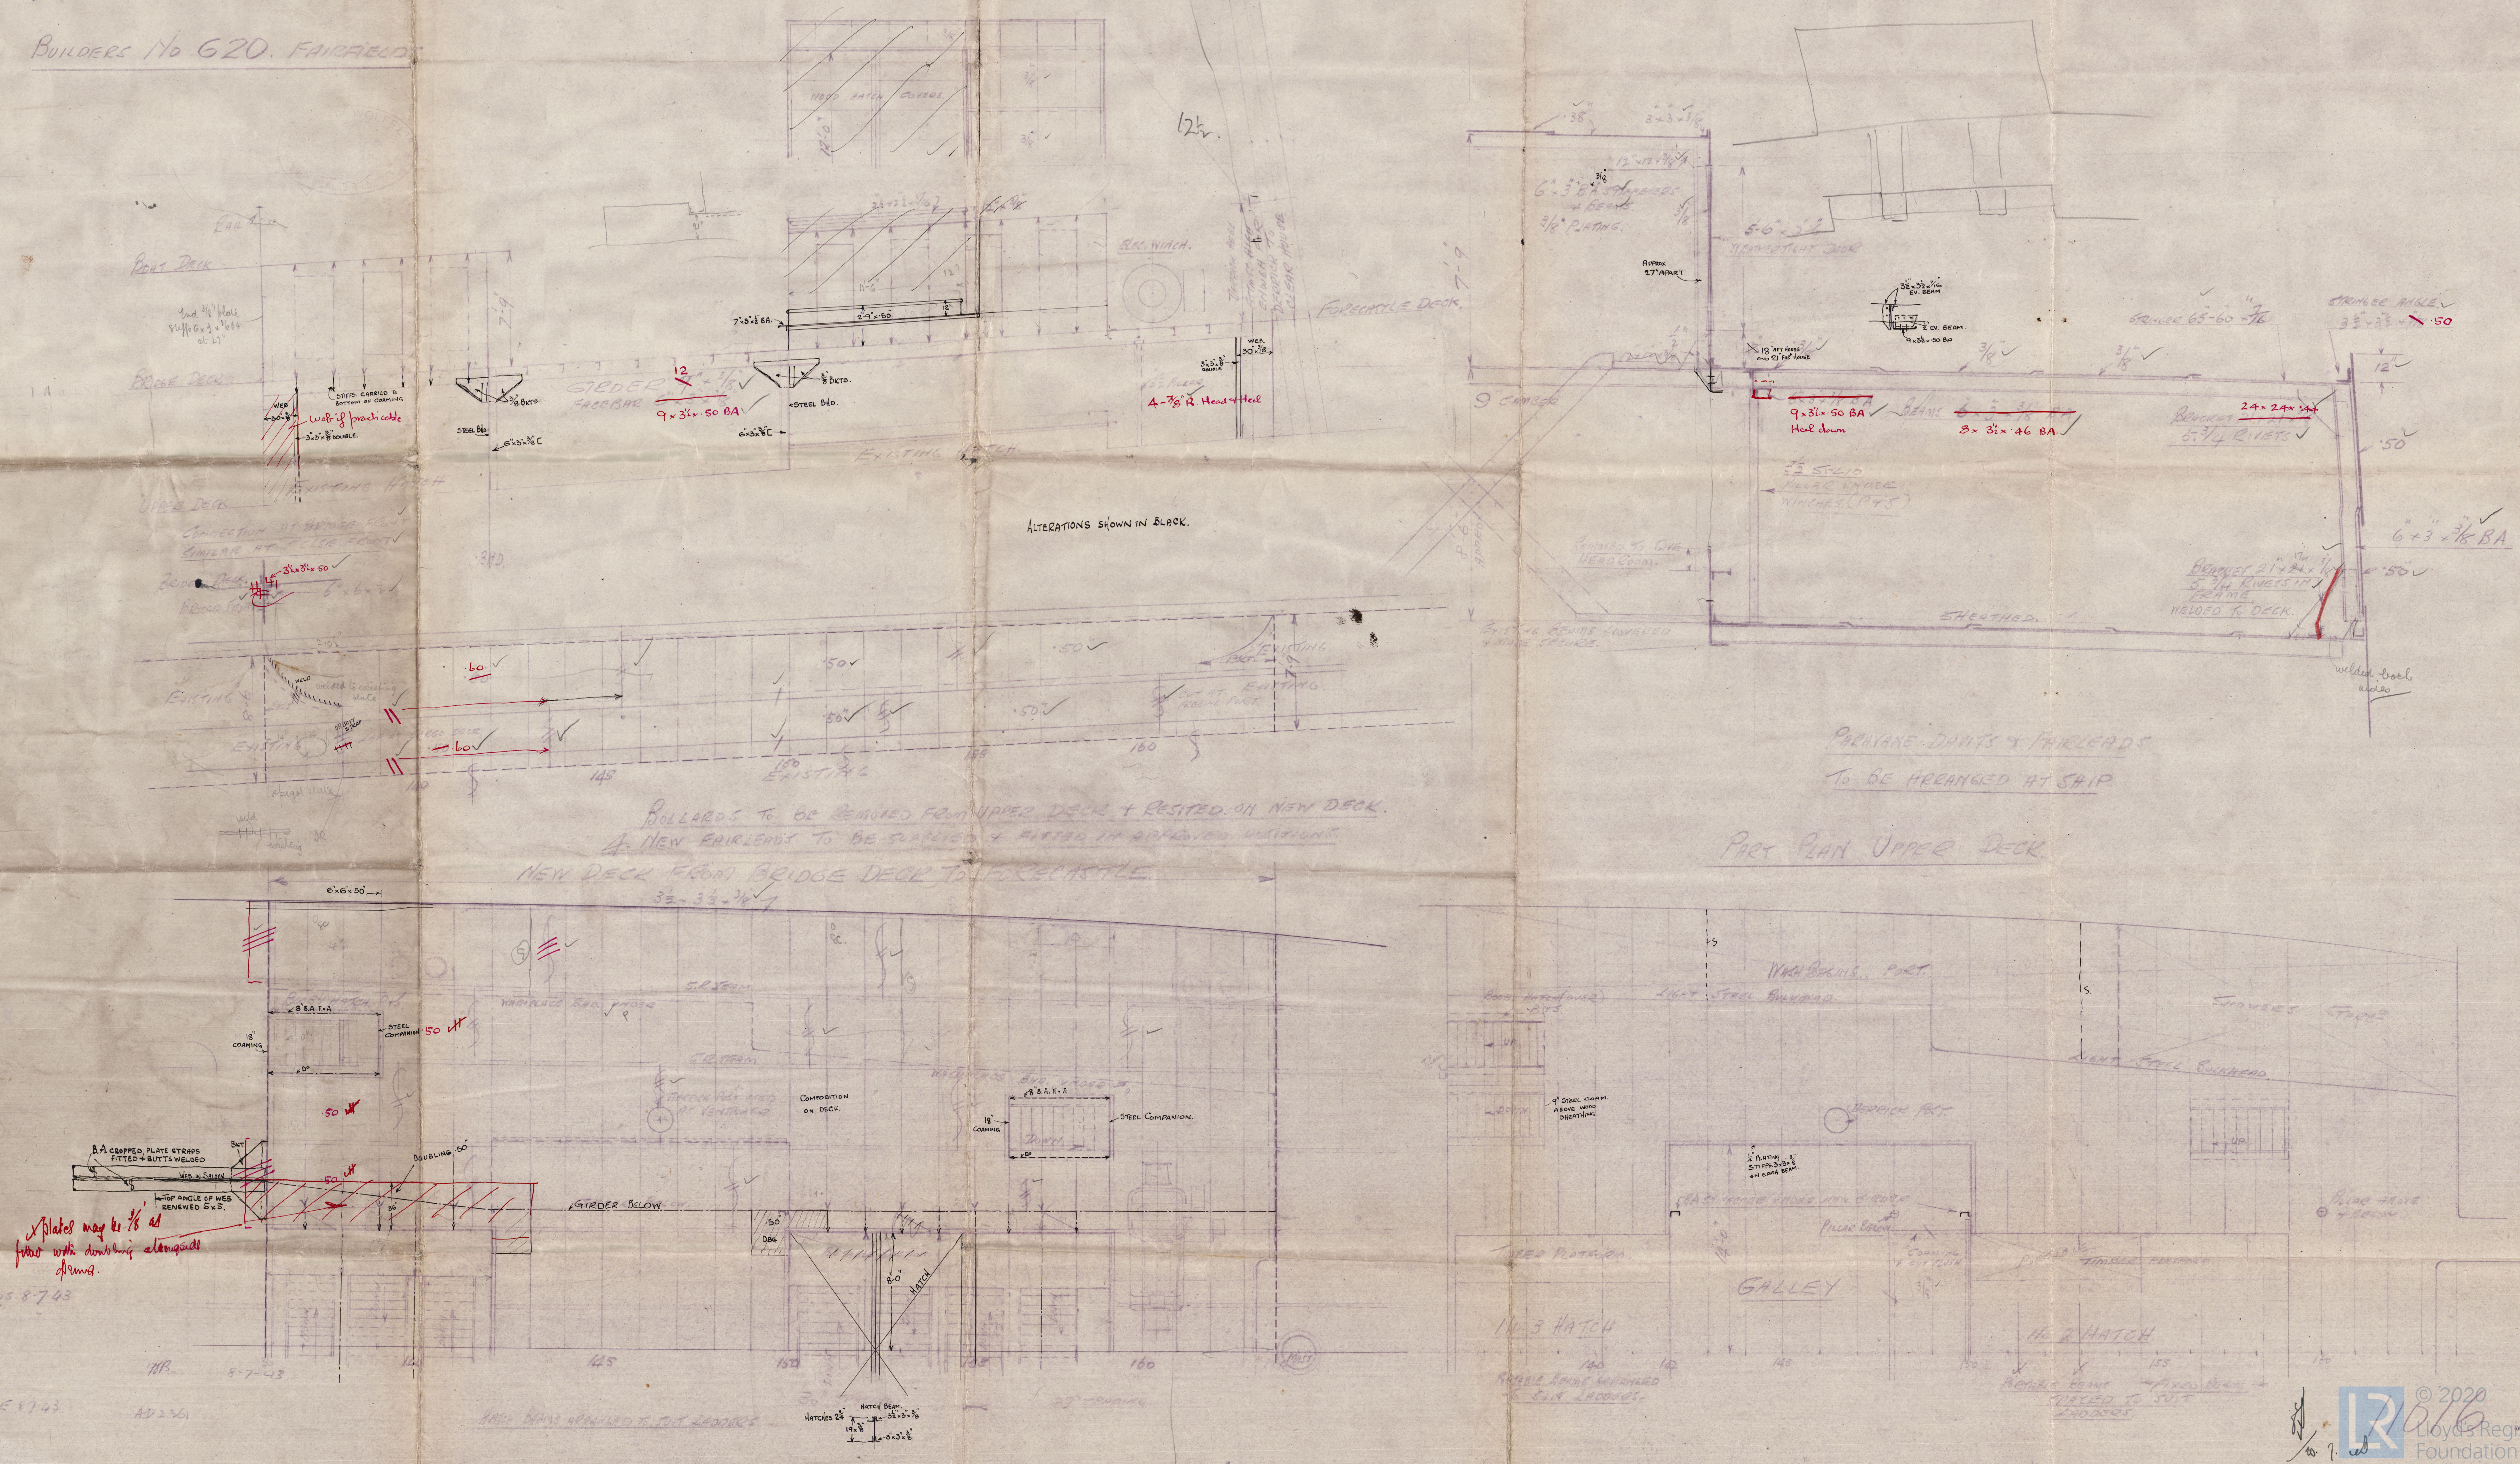

M/W "CHESHIRE"

- RPT No 111967. Jan.

Proposed weather shade deck.

003769-003777-0003



© 2020

Lloyd's Register  
Foundation