



No 123. (NORTHERN STEAMER)
 GENERAL ARRANGEMENT.
 T.S. PASSENGER & CARGO STEAMER.
 BOAT, PROMENADE & UPPER DECKS.
 Dims. 218'0" x 37'0" x 13'6" M.L.P.
 Scale: 1/8" = 1 Foot.

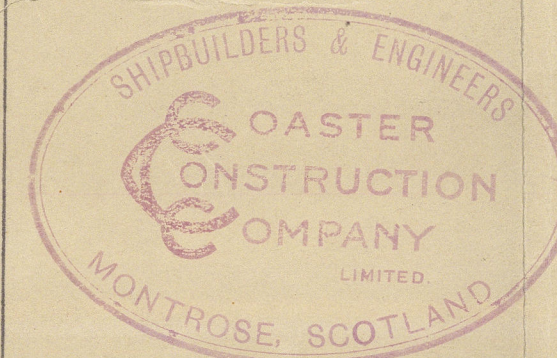

5 AUG 1924

6 AUG 1924

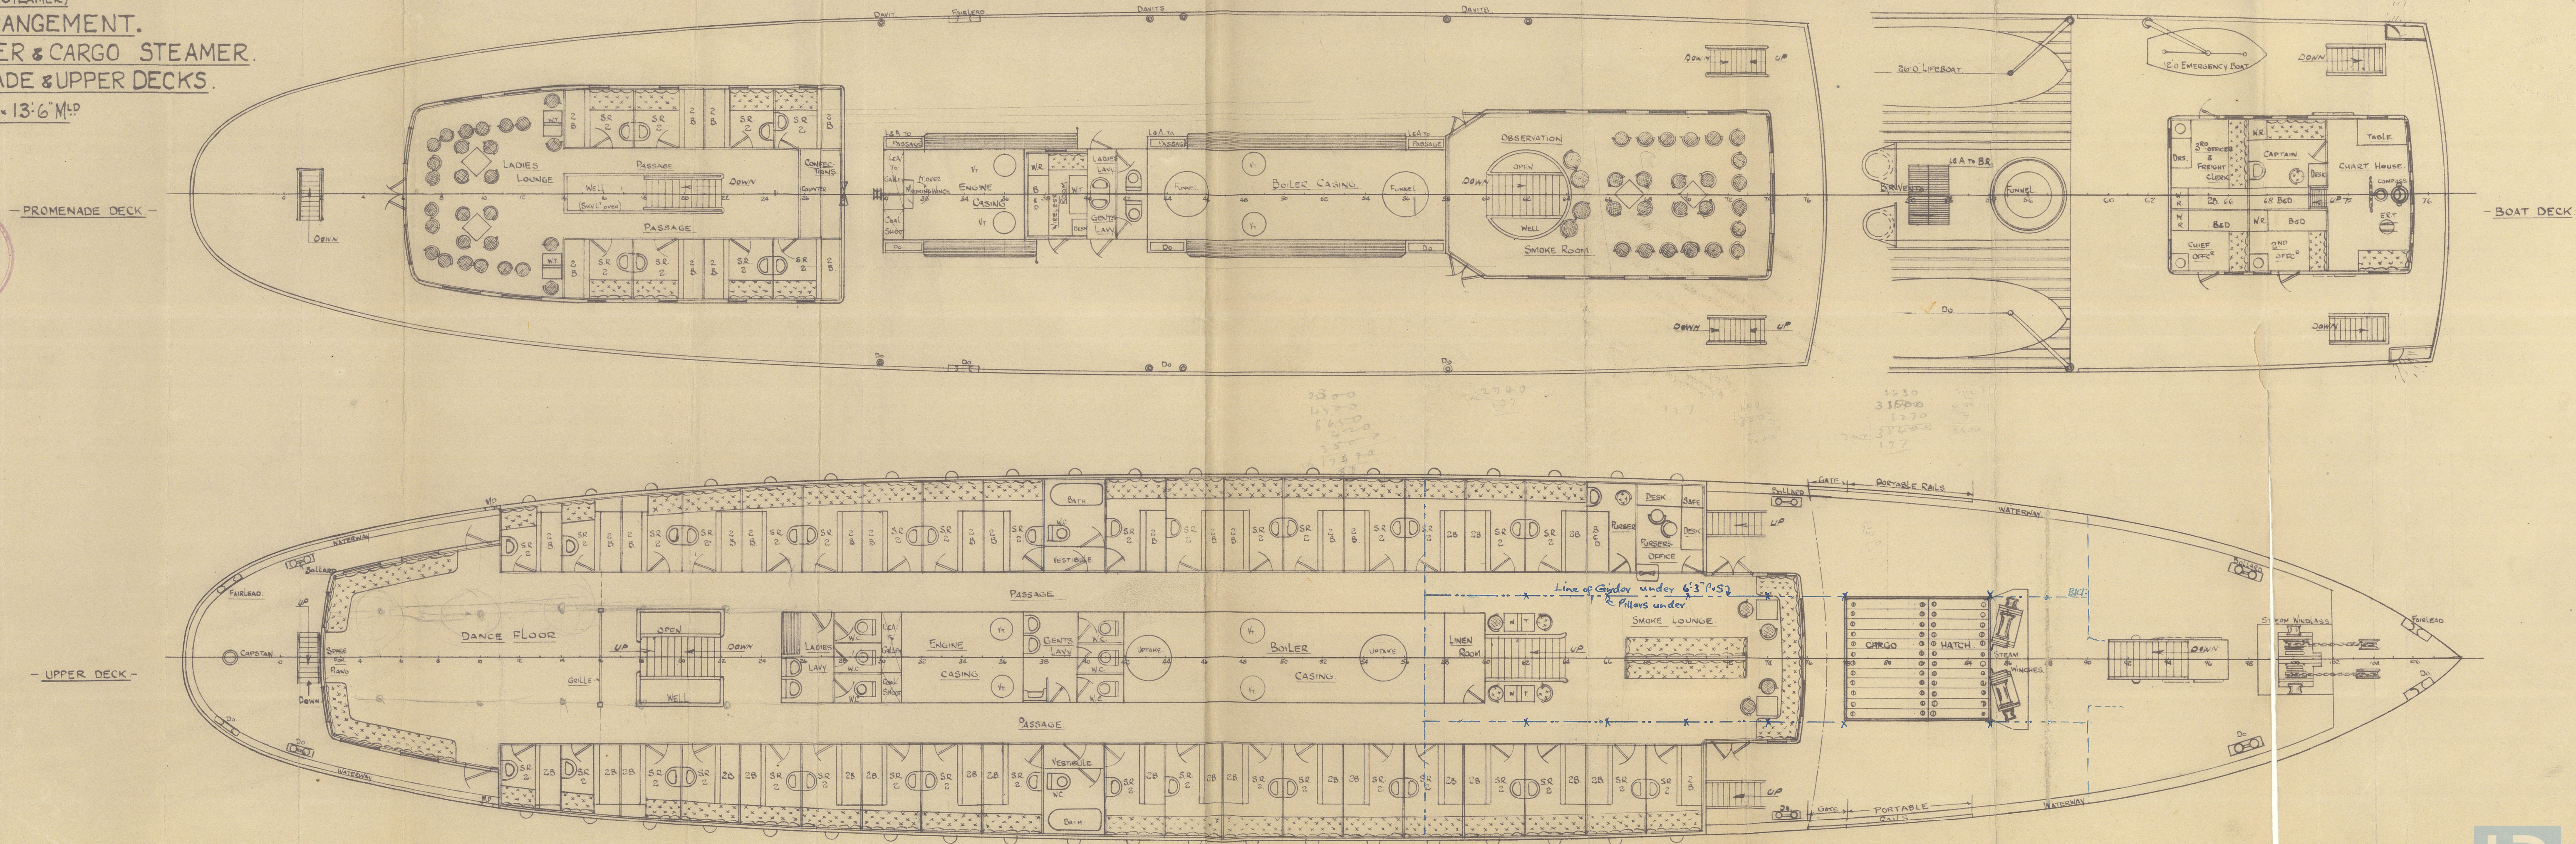

Coaster Const Co

123

Gent. Arty.

Prom to upper dk.

Bag.

T.C. 19/11/24

Coaster Construct. Coy.

123

Upper, Promenade, & Boat Decks

2 (6)

003712 003787-0 0282



© 2021

Lloyd's Register
Foundation