


No 123. (NORTHERN STEAMER.)
 GENERAL ARRANGEMENT.
 T.S. PASSENGER & CARGO STEAMER.
 PROFILE.
 DIMS. 218'0" x 37'0" x 13'6" MLD.
 SCALE: 1/8" = 1 FOOT.



- 5 AUG 1924

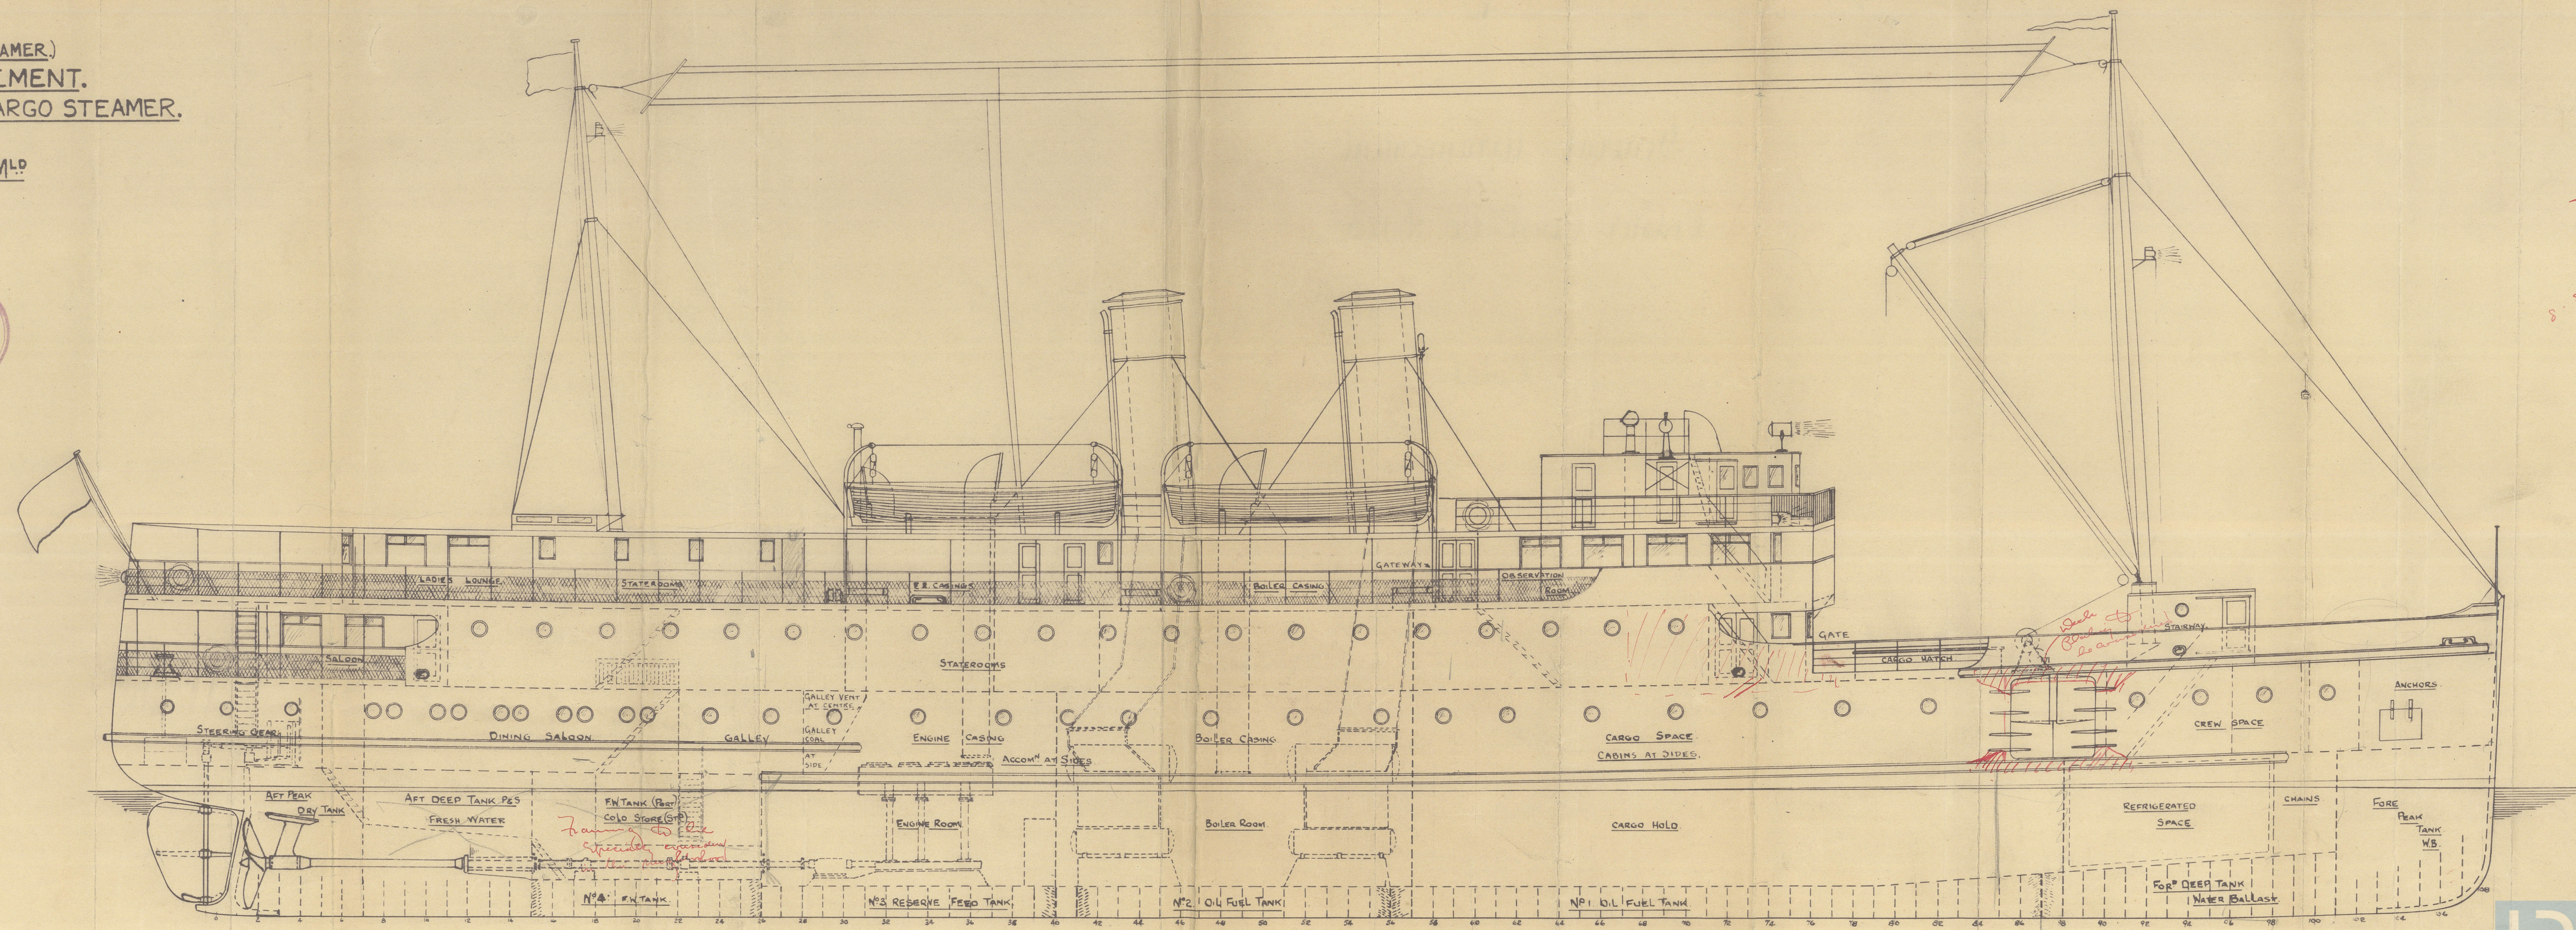

8 AUG.

2

General Arrangement.

Coaster Const^m Co. N^o 123.

8-8-24.

Sl. 10/11/24.

"Batala"



© 2021

Lloyd's Register
Foundation


8200-788300-824300

Coaster Construct Co

123

Gen. Argt Profile

Bag
Rydder

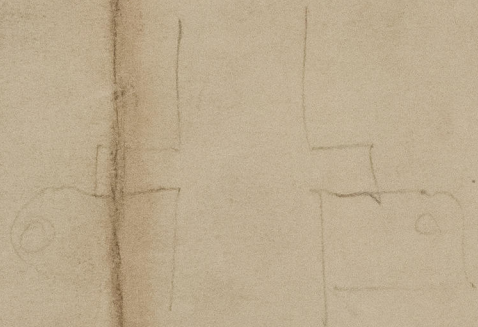

T.C. 19/11/24

Coaster Construct. Coy

123

Profile

2 (a)

003778-003787-0028



© 2021

Lloyd's Register
Foundation