

MIDSHIP SECTION

EQUIPMENT.

1. STOCKLESS ANCHOR $8\frac{1}{4}$ CWTs.
1. " " $7\frac{1}{2}$ "
1. RODGERS " $3\frac{1}{4}$ " EX. STOCK.
- 120 FMS OF $1\frac{1}{8}$ " STUD LINK CABLE.
- 60 " " 6" HAWSER.
- 60 " " 5" WARP.

Nº 488 - "KINGSTON Onyx"

DIMENSIONS:- 140'-0" BP x 24'-0" EX. x 13'-9" MLD.

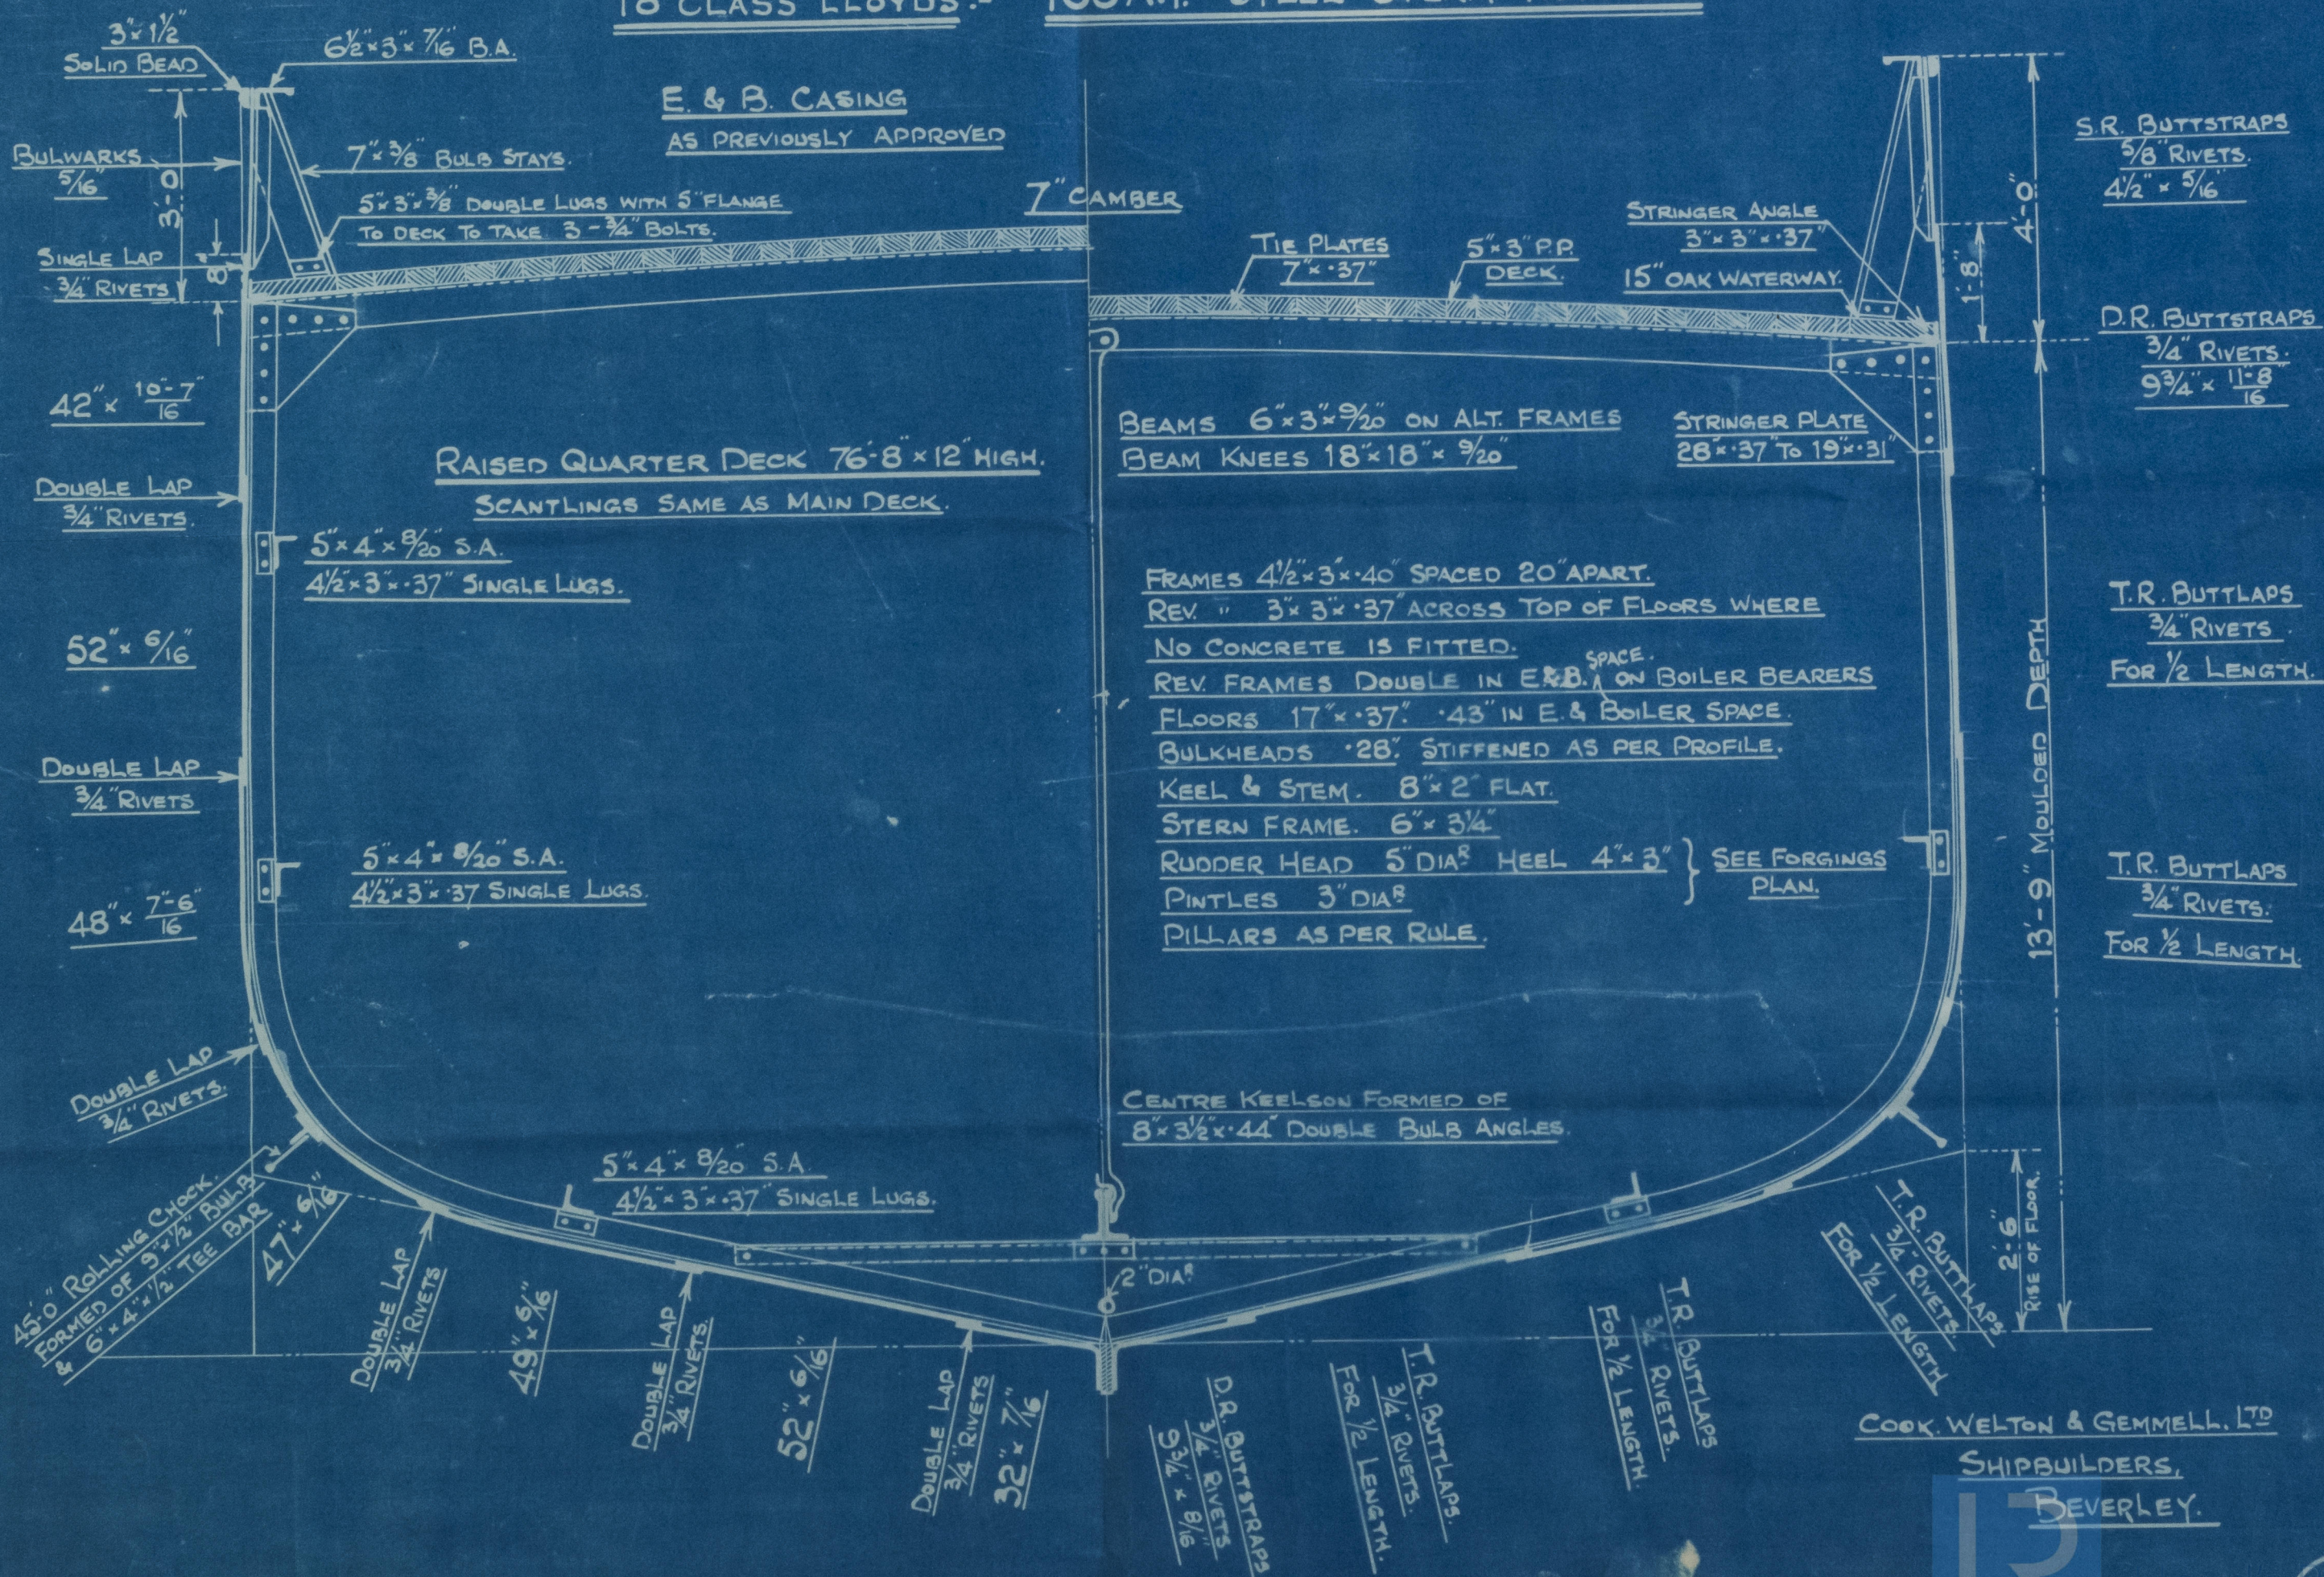
SCALE $\frac{1}{2}" = 1 \text{ FOOT.}$

TO CLASS LLOYDS:- 100A.1. STEEL STEAM TRAWLERS.

LLOYDS NUMBERS

$$\begin{array}{rcl} L \times D & = & 1925.00 \\ \underline{D} & = & 13.75 \\ L \times (B+D) & = & 5266.80 \\ \underline{B+D} & = & 37.62 \end{array}$$

PROPORTIONS

$$\begin{array}{rcl} L/D & = & 10.18 \\ L/B & = & 6.8 \\ d & = & 12.33 \end{array}$$


COOK, WELTON & GEMMELL, LTD
SHIPBUILDERS,
BEVERLEY.

WESTHOPE

Book ¹⁸⁸ Welton + Hummell

Midships Section
(eds built)

N^o 188

⁵⁷
"Kingston Onyx"

Shull F. E. Report 38267.



Lloyd's Register
Foundation

003778-003787-0122