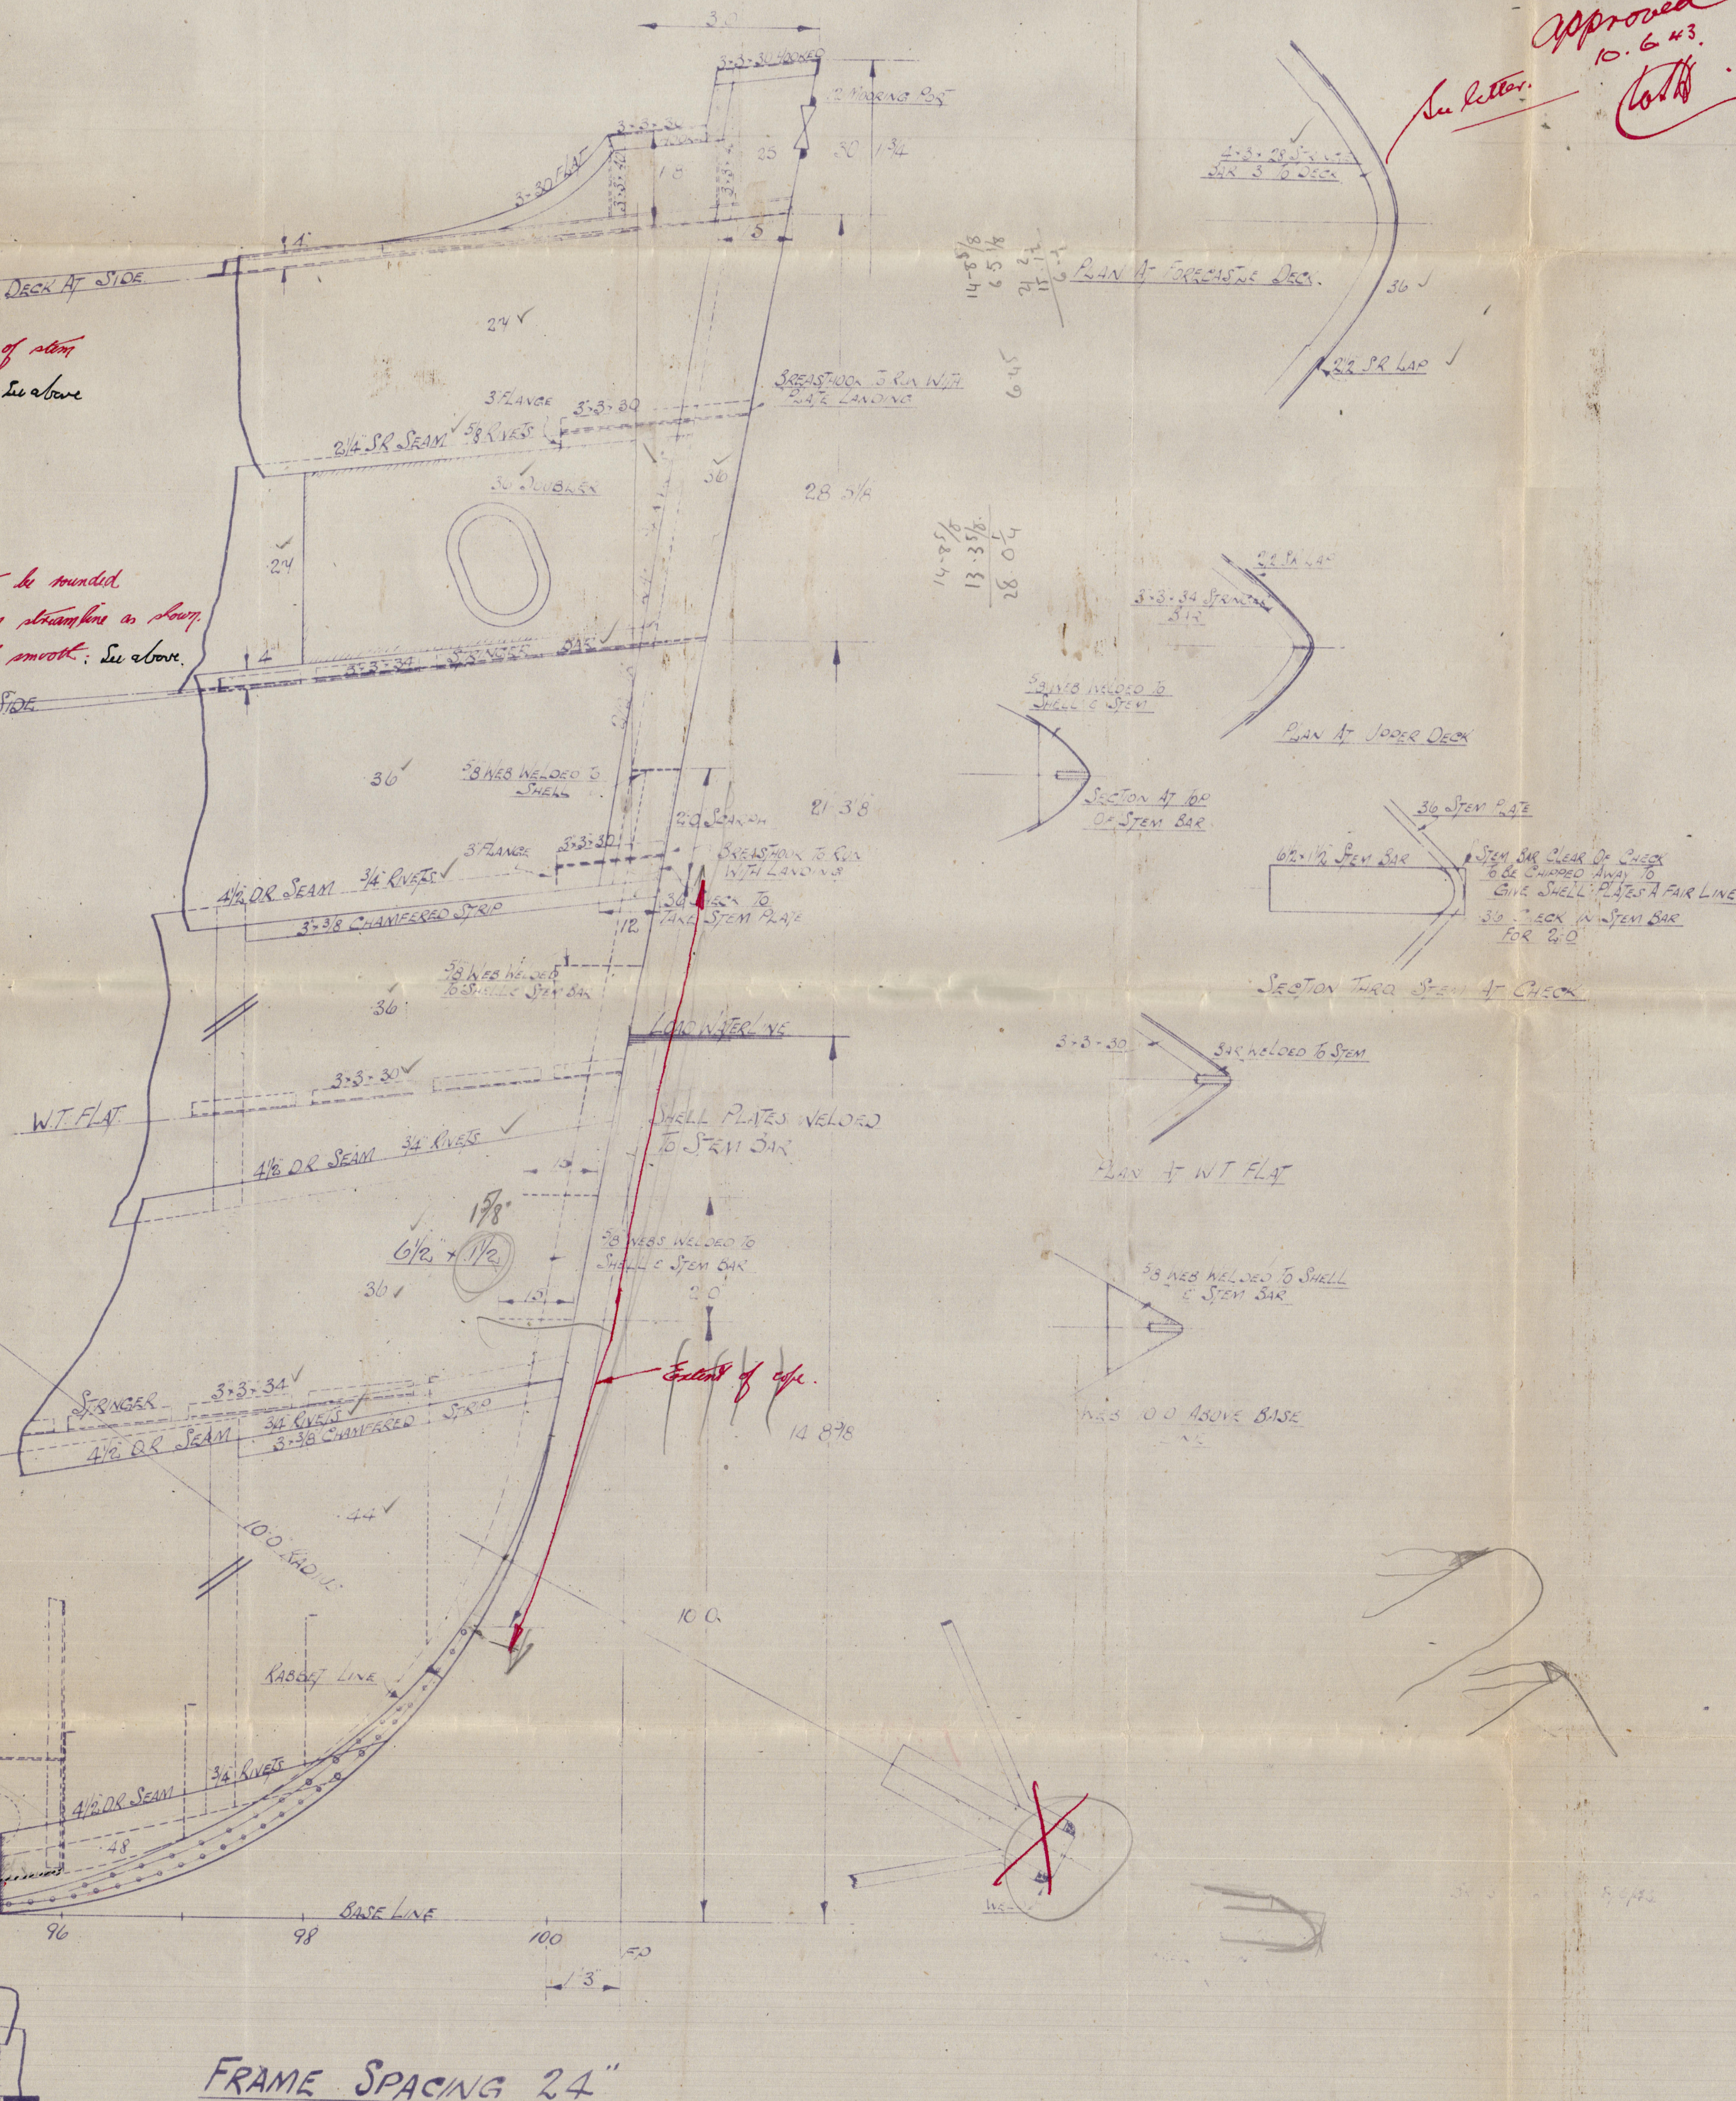
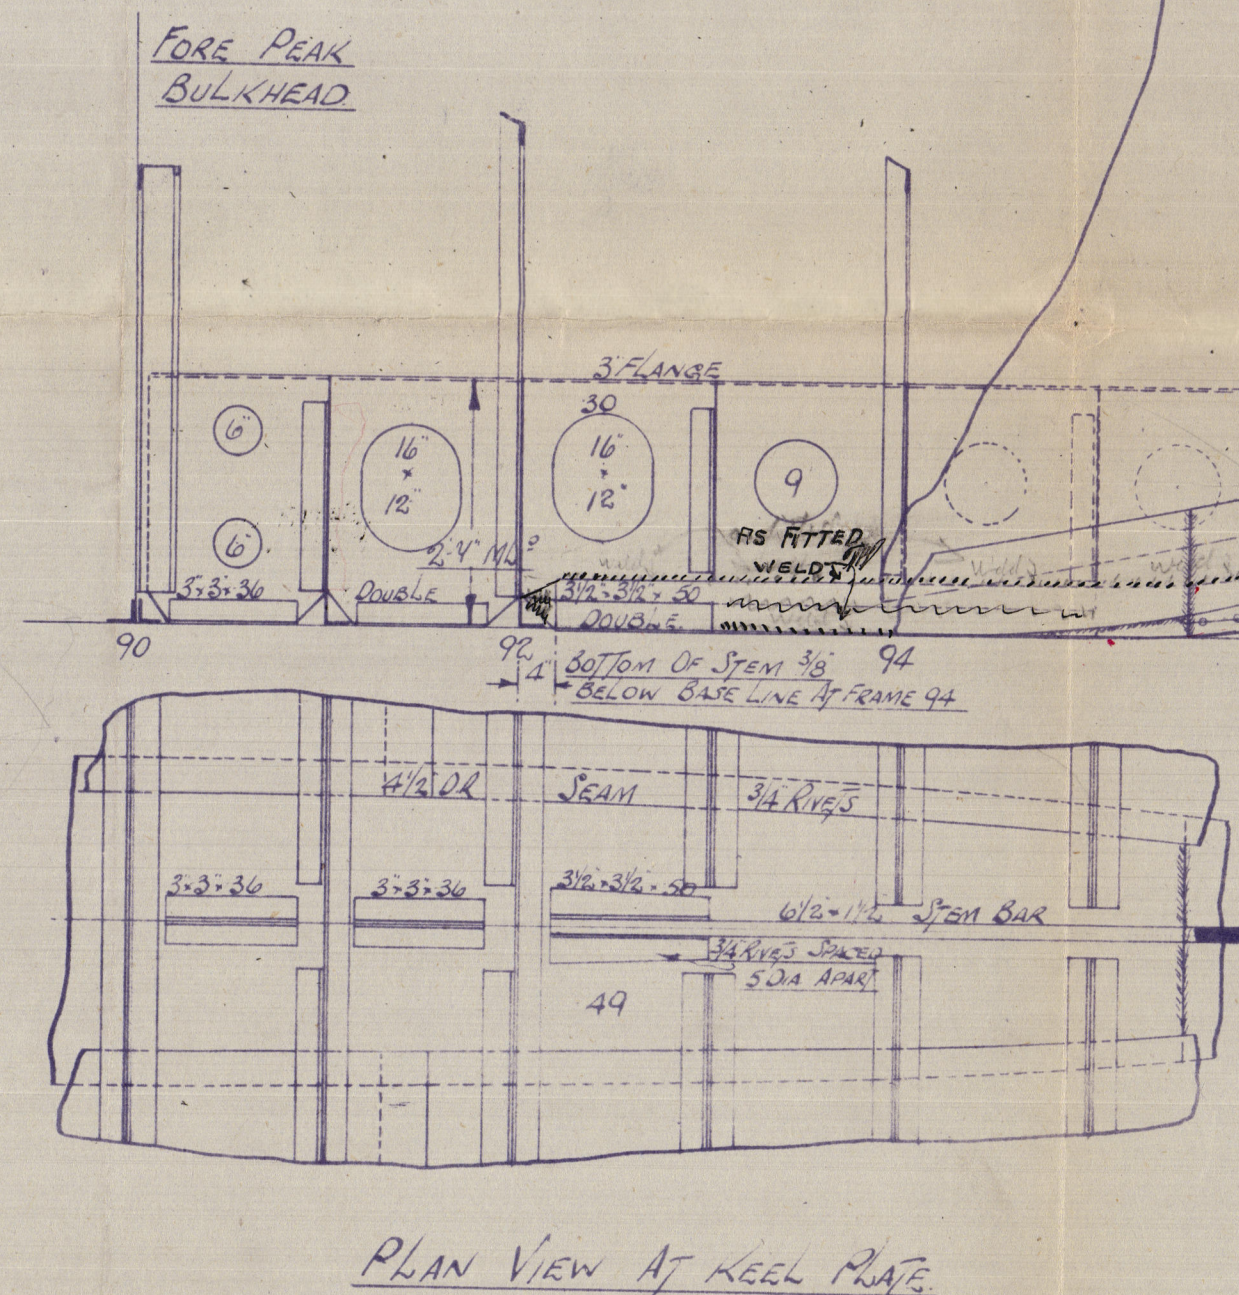
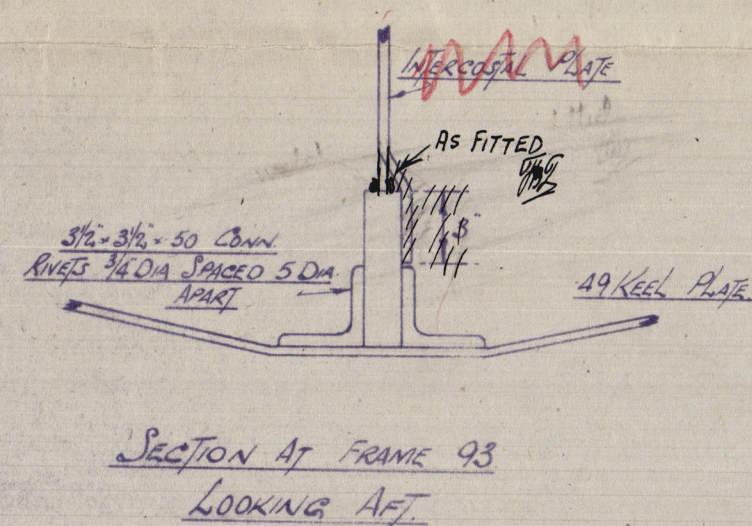
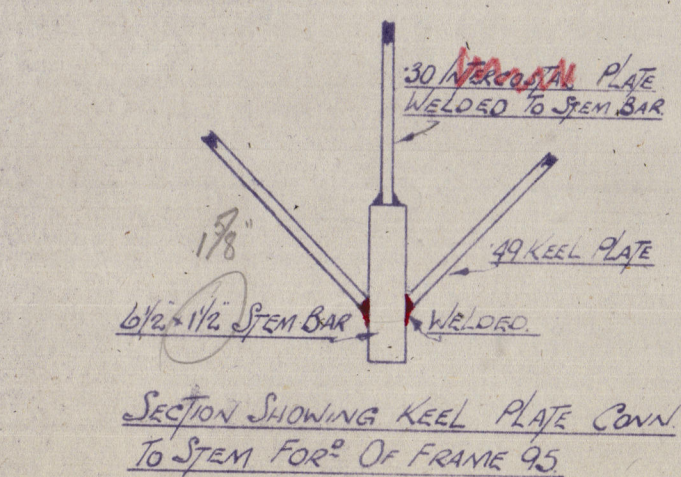
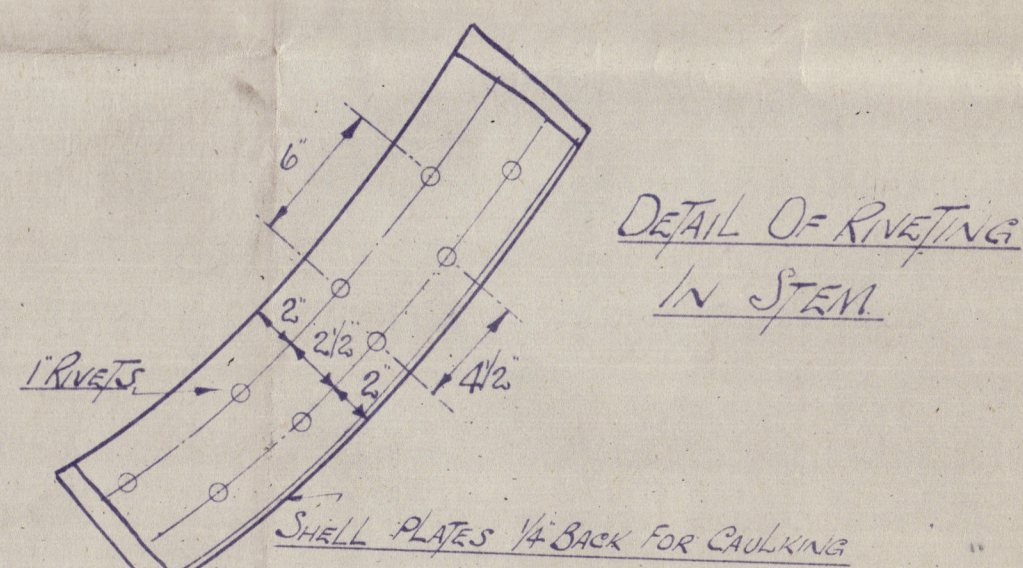
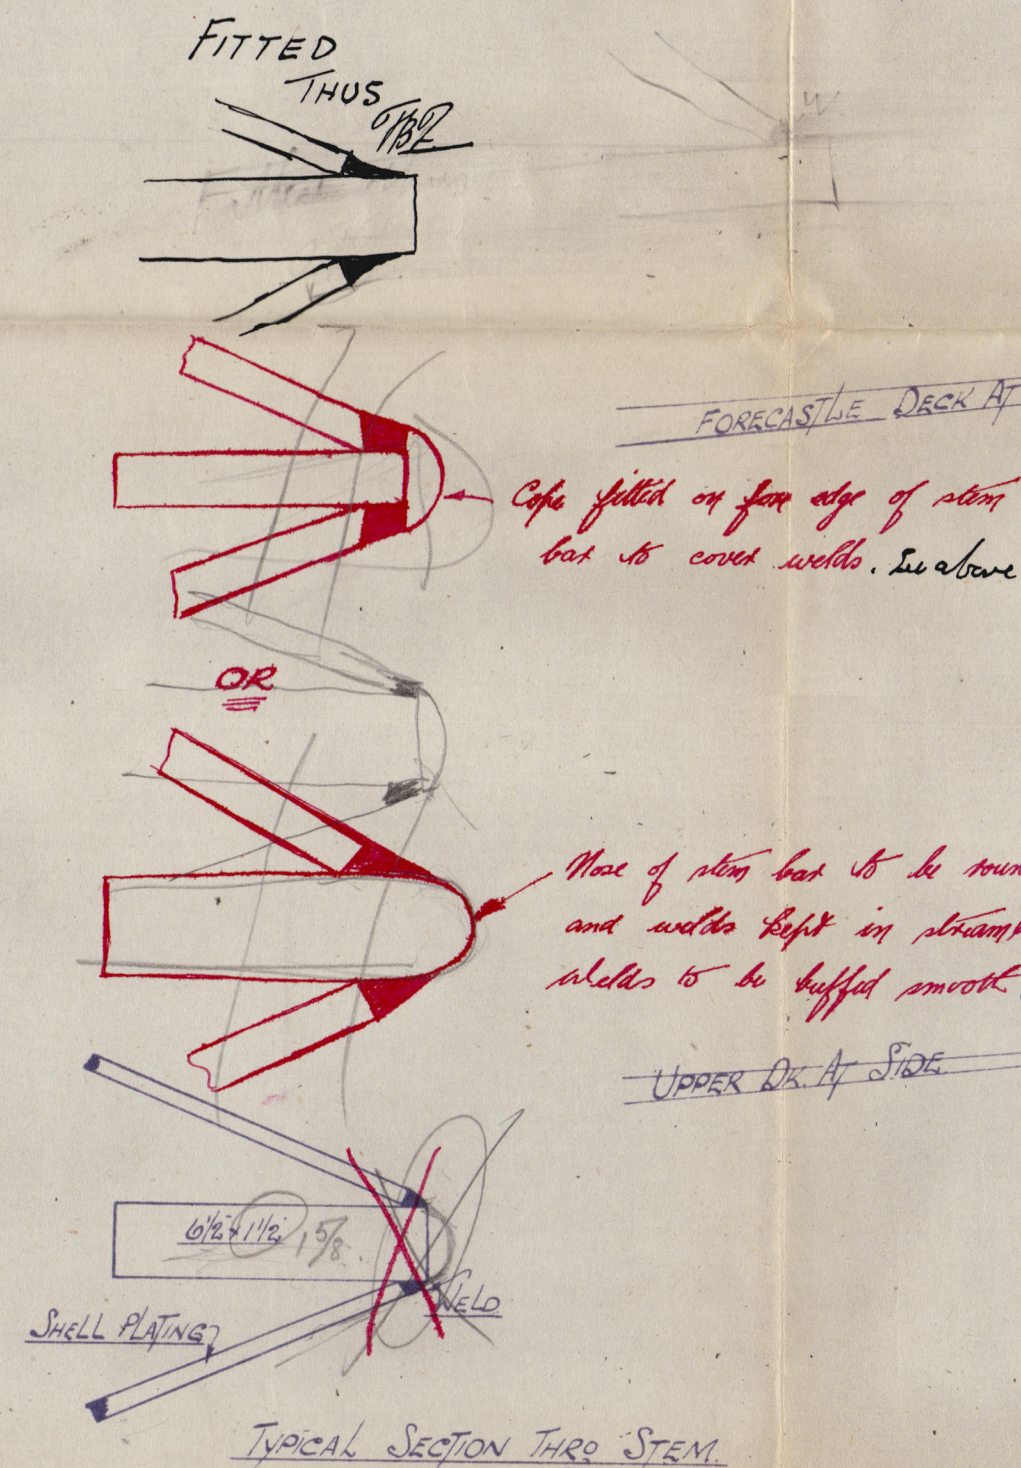


SCALE: $\frac{1}{2}$ " & $1\frac{1}{2}$ " = 1 FOOT

9 JUN 1943


[illegible]

003788 - 003799 - 0175

19

Stem

Ardrassan Bha

N^o 297-8.


10.6.42

NORMAN QUEEN.

Ba.

9 JUN 1943

Ardrassan Bha

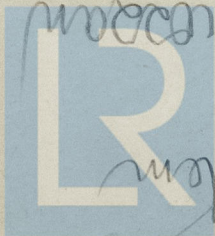

Lloyd's Register
Foundation

8210-64500-881500